



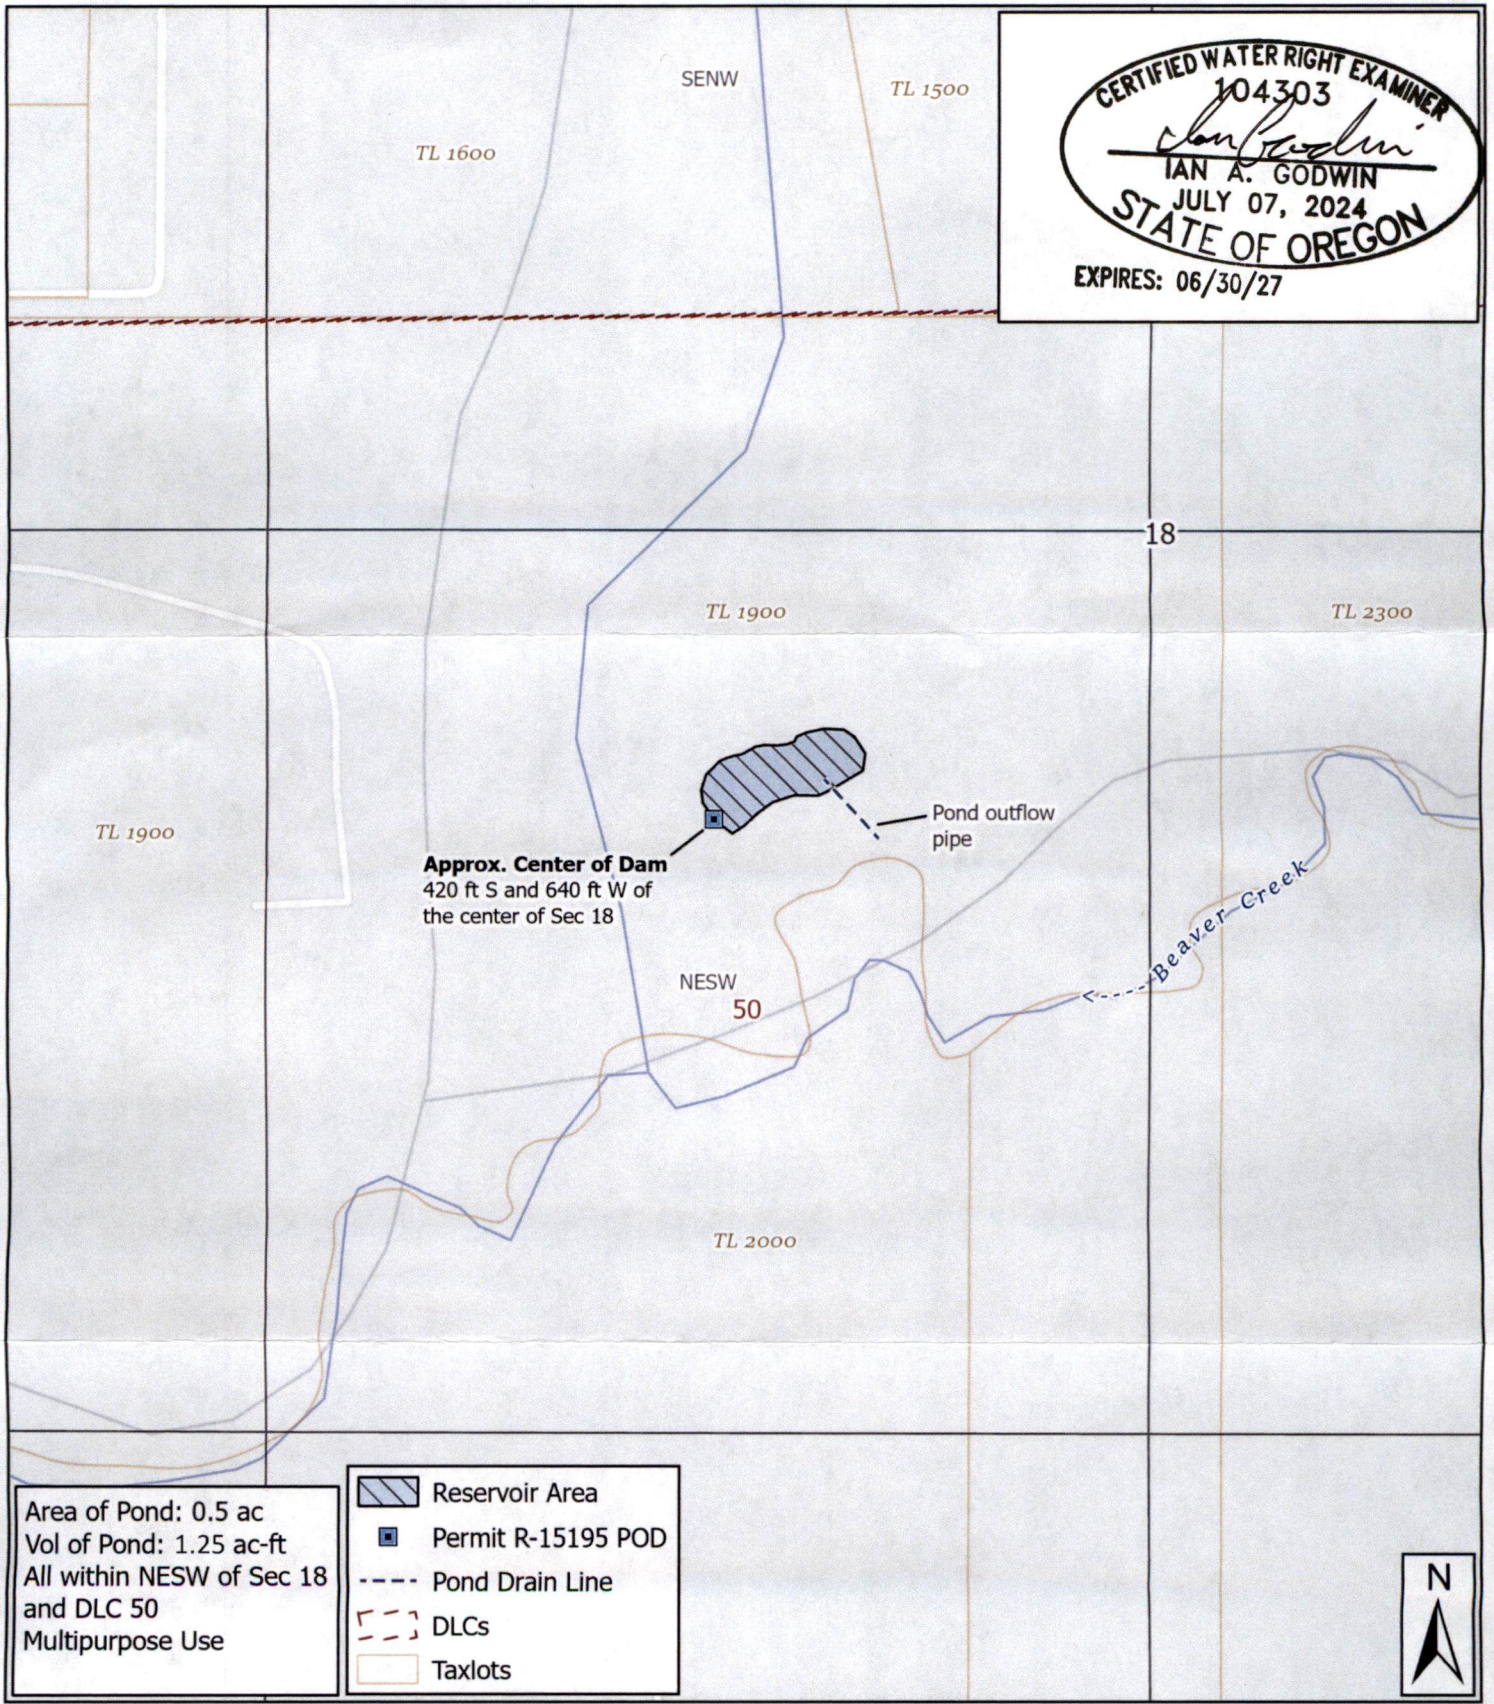

Area of Pond: 0.5 ac  
Vol of Pond: 1.25 ac-ft  
All within NESW of Sec 18  
and DLC 50  
Multipurpose Use


- Reservoir Area
- Permit R-15195 POD
- Pond Drain Line
- DLCs
- Taxlots

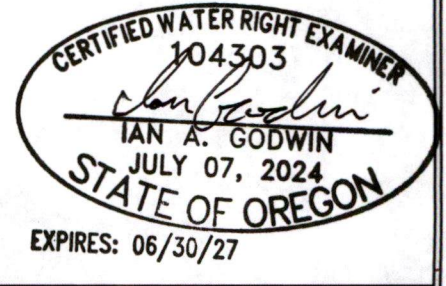

311 B Avenue, Suite P  
Lake Oswego, Oregon 97034  
(503) 954-1326

**Attachment 1**  
**App. R-88236, Permit R-15195**  
**T3S, R2E, Section 18 NESW**

|     |      |      |           |
|-----|------|------|-----------|
| 1   | DATE | AUTH | DRAFT     |
|     |      |      |           |
|     |      |      |           |
| No. | Date | By   | Revisions |

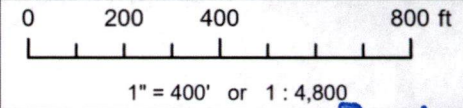

**Proj#: 2557001**  
**Oregon Organic Acres, LLC**  
Ben and Karin McCune  
20454 S. Geiger Road  
Oregon City, OR 97045

Received  
JUN 22 2026  
OWRD