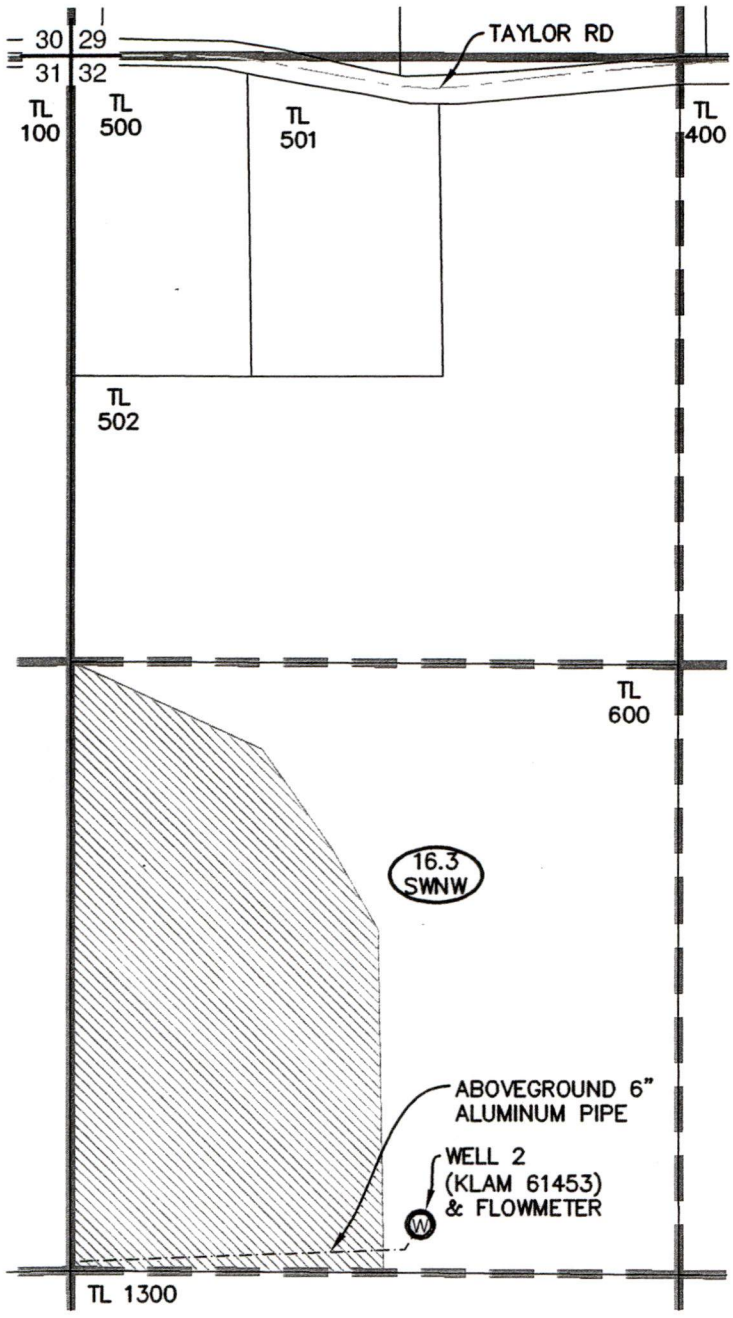


LEGEND

- SECTION LINE
- 1/4 1/4 LINE
- TAX LOT LINE
- PIPE
- ROAD
- 22 | 22 / 22 | 22 — SECTION CORNER
- TL 0000 — TAX LOT NUMBER
- W — POA (WELL)
- 35.0 SWSE — TRANSFER T-14151 PRIMARY IRRIGATION LANDS

NOTES:

1. THIS MAP WAS PREPARED FROM FIELD MEASUREMENTS, NAIP 2026 AERIAL PHOTOGRAPHY, KLAMATH COUNTY TAX MAPS, AND OREGON GLO MAPS.

2. THE PURPOSE OF THIS MAP IS TO IDENTIFY THE LOCATION OF THE WATER RIGHT ONLY, AND IS NOT INTENDED TO PROVIDE DIMENSIONS OR LOCATION OF PROPERTY LINES.

3. DATE OF PRIORITY FOR THIS WATER RIGHT IS MARCH 4, 1981.

WELL LOCATION:

WELL 2 (KLAM 61453): 2565' SOUTH & 730' EAST FROM THE NORTHWEST CORNER OF SECTION 32 (WGS DATUM – LATITUDE: 42.04627°; LONGITUDE: -121.55830°).

Received
JUN 23 2026
OWRD

CERTIFIED WATER RIGHT EXAMINER
#88332CWRE
Daniel B. Scalas
April 23, 2015
STATE OF OREGON
RENEWAL 06/30/28


ADKINS ENGINEERING & SURVEYING
o / 541.884.4666
w / AdkinsEngineering.com
1435 ESPLANADE AVENUE, KLAMATH FALLS, OR 97601
SERVING S. OREGON & N. CALIFORNIA
ENGINEERING • SURVEYING • PLANNING • TESTING

6/19/2026

1979-02

CLAIM OF BENEFICIAL USE MAP

FOR
JOHN ELLIOTT AND LOUDEAN ELLIOTT
T40S, R11E, SEC. 32, WM
KLAMATH COUNTY, OREGON
TRANSFER T-14151

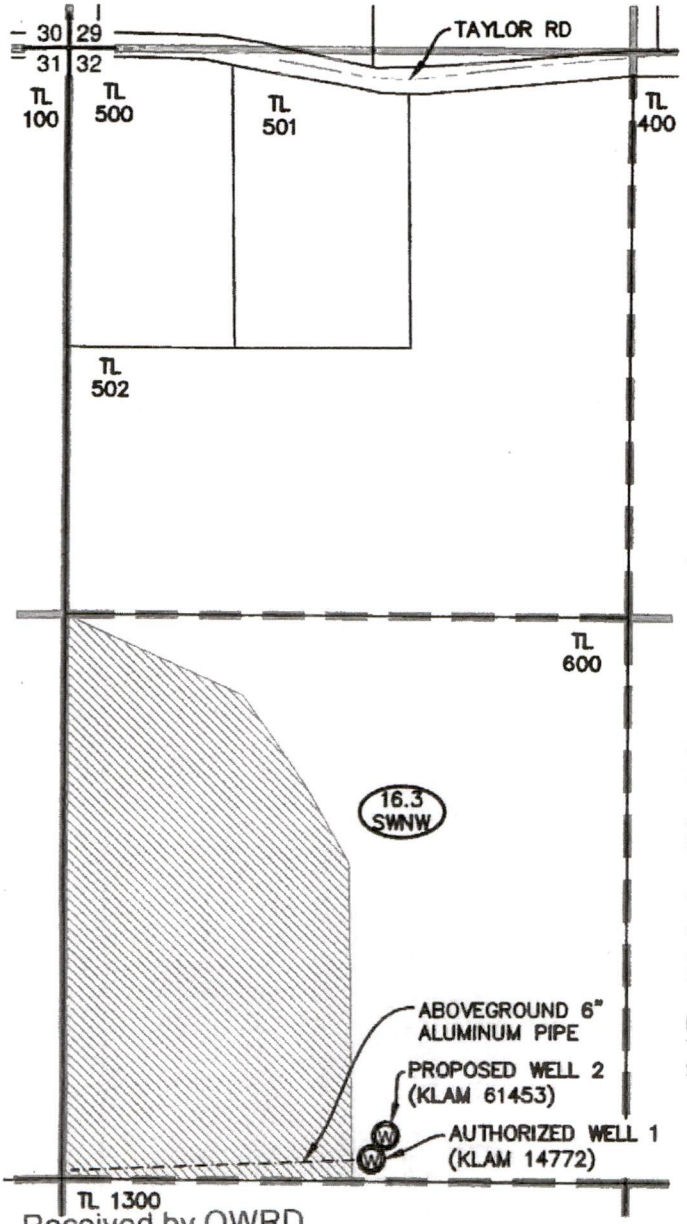

LEGEND

- SECTION LINE
- 1/4 1/4 LINE
- TAX LOT LINE
- PIPE
- ROAD
- 22 | 22 / 22 | 22 — SECTION CORNER
- TL 0000 — TAX LOT NUMBER
- (W) — POA (WELL)
- 35.0 SWSE — CERTIFICATE 65944 TRANSFERRED "TO" LANDS

NOTES:

1. THIS MAP WAS PREPARED FROM FIELD MEASUREMENTS, NAIP 2023 AERIAL PHOTOGRAPHY, KLAMATH COUNTY TAX MAPS, AND OREGON GLO MAPS.

2. THE PURPOSE OF THIS MAP IS TO IDENTIFY THE LOCATION OF THE WATER RIGHT ONLY, AND IS NOT INTENDED TO PROVIDE DIMENSIONS OR LOCATION OF PROPERTY LINES.

3. DATE OF PRIORITY FOR THIS CERTIFICATE IS MARCH 4, 1981.

WELL LOCATIONS:

AUTHORIZED WELL 1 (KLAM 14772): 2590' SOUTH & 720' EAST FROM THE NORTHWEST CORNER OF SECTION 32.

PROPOSED WELL 2 (KLAM 61453): 2565' SOUTH & 730' EAST FROM THE NORTHWEST CORNER OF SECTION 32.

Received by OWRD
JUL 24 2023
Salem, OR

N

SUPERSEDING

400 200 0 400
(FEET)

CERTIFIED WATER RIGHT EXAMINER
#88332CWRE
Daniel B. Scalas
April 23, 2015
STATE OF OREGON
RENEWAL 06/30/24

ADKINS ENGINEERING & SURVEYING
o / 541.884.4666
w / AdkinsEngineering.com
1435 ESPLANADE AVENUE, KLAMATH FALLS, OR 97601
SERVING S. OREGON & N. CALIFORNIA
ENGINEERING • SURVEYING • PLANNING • TESTING

7/25/2023 4055-01

TRANSFER APPLICATION MAP

FOR
JOHN ELLIOTT AND LOUDEAN ELLIOTT
T40S, R11E, SEC. 32, WM
KLAMATH COUNTY, OREGON
CERTIFICATE 65944
APPLICATION G-10195
PERMIT G-9243

Received
JUN 23 2026
OWRD