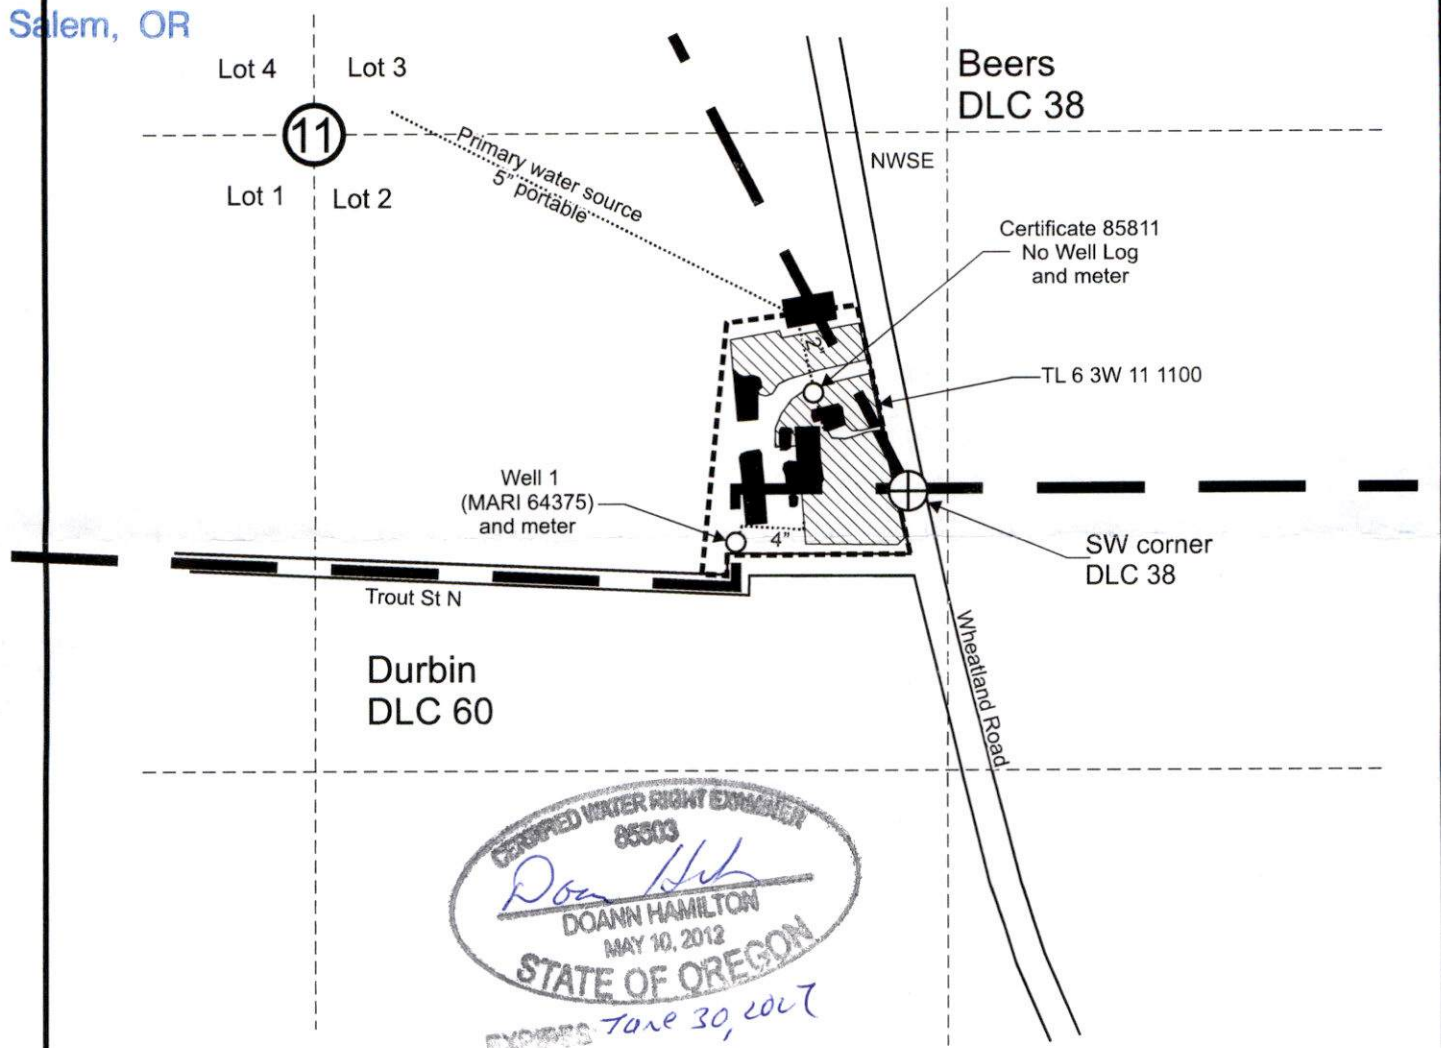


JUN 24 2026

Salem, OR

T.6S. R.3W. Section 11, W.M.

Certificate 85811 Well (no well log) is located 197 feet north and 191 feet west from the SW corner, DLC 38. (45.06295, -123.015872, WGS 84)

Well 1 (MARI 64375) is located 850 feet south and 870 feet east from the C1/4 corner, Section 11. (45.06208427, -123.01643596, WDS 84)


 Area (1.9 Acres) irrigated under T-14606, former Certificate 85811 for agriculture use and supplemental irrigation, priority date: 8-15-1994. Primary Certificate 56267.

----- Tax lot boundary

———— Donation Land Claim boundaries

..... Mainlines

Scale: 1" = 400'

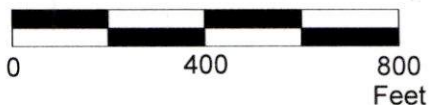

This map was prepared for the purpose of identifying the location of a water right only and is not intended to provide legal dimensions or location of property ownership lines.



Claim of Beneficial Use Map
T-14606, former Certificate 85811

Bruce and Velan Chapin Living Trust
T.6S. R.3W. Section 11, W.M.

WM
WILL MCGILL SURVEYING LLC

06/2026