


CLAIM OF BENEFICIAL USE SURVEY - T13714
LOCATED IN T38S R1W S28 W.M. TL1400
ROGUE RIVER BASIN - JACKSON COUNTY, OREGON

Received
JUN 22 2026
OWRD

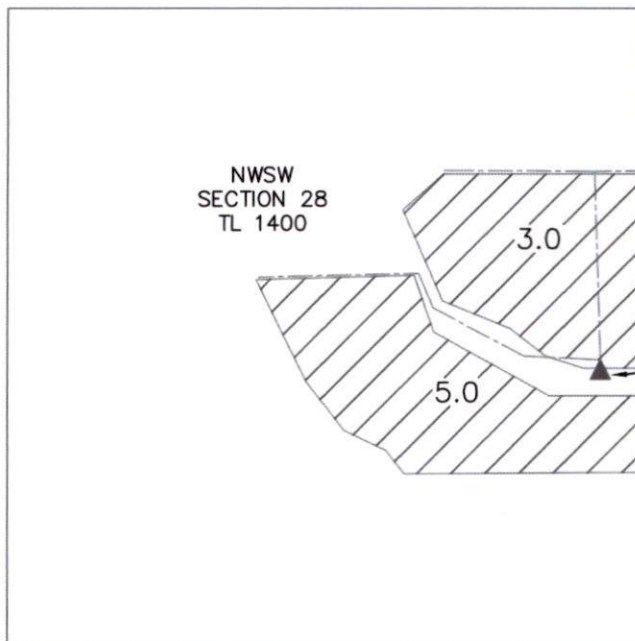

SCALE 1" = 400'



8.0 ACRES
NURSERY



2 INCH PIPELINE

PREPARED FOR:
MONTE MINCHOW
2232 ZEMKE RD.
TALENT, OR 97540

PREPARED BY:
SCOTT FEIN, CWRE
PO BOX 694
ASHLAND, OR 97520
SFEINSURVEYOR@GMAIL.COM
541-842-0795



DATE: 6/10/2026

FOR WATER RIGHT PURPOSES ONLY
NOT FOR PROPERTY BOUNDARY
LOCATIONS OR DIMENSIONS