E-RECEIVED
JUN 24, 2026
OWRD

APPLICATION MAP 6/23/26 REVISION
SITE MAP TAXLOT 1100 SE QTR SEC 34 TWP 36S R4W

24055

MAP OF SURVEY
PROPERTY LINE ADJUSTMENT

FOR:
RYAN & ASHLEIGH BAUMANN
&
WB AGRICULTURAL LLC.

SITE:
1685 & 1721 BIRDSEYE CREEK ROAD
GOLD HILL, OREGON 97525

LOCATED IN THE SOUTHEAST QUARTER OF SECTION 34,
TOWNSHIP 36 SOUTH, RANGE 4 WEST,
WILLAMETTE MERIDIAN,
JACKSON COUNTY, OREGON

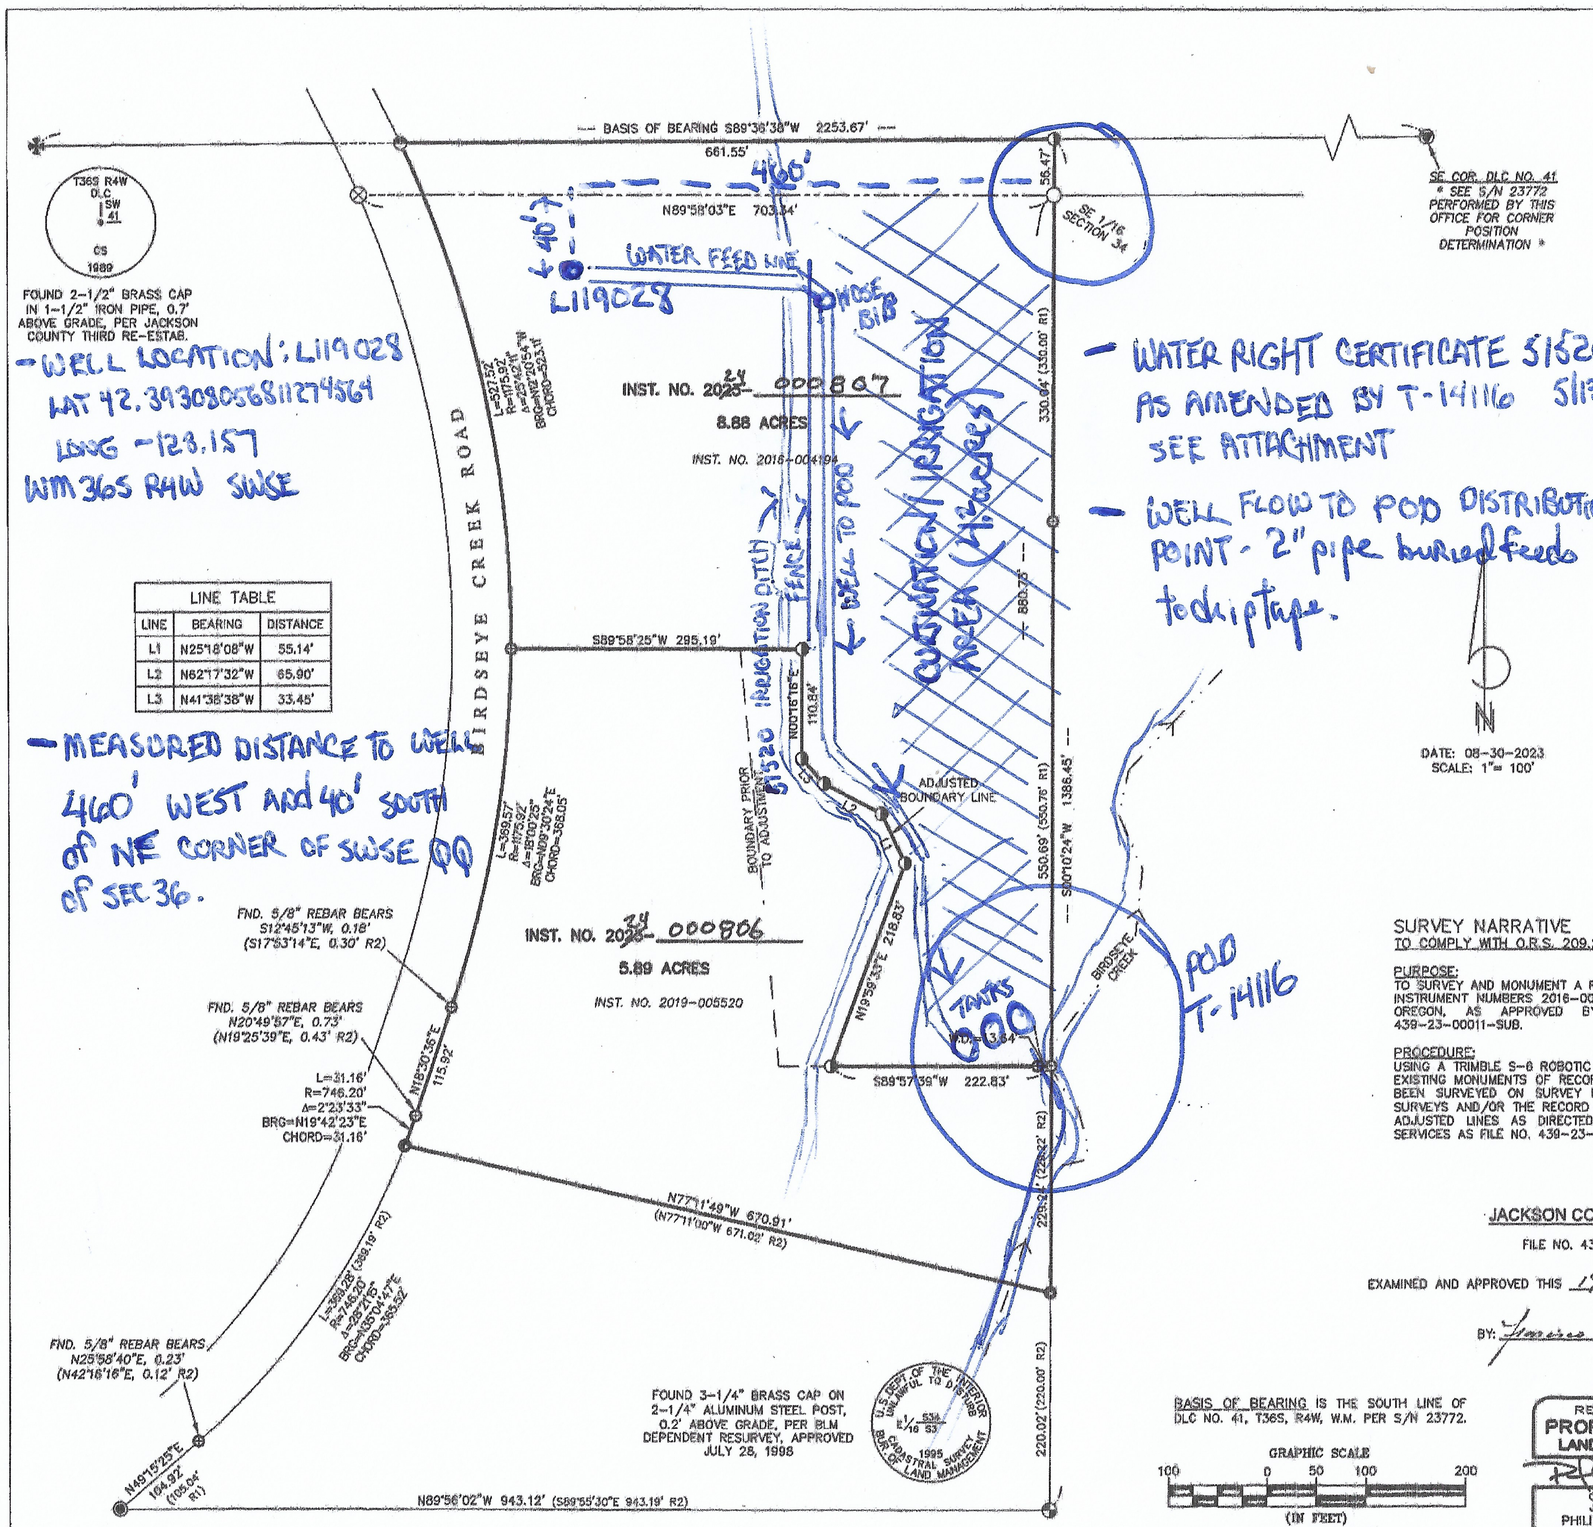

- WELL LOCATION: L119028
LAT 42.39308056811274564
LONG -123.157
WM 36S R4W SWSE

- WATER RIGHT CERTIFICATE 51520 AS AMENDED BY T-14116 5/13/24 SEE ATTACHMENT

- WELL FLOW TO POD DISTRIBUTION POINT - 2" pipe buried feeds tackiptape.

- MEASURED DISTANCE TO WELL 460' WEST AND 40' SOUTH OF NE CORNER OF SWSE QQ OF SEC 36.

LINE TABLE		
LINE	BEARING	DISTANCE
L1	N25°18'08"W	55.14'
L2	N62°17'32"W	65.90'
L3	N41°38'38"W	33.45'

DATE: 08-30-2023
SCALE: 1"= 100'

LEGEND

	BOUNDARY LINE
	FOUND 2-1/2" BRASS CAP PER JACKSON COUNTY RE-ESTAB. OR AS NOTED
	FOUND 3-1/4" STANDARD BLM BRASS CAP PER DEPENDENT RESURVEY, APPROVED JULY 28, 1998
	FOUND 2" BRASS CAP PER S/N 7263
	FOUND 3/4" REBAR PER S/N 6094
	FOUND 5/8" REBAR PER S/N 7263 OR 8491
	FOUND 5/8" REBAR WITH RED PLASTIC CAP STAMPED DA EDWARDS LS 2339 PER S/N 12938
	FOUND 5/8" REBAR WITH ORANGE PLASTIC CAP STAMPED "J. MARTIN PLS 54729" PER S/N 21403
	FOUND 5/8" REBAR WITH 1-1/2" ALUMINUM CAP STAMPED "DROSSOS LS 90718" PER S/N 23772
	SET 5/8" X 30" REBAR WITH 1-1/2" ALUMINUM CAP STAMPED "DROSSOS LS 90718"
	COMPUTED POSITION, NOTHING FOUND NOT SET
S/N	SURVEY NUMBER, ON FILE IN THE OFFICE OF THE JACKSON COUNTY SURVEYOR, JACKSON COUNTY
W.D.	WITNESS DISTANCE
(R1)	RECORD DATA PER S/N 7263
(R2)	RECORD DATA PER S/N 21403

SURVEY NARRATIVE
TO COMPLY WITH O.R.S. 209.250

PURPOSE:
TO SURVEY AND MONUMENT A PROPERTY LINE ADJUSTMENT BETWEEN THOSE TRACTS OF LAND DESCRIBED IN INSTRUMENT NUMBERS 2016-004194 AND 2019-005520 OF THE OFFICIAL RECORDS OF JACKSON COUNTY, OREGON, AS APPROVED BY THE JACKSON COUNTY DEVELOPMENT SERVICES AS FILE NO. 439-23-00011-SUB.

PROCEDURE:
USING A TRIMBLE S-6 ROBOTIC TOTAL STATION AND TRIMBLE R-10 GPS RECEIVERS, I RECOVERED AND TIED EXISTING MONUMENTS OF RECORD AS SHOWN HEREIN. THE EXTERIOR OF BOTH SUBJECT PROPERTIES HAVE BEEN SURVEYED ON SURVEY NUMBER 7263 AND 21403. I HOLD THE RECOVERED CORNERS PER SAID SURVEYS AND/OR THE RECORD DATA PER INST. NO. 68-02820 AS SHOWN HEREIN. I THEN MONUMENT THE ADJUSTED LINES AS DIRECTED BY THE CLIENTS AND APPROVED BY JACKSON COUNTY DEVELOPMENT SERVICES AS FILE NO. 439-23-00011-SUB.

JACKSON COUNTY APPROVAL
FILE NO. 439-23-00011-SUB
EXAMINED AND APPROVED THIS 12 DAY OF January 2024 2023.
BY: Jessica M. Dennard

FILED
Date 1/22/24 By PLS
This Survey Consists Of:
1 sheet(s) Map
2 page(s) Narrative
JACKSON COUNTY SURVEYOR

BASIS OF BEARING IS THE SOUTH LINE OF DLC NO. 41, T36S, R4W, W.M. PER S/N 23772.

GRAPHIC SCALE
100 0 50 100 200
(IN FEET)
1 INCH = 100 FEET

REGISTERED PROFESSIONAL LAND SURVEYOR
OREGON
JULY 12, 2016
PHILIP J. DROSSOS
No. 90718
Renewal 12-31-23

TERRASURVEY, INC.
PROFESSIONAL LAND SURVEYORS
270 FOURTH STREET
ASHLAND, OREGON 97520
(541) 482-6474
terrain@bisp.net

JOB NO. 1684-22

ASSESSOR'S MAP NO. 36 4W 34, TAX LOT 1100 & 1106

24055