


T.4S. R.1E. Section 36 and T.5S. R.1E. Section 1, W.M.

E-RECEIVED
MAY 26 2026
OWRD

Scale: 1" = 400'

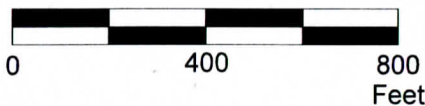

35.36

2 1

S. Barnards Rd.

Wheeler Creek

Proposed Well 2

29.3

NWNW

NENW

30.3

TL 4 1E 36 1800

SESW

TL 4 1E 36 1903

TL 4 1E 36 1904

Proposed Well 1

12.3

SWSE

Pre-existing access
under Barnards road

TL 5 1E 01 1400


S. Molalla Forest Rd

Proposed Well 1 is located 655 feet north and 3,015 feet east from the SW corner, Section 36.
Proposed Well 2 is located 60 feet south and 1,345 feet east from the NW corner, Section 1.

Area (110.6 Acres) to be irrigated

Tax lot boundary

Water main line, portable

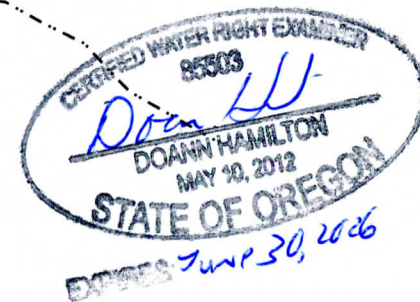

This map was prepared for the purpose of identifying the location of a water right only and is not intended to provide legal dimensions or location of property ownership lines.

Water Right Application Map

Bob and Denise Jonas
T.4S. R.1E. Sec. 36 and
T.5S. R.1E. Sec. 1, W.M.

03/2021
Rev. 05/2026

WILL MCGILL SURVEYING LLC

15333 Pletzer Rd. SE
Turner, Oregon 97392
(503) 931-0210 Phone



E-RECEIVED
MAY 26 2026
OWRD

Memo

To: Oregon Water Resources Department / Lucinda Vranizan
From: Doann Hamilton, CWRE
CC:
Date: May 26, 2026
Re: Application G-19075

On May 21, 2026, I received an email from Lucinda Vranizan from OWRD concerning Application G-19075. Our client Bob Jonas needed to reply accepting Will McGill Surveying as the new agent for his water right. Bob sent that email May 22, 2026 approving Will McGill Surveying as the new agent.

Also revisions to the map needed to be addresses:

- a. Mainlines needed to be marked even though the lines are portable
- b. Addition of quarter-quarter identification

Corrections have been made to the map.
Attached is the corrected map to reflect these changes.

