


T.6S. R.1W. Sec. 19 & 20, W.M.

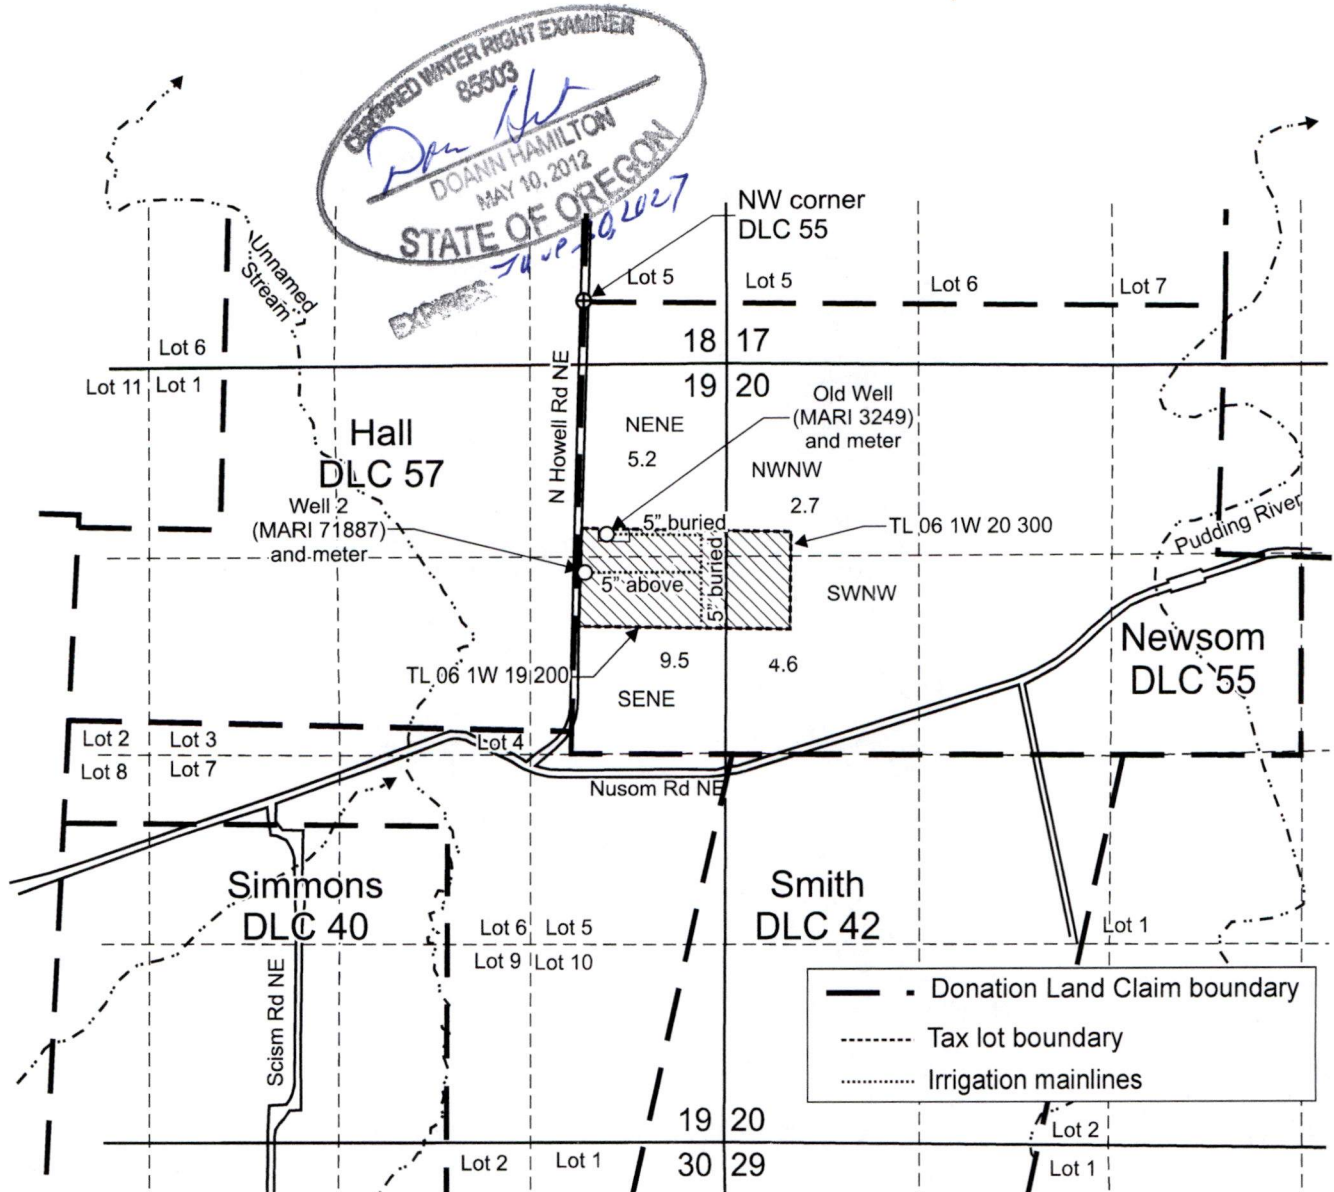

Old Well (MARI 3249) is located 1,590 feet south and 160 feet east from the NW corner, DLC 55. (45.039044, -122.848919, WGS 84)

Well 2 (MARI 71887) is located 1,425 feet south and 980 feet west from the NE corner, Section 19. (45.0383, -122.8494, WGS 84)

 Area (22.0 Acres) irrigated under T-14528, formerly Certificate 39904, priority date: 4-2-1968.

Scale: 1" = 1,320'



This map was prepared for the purpose of identifying the location of a water right only and is not intended to provide legal dimensions or location of property ownership lines.

Claim of Beneficial Use Map
T-14528, formerly Certificate 39904

Chuck Eder Farms, Inc.
T.6S. R.1W. Sec. 19 & 20, W.M.

06/2026

 WILL MCGILL SURVEYING LLC

Received by OWRD
JUN 29 2026
Salem, OR