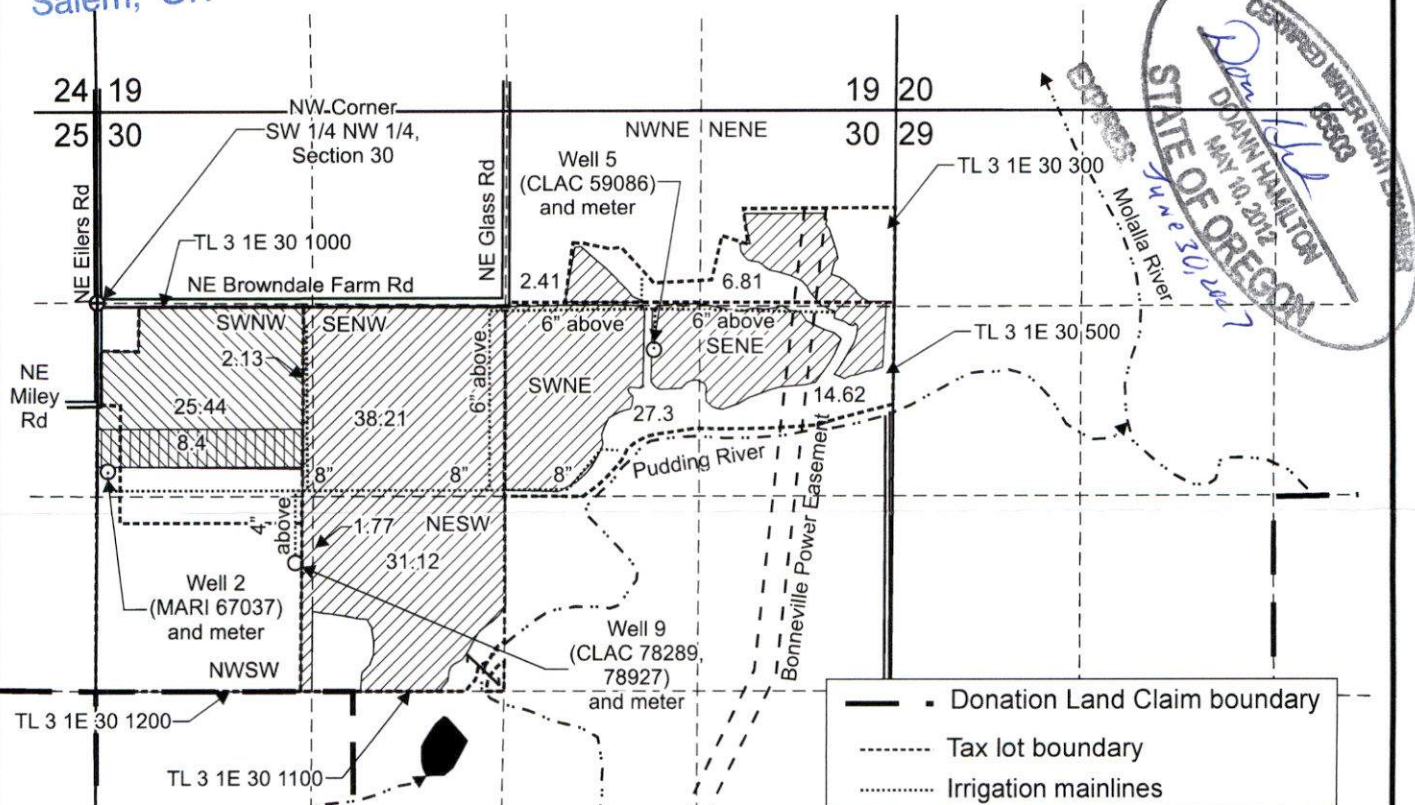


JUN 17 2026

Salem, OR

T.3S. R.1E. Section 30, W.M.

Well 2 (MARI 67037) is located 2,470 feet south and 75 feet east from the NW corner, Section 30.
(45.28176000, -122.74365000, WGS 84)

Well 5 (CLAC 59086) is located 1,645 feet south and 1,605 feet west from the NE corner, Section 30.
(45.284178, -122.729044, WGS 84)

Well 9 (CLAC 78289, 78927) is located 3,100 feet south and 1,380 feet east from the NW corner, Section 30.
(45.280078, -122.738519, WGS 84)

Area (25.44 Acres) of primary irrigation under Application G-17988, Permit G-18910, T-14374, priority date: 1-27-2015.

Area (124.37 Acres) of primary irrigation under Application G-17988, Permit G-18910, T-14374, to make up deficiency in rate, priority date: 1-27-2015.

Area (8.4 Acres) diminished to supplemental irrigation under T-13112, primary Certificate 98442, priority date: 8-15-1939..

This map was prepared for the purpose of identifying the location of a water right only and is not intended to provide legal dimensions or location of property ownership lines.

Claim of Beneficial Use Map
Application G-17988, Permit G-18910, T-14374

WILL MCGILL SURVEYING LLC

06/2026

Bob Gabriel
T.3S. R.1E. Section 30, W.M.