


CLAIM OF BENEFICIAL USE MAP

T3S, R3W, SECTION 28, SW/SW, TAX LOT 1001, W.M.
APPLICATION R-88901; PERMIT R-15478
YAMHILL COUNTY

OWNERS:
DOMAINE SERENE VINEYARDS AND WINERY, INC.
DEEPWATER C&D PROPERTIES, LLC
6555 NE HILLTOP LANE
DAYTON, OR 97114


LEGEND

- SECTION LINE
- 1/4 1/4 LINE
- DLC LINE
- TAX LOT LINE
- ⬤ SECTION CORNER
- ◆ DLC CORNER
- BURIED PVC IRRIGATION LINE
- UNNAMED TRIBUTARY

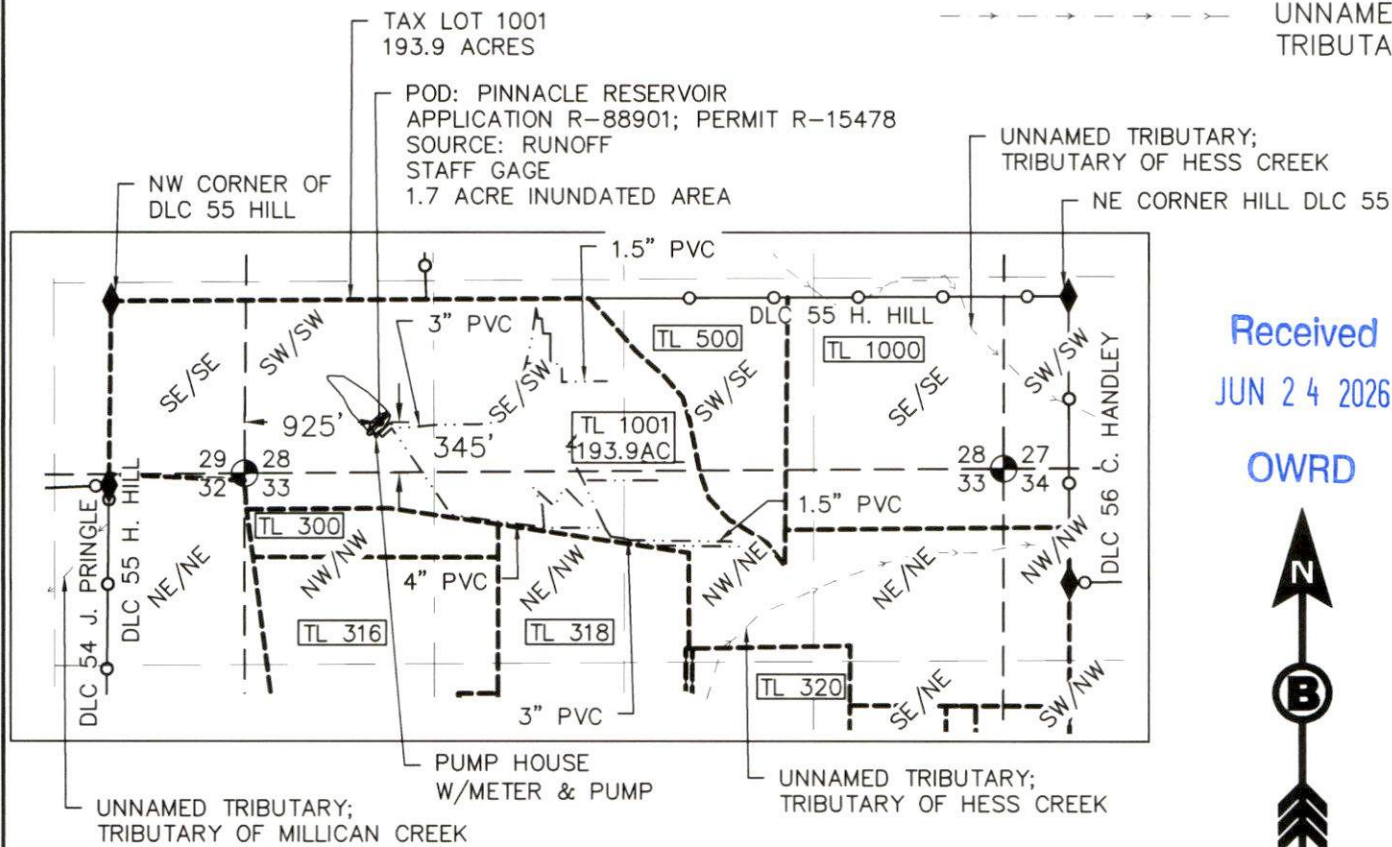

Received
JUN 24 2026

OWRD

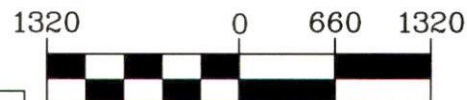

1 inch = 1320 ft.
PRINT SCALE=8.5"x11"

POD	TWP	RNG	SEC	Q-Q	TL	DLC	MEASURED DISTANCE	LAT. / LONG. DATUM: WGS84
PINNACLE RESERVOIR	3S	3W	28	SW SW	1001	55	345'N AND 925'E FROM SW CORNER OF SECTION 28	LAT: 45.2748528° LONG: -123.0696917°

BLUNDON
ENGINEERING, LLC

PO BOX 786
HILLSBORO, OREGON 97123
541-510-5910
NICK@BLUNDONENGINEERING.COM

NOTE: THIS MAP IS NOT
INTENDED TO PROVIDE LEGAL
DIMENSIONS OR LOCATIONS OF
PROPERTY OWNERSHIP LINES.

