

GR8

5/1W-13 R

13

Name Raymond M. SchneiderApplication No. GR 2468Certificate No. GR 2337

FEES PAID

Date	Amount	Receipt No.
7/22/58	15.00	18111

By _____

Address MonitorStream Index, Page No. 2-94H ✓Oregon

FEES REFUNDED

Date	Amount	Check No.

Date filed May 23, 1957 8⁰⁰ AMTentative priority 1942

Action suspended until _____

ASSIGNMENTS

Well log filed _____

Date	To Whom	Address	Volume	Page

CONSTRUCTION

REMARKS

Date for completion _____

Extended to _____

Date for application of water _____

Extended to _____

PROSECUTION OF WORK

Form "B" filed _____

Form "C" filed _____

A well irrigates 22⁰ acres near Rock Cr. Pudding River - Clackamas County

RECEIVED

MAY 23 1957

STATE ENGINEER
SALEM, OREGON

Registration Statement

OF CLAIMANT OF RIGHT TO APPROPRIATE GROUND WATER

(Under Chapter 708, Oregon Laws 1955.)

REGISTRATION NO. GR-2468

CERTIFICATE NO. GR-2337

TO THE STATE ENGINEER OF OREGON:

I, Raymond M. Schaefer

of Clatsop

County of Clatsop

State of Oregon, do hereby make application for a certificate of registration as evidence of a right to appropriate ground water.

1. Source from which water is withdrawn is pump well
(Flowing well, pump well, infiltration trench, or tunnel)

2. Location is: 3 miles north of Monitor
(Approximate distance and direction from nearest city or town)

and is more particularly described as follows:

(a) Beginning 1000 feet west of 200 feet north from S.E. corner Section 13
(Give distance and bearing to corner of section or other legal subdivision)
being within Wm. Ellard & wife D.L.C. 45 of Sec. 13, Twp. 5 South, Rge. 1 W
(Smallest legal subdivision) (N. or S.) (E. or W.)

or (b) within limits of recorded platted property, town or city:

in Lot _____ Block _____ of _____
(Name of plat or addition)

County of _____
(If within city or town, give name)

3. Construction Work was begun on 1942; was completed on June 1951
(Date) (Date)

and the ground water claimed was first used for the purposes set out below on June 1951
(Date)

since which time the water has been used continuously
(Continuously or intermittently)

from 1951 to 1957
(Date) (Date)

4. Quantity of water claimed and used is 6.5 gal gallons per minute; _____ acre
feet per year.

5. Purpose or Purposes for which water is used irrigation
(Domestic, irrigation, municipal, manufacturing, industrial, etc.)

6. Description of Well: Depth 155 feet. Type drilled
(Dug or drilled)
diameter 6 inches. Elevation of ground at well site 100 (?) feet, mean sea level.
(As near as known)
Depth to water table 24 feet.

7. Capacity of Well: 2500 g.p.m. with 80 feet drawdown.
_____ g.p.m. with _____ feet drawdown.

Date of test 1951 June

If Flowing Well: Measured discharge _____ g.p.m. on _____
(Date)

Shut-in pressure at ground surface _____ lbs. per sq. in. on _____
(Date)

Water is controlled by _____
(Cap, valve, etc.)

8. Casing: (Give diameter, commercial specifications and depth below ground surface of each casing size.)

6 inch diameter steel from surface to 112 feet

inch diameter _____ from _____ to _____ feet

inch diameter _____ from _____ to _____ feet

inch diameter _____ from _____ to _____ feet

Describe and show depth of shoe, plug, adapter, liner or other details:

9. Perforated Casings or Screens:

9. Perforated Casings or Screens:

(Number per foot and size of perforations, or describe screen)

from to

from to

from to

from to

10. Log of Well: (Describe each stratum or formation clearly, indicate if water bearing, and give thickness and depth as indicated.)

[illegible]

If log of well is not available, give name and address of driller. Benson Ballinger

Mr. Woodburn, Rt. 2, Oregon

11. Infiltration Trench: Covered or open

Dimensions: Length ft. Minimum depth ft. Maximum depth ft.

Bottom width ft. Discharge g.p.m. Date of test

12. Tunnel: Type of Lining

Dimensions:

(Length, course, and cross sectional size)

Position of water bearing stratum with reference to portal of tunnel

Log of tunnel: (Preceding table for log of well may be used, if desired. Give footage from portal and character of materials, as pertinent.)

13. Pumping Equipment:

(a) Pump Cook Turbette Capacity 6.5 g.p.m.

(b) Motor 3 hp. Eno
(Type and horsepower)


14. Location of area irrigated or to be irrigated, or place of use if for purposes other than irrigation.

[illegible]

15. If the ground water supply is supplemental to an existing water supply, identification of any application for a permit, permit, certificate or adjudicated right to appropriate water made or held by the registrant.

Only 1 well

Township 53 Range 1 W W.M.
North

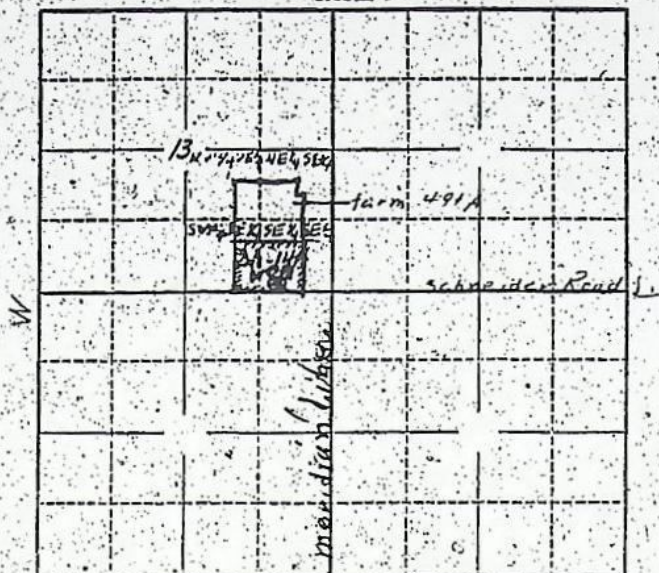

Locate well and acreage of irrigated land on plat.
Scale: 2" = 1 Mile

STATE OF OREGON

County of Tackanias } ss.

I, Raymond M. Schneider, being first duly sworn, do hereby certify that I have read the foregoing Registration Statement and that all of the items therein contained are true to the best of my knowledge and belief.

Raymond M. Schneider
(Signature of Registrant)

Subscribed and sworn to before me this 20 day of May, 1957.

My commission expires July 22-1957

Arthur J. Schmid
(Notary Public)

(SEAL)

CERTIFICATE OF REGISTRATION

STATE OF OREGON

County of Marion } ss.

This is to certify that the foregoing Registration Statement was received in the office of the State Engineer on the 22 day of July, 1958, at 8:00 o'clock A. M. and has been duly recorded in said office in Book No. 10 of Registration Statements on page GR-2337.

Witness my hand this 10th day of March, 1959.

Lewis A. Stander
(State Engineer)

By

(Deputy)

GR-2337

RECEIVED
JUN 13 1957
STATE ENGINEER
CLATSOP COUNTY

FILE NO. GR-2468

DATE NO. GR-2337

Registration Statement

OF CLAIMANT OF RIGHT TO APPROPRIATE GROUND WATER

(Under Chapter 708, Oregon Laws 1955.)

TO THE STATE ENGINEER OF OREGON:

I, Raymond M. Schindler,
of _____ County of Clatsop
State of Oregon, do hereby make application for a certificate of registration as evidence
of a right to appropriate ground water.

1. Source from which water is withdrawn is pump well
(Flowing well, pump well, infiltration trench, or tunnel)
2. Location is: 3 miles north of Molalla
(Approximate distance and direction from nearest city or town)

and is more particularly described as follows:

(a) Beginning 1000 feet west & 200 feet north from S.E. corner Section 13
(Give distance and bearing to corner of section or other legal subdivision)
being within SE 1/4 of SE 1/4 of Sec. 13, Twp. 5 South, Rge. 1 W
(Smallest legal subdivision) (N. or S.) (E. or W.)
or (b) within limits of recorded platted property, town or city: _____
in Lot _____, Block _____ of _____
(Name of plat or addition)

County of _____
(If within city or town, give name)

3. Construction Work was begun on 1942; was completed on June 1951
(Date) (Date)
and the ground water claimed was first used for the purposes set out below on June 1951,
(Date)
since which time the water has been used const.
(Continuously or Intermittently)
from 1951 to 1957
(Date) (Date)

4. Quantity of water claimed and used is 6.5 gal gallons per minute; _____ acre
feet per year.

5. Purpose or Purposes for which water is used irrigation
(Domestic, irrigation, municipal, manufacturing, industrial, etc.)

6. Description of Well: Depth 15.5 feet. Type drilled
(Dug or drilled)
diameter 6 inches. Elevation of ground at well site 100 (?) feet, mean sea level.
(As near as known)
Depth to water table 24 feet.

7. Capacity of Well: 150 g.p.m. with 50 feet drawdown.
_____ g.p.m. with _____ feet drawdown.

Date of test 1951 - June

If Flowing Well: Measured discharge _____ g.p.m. on _____
(Date)

Shut-in pressure at ground surface _____ lbs. per sq. in. on _____
(Date)

Water is controlled by _____
(Cap, valve, etc.)

9. Perforated Casings or Screens:

11. Infiltration Trench: Covered or open

12. Tunnel: Type of lining

(Length, course, and cross sectional size)

Position of water bearing stratum with reference to portal of tunnel

Log of tunnel: (Preceding table for log of well may be used, if desired. Give footage from portal and character of materials, as pertinent.)

13. Pumping Equipment:

(a) Pump Cook Turbette Capacity 45 g.p.m.
(Make, type and size)


(b) Motor 3 h.p. car
(Type and horsepower)

14. Location of area irrigated or to be irrigated, or place of use if for purposes other than irrigation.

15. If the ground water supply is supplemental to an existing water supply, identification of any application for a permit, permit, certificate or adjudicated right to appropriate water made or held by the registrant.

Only 1 well

North

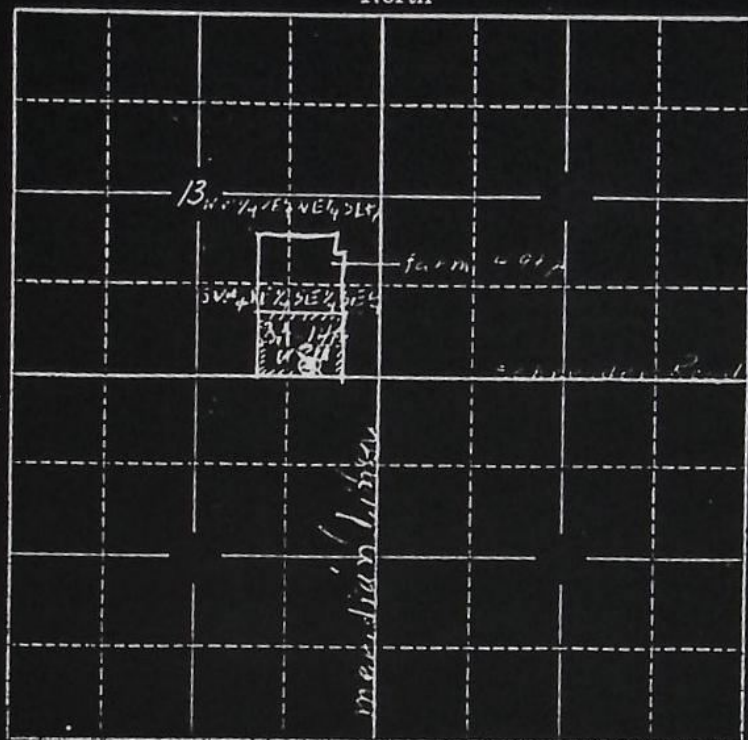

Scale: 2" = 1 Mile

County of Rockingham ss.

Raymond M. Schneider
(Signature of Registrant)

My commission expires July 22-1957

May 1964
 Peter J. ...
 (Notary Public)
 My Com. Exp. 7/1

STATE OF OREGON }
County of Marion } ss.


[illegible]

1959
Lewis A. Stanley
(State Engineer)

By _____
(Deputy)

GR-2337

Township 53 Range 1 W, W.M.
North

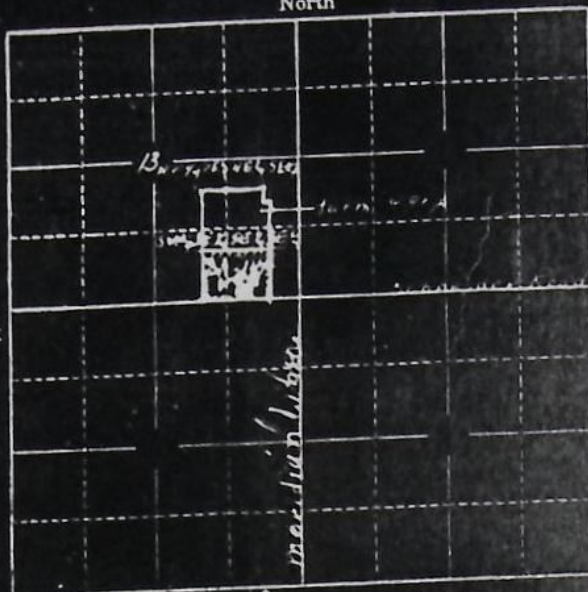

Locate well and acreage of irrigated land on plat.
Scale: 2" = 1 Mile

STATE OF OREGON

County of Sackamago

I, Raymond M. Schneider, being first duly sworn, do hereby certify that I have read the foregoing Registration Statement and that all of the items therein contained are true to the best of my knowledge and belief.

Raymond M. Schneider
(Signature of Registrant)

Subscribed and sworn to before me this 20 day of July, 1957

My commission expires July 20, 1957

(SEAL)

CERTIFICATE OF REGISTRATION

STATE OF OREGON

County of Marion

This is to certify that the foregoing Registration Statement was received in the office of the State Engineer on the 22 day of July, 1958, at 8:00 o'clock A.M. and has been duly recorded in said office in Book No. 10 of Registration Statements on page GR-2337

Witness my hand this 10th day of March, 1959

Lewis A. Ottum
(State Engineer)

By

(Deputy)

GR-2337

GR-2168

August 8, 1958

Raymond M. Schneider
Monitor
Oregon

Dear Mr. Schneider:

15.00

18111

2168

GR-2460

March 27, 1959

Raymond M. Schnieder
Monitor
Oregon

Dear Sir:

GR-2460
GR-2537

gr 2468
June 6, 1957

Mr. Raymond Schneider
Route 2 Box 163-A
Woodburn, Oregon

Dear Mr. Schneider:

This will acknowledge receipt of your registration statement which we are returning to you for additional information under Items 2, 11, and the plat map on the last page. Please find enclosed a general information sheet which will aid you in completing the above mentioned items.

Before your statement can be processed for certification the law requires that we receive a registration fee. This fee is based upon the number of acres to be irrigated and the minimum fee of \$15 will cover registration for one to thirty acres.

Therefore, upon receipt of your completed statement and registration fees in the amount of \$15, this office will issue your certificate of registration.

Very truly yours,

LEWIS A. STANLEY
State Engineer

By
Wm. S. Bartholomew
Geologist

WSB:gw
Enc.