


JUL 02 2026

T.7S. R.2W. Sec. 27 & 28, W.M.

Salem, OR

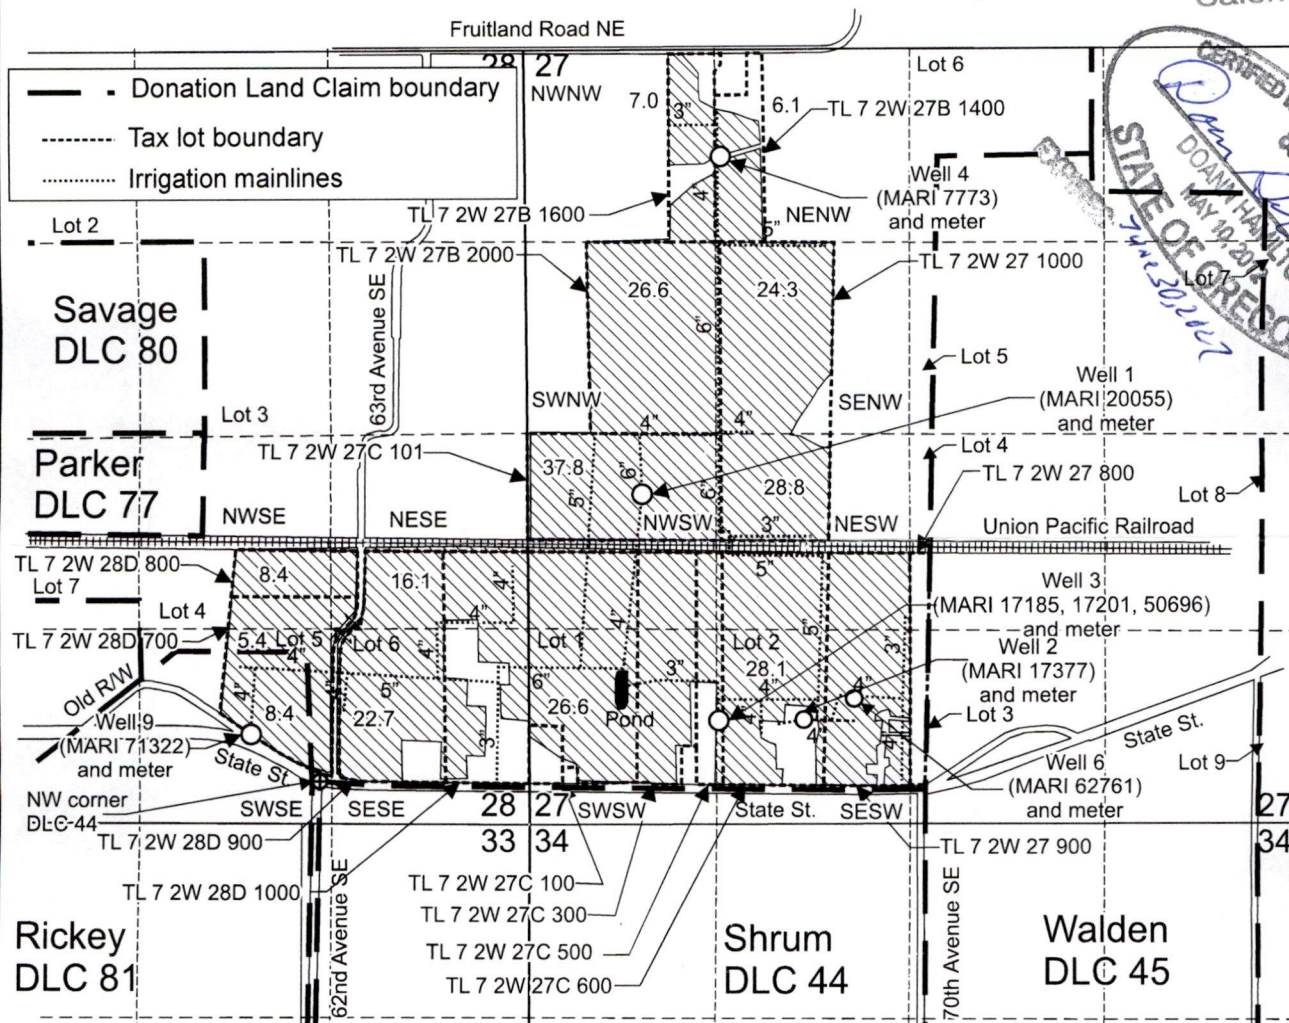

Well 1 (MARI 20055) is located 2,250 feet north and 750 feet east from the SW corner, Section 27. (44.93212796, -122.92491586, WGS 84)

Well 2 (MARI 17377) is located 710 feet north and 1,920 feet east from the SW corner, Section 27. (44.928097, -122.920342, WGS 84)

Well 3 (MARI 17185, 17201, 50696) is located 715 feet north and 1,300 feet east from the SW corner, Section 27. (44.928058, -122.922714, WGS 84)

Well 4 (MARI 7773) is located 725 feet south and 1,350 feet east from the NW corner, Section 27. (44.93882188, -122.92277287, WGS 84)

Well 6 (MARI 62761) is located 860 feet north and 3,050 feet west from the NE corner, Section 34. (44.928511, -122.919022, WGS 84)

Well 9 (MARI 71322) is located 625 feet north and 1,910 feet west from the SE corner, Section 28. (44.92778000, -122.93507000, WGS 84)

 Area (246.3 Acres) of nursery use under Application G-15547, Permit G-18904, T-13783.

Scale: 1" = 1,320'



This map was prepared for the purpose of identifying the location of a water right only and is not intended to provide legal dimensions or location of property ownership lines.

Claim of Beneficial Use Map
Application G-15547, Permit G-18904, T-13783

Kuenzi Turf and Nursery
T.7S. R.2W. Sec. 27 & 28, W.M.

06/2026

 WILL MCGILL SURVEYING LLC