


CLAIM OF BENEFICIAL USE SURVEY PERMIT S55537
 PERMIT AMMENDMENT T14304
 PRIOR PERMIT S54549 APPLICATION S86828)
 LOCATED IN T34S R1W, SECTIONS 28, 29 & 33 W.M.
 ROGUE RIVER BASIN- JACKSON COUNTY, OREGON

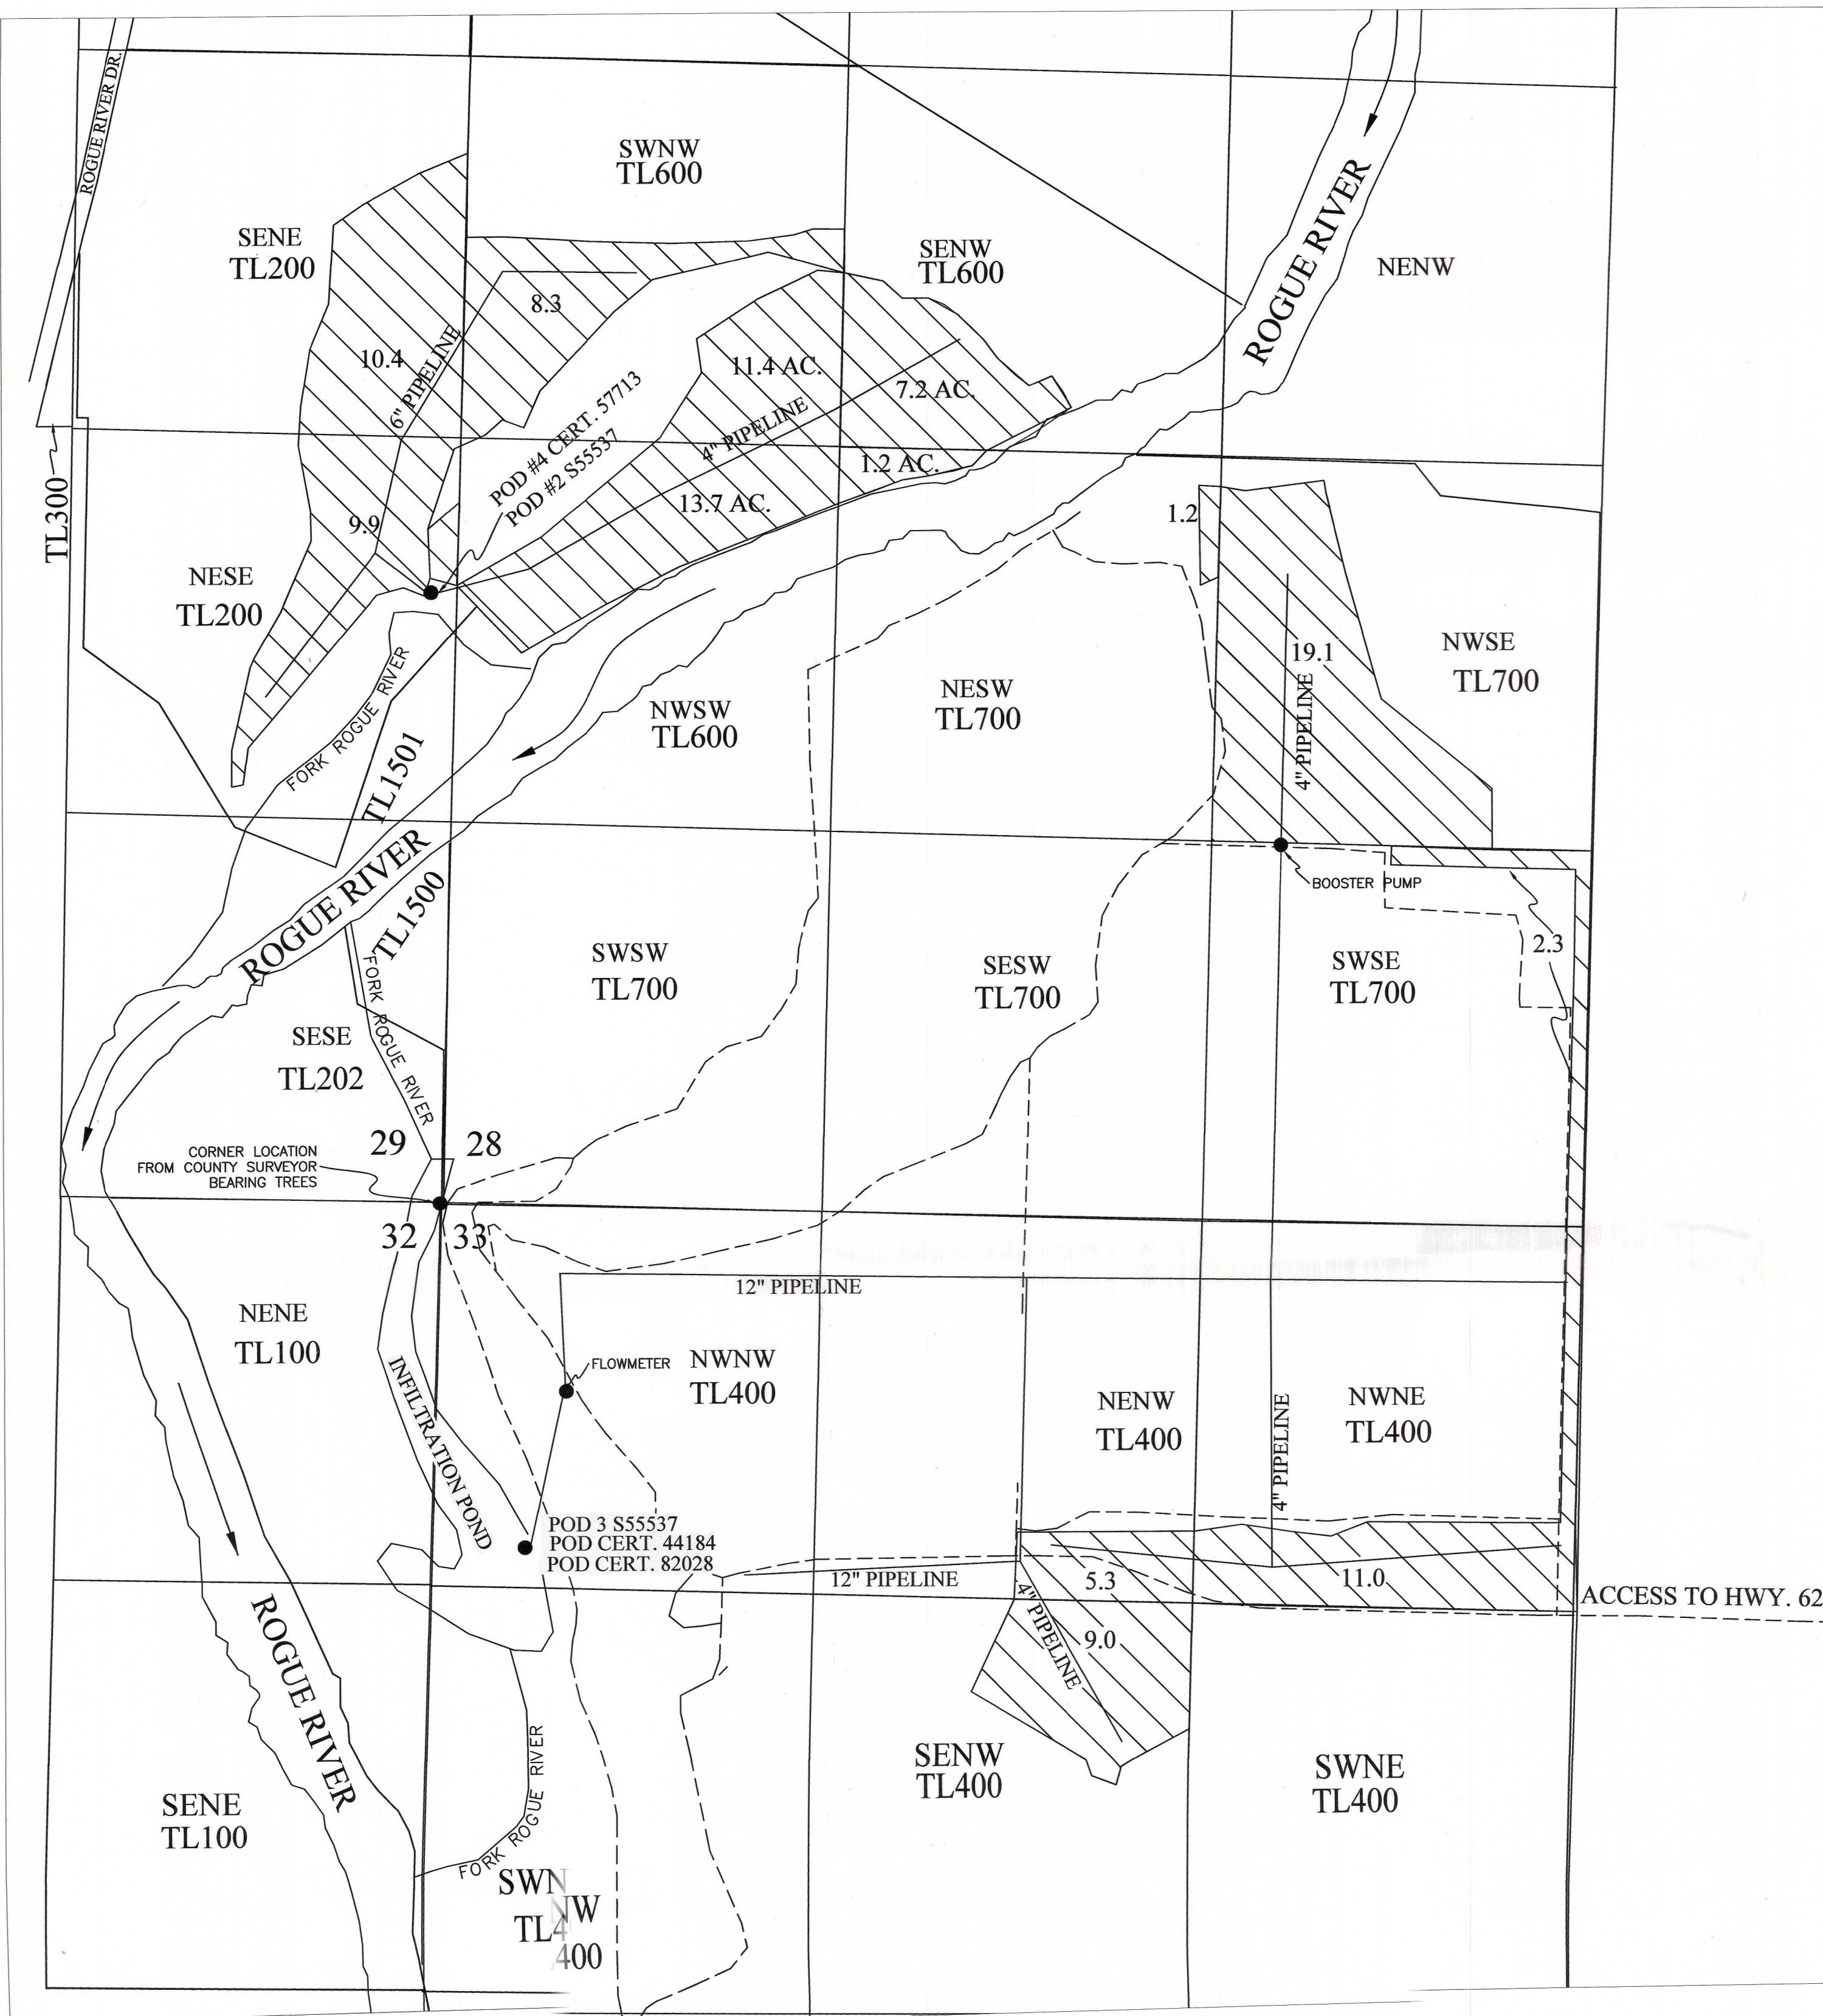

1"=400'

POU PERMIT S55537 PRIMARY IRRIGATION,
 62.10 ACRES AUTHORIZED PERMIT LOCATION
 SERVED BY POD 2 ONLY. FLOW METER AND
 FISH SCREEN LOCATED AT POD 2/4(57713)
 IS LOCATED FROM THE NE COR. S29
 SOUTH 3200 FT. & WEST 110 FT.
 N 42.58406852
 W 122.83654.226

POU PERMIT S55537 PRIMARY IRRIGATION,
 47.9 ACRES AUTHORIZED PERMIT LOCATION
 SERVED BY POD 3 ONLY. FISH SCREEN
 LOCATED AT POD 3
 POD 3 IS LOCATED FROM THE NW COR. S33
 SOUTH 1197 FT. & WEST 321 FT.
 N 42.57502996
 W 122.83501441

ROADS

Received
 JUL 06 2026
 OWRD

PREPARED FOR:
 DOUBLE R RANCH
 JOHN MCCAW JR.
 SHADY COVE, OREGON

PREPARED BY:
 SCOTT FEIN
 CERTIFIED WATER RIGHTS EXAMINER
 PROFESSIONAL LAND SURVEYOR
 ASHLAND, OREGON
 541-842-0795;
 SFEINSURVEYOR@GMAIL.COM



PLOT DATE: SEPTEMBER 30, 2025
 Rev. 5/26

FOR WATER RIGHTS PURPOSES ONLY
 NOT FOR PROPERTY BOUNDARY
 LOCATIONS OR DIMENSIONS