



Oregon Water Resources Department
725 Summer Street NE, Suite A
Salem, Oregon 97301
(503) 986-0900
www.oregon.gov/OWRD

Ownership Update for Certificated Rights Only

NO FEES ARE REQUIRED TO SUBMIT THIS FORM

NOTICE: A certificate of water right typically stays with the land. To track water right ownership, the Department requests that this form be submitted to the Department. **To update multiple rights, a separate form is required for each right.** If you have any questions about this form, please contact your local watermaster, or call the Water Resources Department at (503) 986-0900.

Note: Use the [assignment](#) form to change ownership on pending applications, permits, transfers, groundwater registrations, or limited licenses.

Current Landowner Information				
Name:	Tenisha Hoptowit			
Mailing Address:	5850 Lockett Rd			
City:	Huntington	State:	Oregon	Zip: 97907 97907
Phone:	503 930 3370	Email:	lazymoranch@gmail.com	

Property Information				
County:	Malheur	Township:	15	Range: 45 E Section: 16
Tax Lot #:				
Street Address of Water Right:	5850 Lockett Rd Huntington OR 97907			
Water Right Information				
Application:	R-25515 / R-1110			
Permit:	20045 20045			
Certificate:	Included a copy of certificate			
Are all the lands associated with this water right owned by the requestor? ☒ Yes ☐ No				
(If no, include a map showing the portion of the water right involved)				

Signature and Date		
Name of individual completing form:	Tenisha Hoptowit	
Phone or email:	(503) 930-3370 lazymoranch@gmail.com	Date: 7/14/26
Signature of requestor:		

The Department does not change names on water right certificates. This form will be placed in the file for future reference only. If mailed, the Department will not provide acknowledgment of receipt.

This form can be mailed to the address above or sent by email to wrd_dl_customerservice@water.oregon.gov

STATE OF OREGON
COUNTY OF MALHEUR
CERTIFICATE OF WATER RIGHT

This Is to Certify, That **BURTON D. OWENS**

of Box 3, Ontario, State of Oregon, has made proof to the satisfaction of the STATE ENGINEER of Oregon, of a right to the use of the waters of Birch Creek & reservoir constructed under App. No. R-25515, Per. No. R-1110 a tributary of Snake River for the purpose of irrigation under Permit No. 20045 of the State Engineer, and that said right to the use of said waters has been perfected in accordance with the laws of Oregon; that the priority of the right hereby confirmed dates from December 18, 1950

that the amount of water to which such right is entitled and hereby confirmed, for the purposes aforesaid, is limited to an amount actually beneficially used for said purposes, and shall not exceed 0.61 cubic foot per second

or its equivalent in case of rotation, measured at the point of diversion from the stream. The point of diversion is located in the NE $\frac{1}{4}$ SE $\frac{1}{4}$, Section 9, Township 15 South, Range 45 East, W. M. NE $\frac{1}{4}$ SW $\frac{1}{4}$, Section 16, Township 15 South, Range 45 East, W. M.

The amount of water used for irrigation, together with the amount secured under any other right existing for the same lands, shall be limited to one-fortieth of one cubic foot per second per acre, or its equivalent for each acre irrigated and shall be further limited to a diversion of not to exceed 3 acre feet per acre for each acre irrigated during the irrigation season of each year from direct flow and storage from reservoir constructed under Permit No. R-1110,

and shall conform to such reasonable rotation system as may be ordered by the proper state officer.

A description of the place of use under the right hereby confirmed, and to which such right is appurtenant, is as follows:

16.0 acres in the NE $\frac{1}{4}$ SE $\frac{1}{4}$
6.8 acres in the NW $\frac{1}{4}$ SE $\frac{1}{4}$
1.7 acres in the SW $\frac{1}{4}$ SE $\frac{1}{4}$

Section 9

Township 15 South, Range 45 East, W. M.

Land on which water is to be used is part of that described as follows:

That part of the SW $\frac{1}{4}$ of the NW $\frac{1}{4}$ of Section 4, that is situate West of Highway U. S. No. 30, otherwise known as Old Oregon Trail and that part of the SW $\frac{1}{4}$ of Section 4 that is situate West of Snake River; the S $\frac{1}{2}$ of the NE $\frac{1}{4}$, the SE $\frac{1}{4}$ of the NW $\frac{1}{4}$, the E $\frac{1}{2}$ of the SW $\frac{1}{4}$, and the SE $\frac{1}{4}$ of Sec. 4; the E $\frac{1}{2}$ of the W $\frac{1}{2}$ of and the E $\frac{1}{2}$ of Sec. 7; the W $\frac{1}{2}$ of the W $\frac{1}{2}$, the E $\frac{1}{2}$ of the NE $\frac{1}{4}$ and the NW $\frac{1}{4}$ of the NE $\frac{1}{4}$ of Sec. 8; that part of the N $\frac{1}{2}$ of NE $\frac{1}{4}$ of Sec. 9 situate West of Snake River; the NW $\frac{1}{4}$, the N $\frac{1}{2}$ of the SE $\frac{1}{4}$ and the SW $\frac{1}{4}$ of the SE $\frac{1}{4}$ Sec. 9; the W $\frac{1}{2}$ of the NE $\frac{1}{4}$, and the E $\frac{1}{2}$ of the NW $\frac{1}{4}$ of Sec. 16: all in T. 15 S., R. 45 E., W. M., in Malheur County, Oregon.

The right to the use of the water for the purposes aforesaid is restricted to the lands or place of use herein described.


WITNESS the signature of the State Engineer, affixed

this 28th day of November, 1956.

LEWIS A. STANLEY

State Engineer

T.15 S. R. 45 E. W.M.

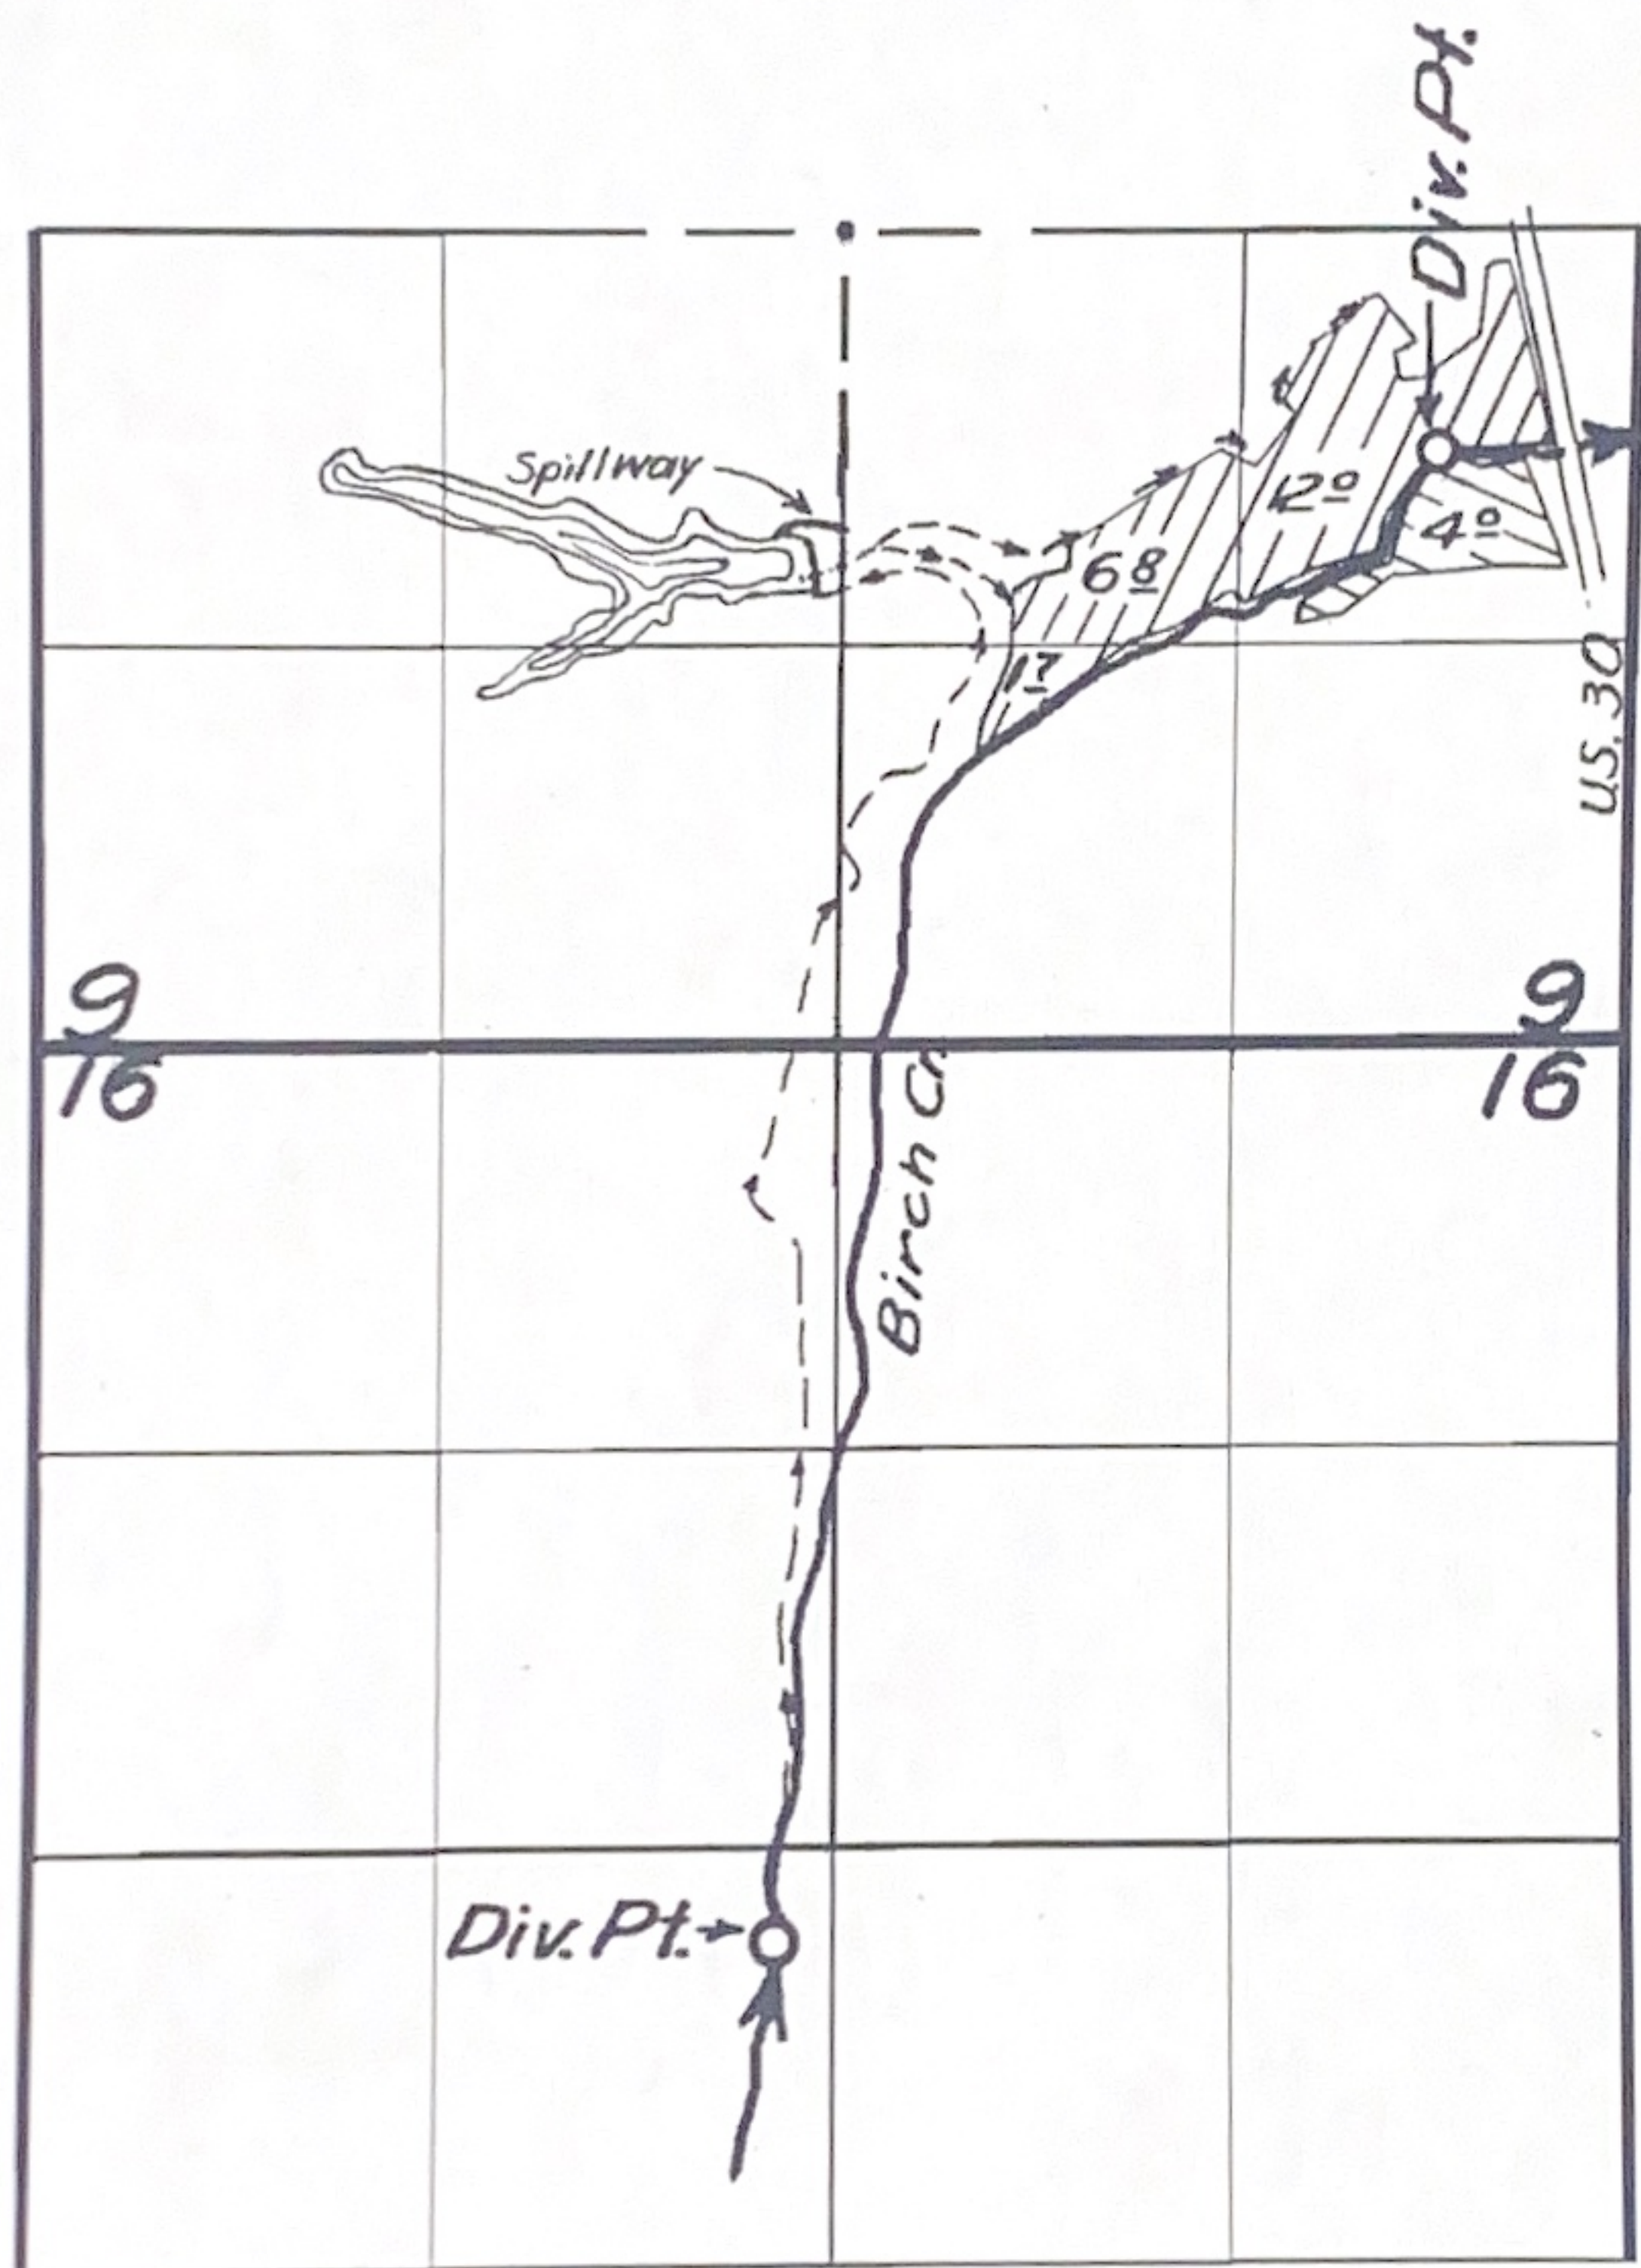

FINAL PROOF SURVEY

UNDER

R-25515

R-1110

Application No. 25516 Permit No. 20045

IN NAME OF

Burton D. Owens

Surveyed Oct. 30 1955, by M. Bish

1955N