


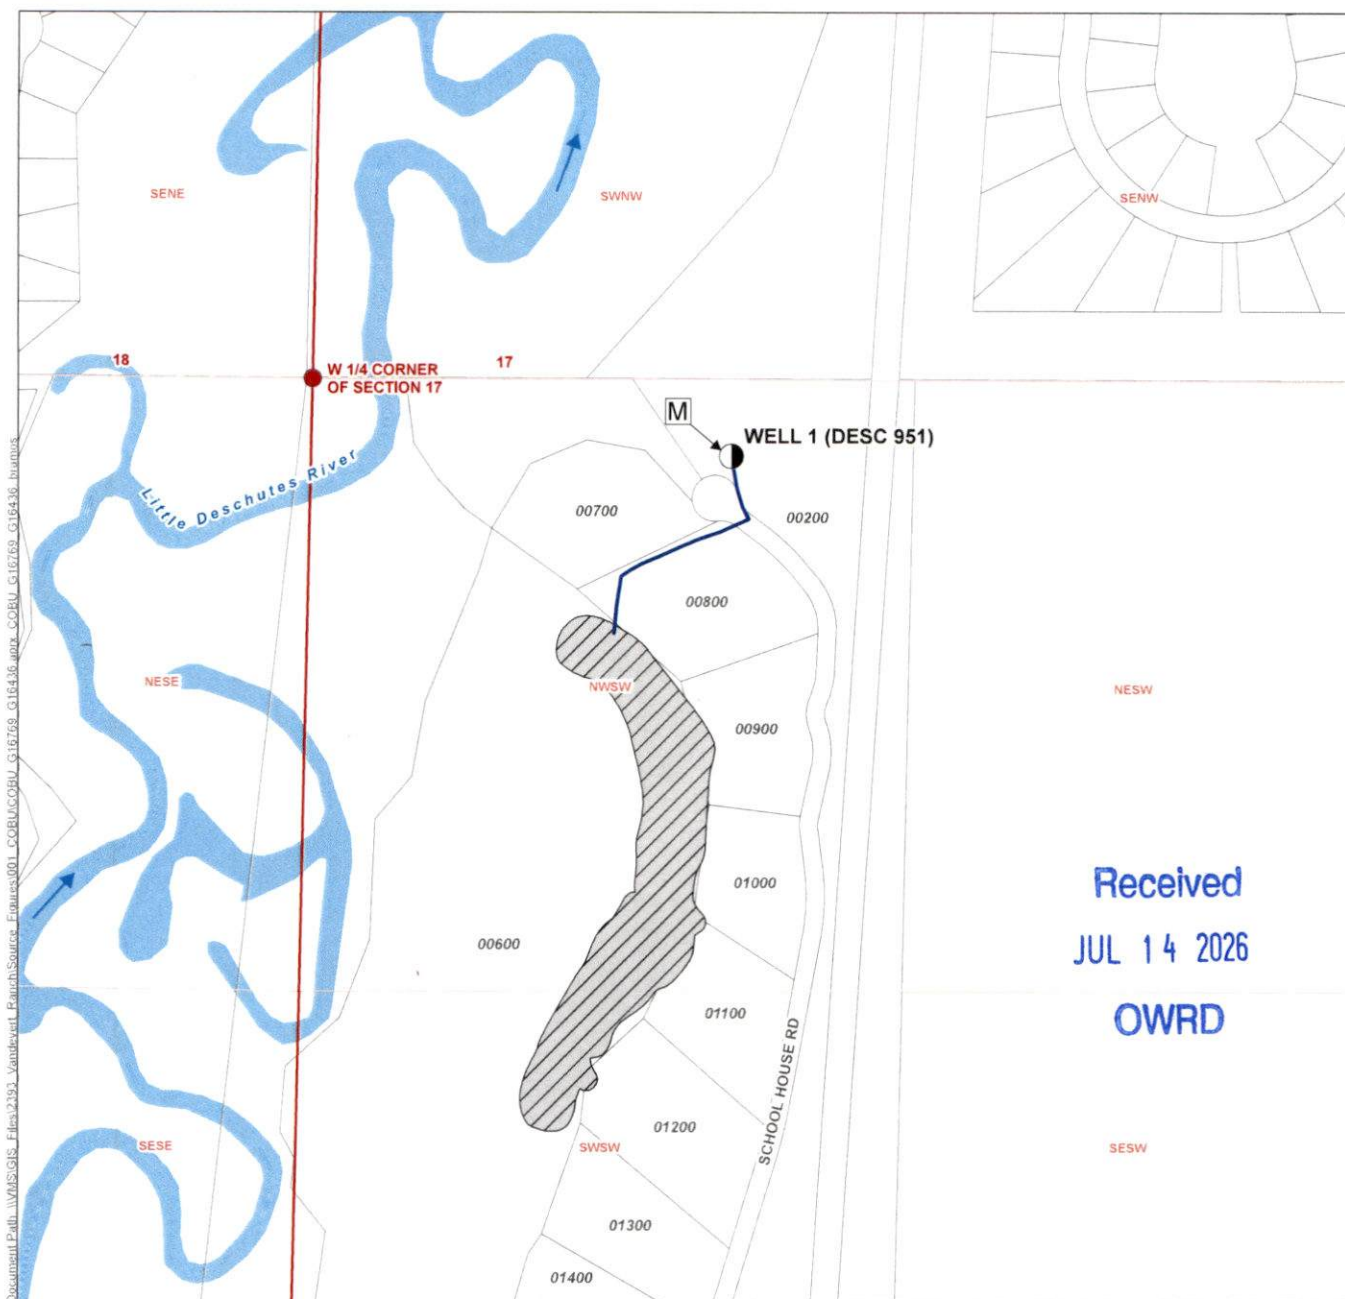

Received
JUL 14 2026
OWRD

LEGEND

- Point of Appropriation (POA)
- Meter
- Conveyance Line
- Place of Use (POU) - 4.19 ac.

All Other Features

- Watercourse
- Waterbody

Claim of Beneficial Use Map Vandevent Ranch Association

Application G-16769, Permit G-16436

Township 20 South, Range 11 East (W.M.), Section 17

CERTIFIED WATER RIGHTS EXAMINER STAMP



LOCATION DESCRIPTION

Well 1 (DESC 951)
Located 160 feet South and 822 feet East from the W 1/4 corner of Section 17, Township 20 South, Range 11 East (W.M.)
X: 43.8408188, Y: -121.4429035 (WGS84)
Meter
Located on conveyance piping at the wellhead.

DISCLAIMER
This map was prepared for the purpose of identifying the location of a water right only and it is not intended to provide legal dimensions or location of property ownership lines.

Date: May 29, 2026
Data Sources: BLM, ESRI, OWRD, USGS

