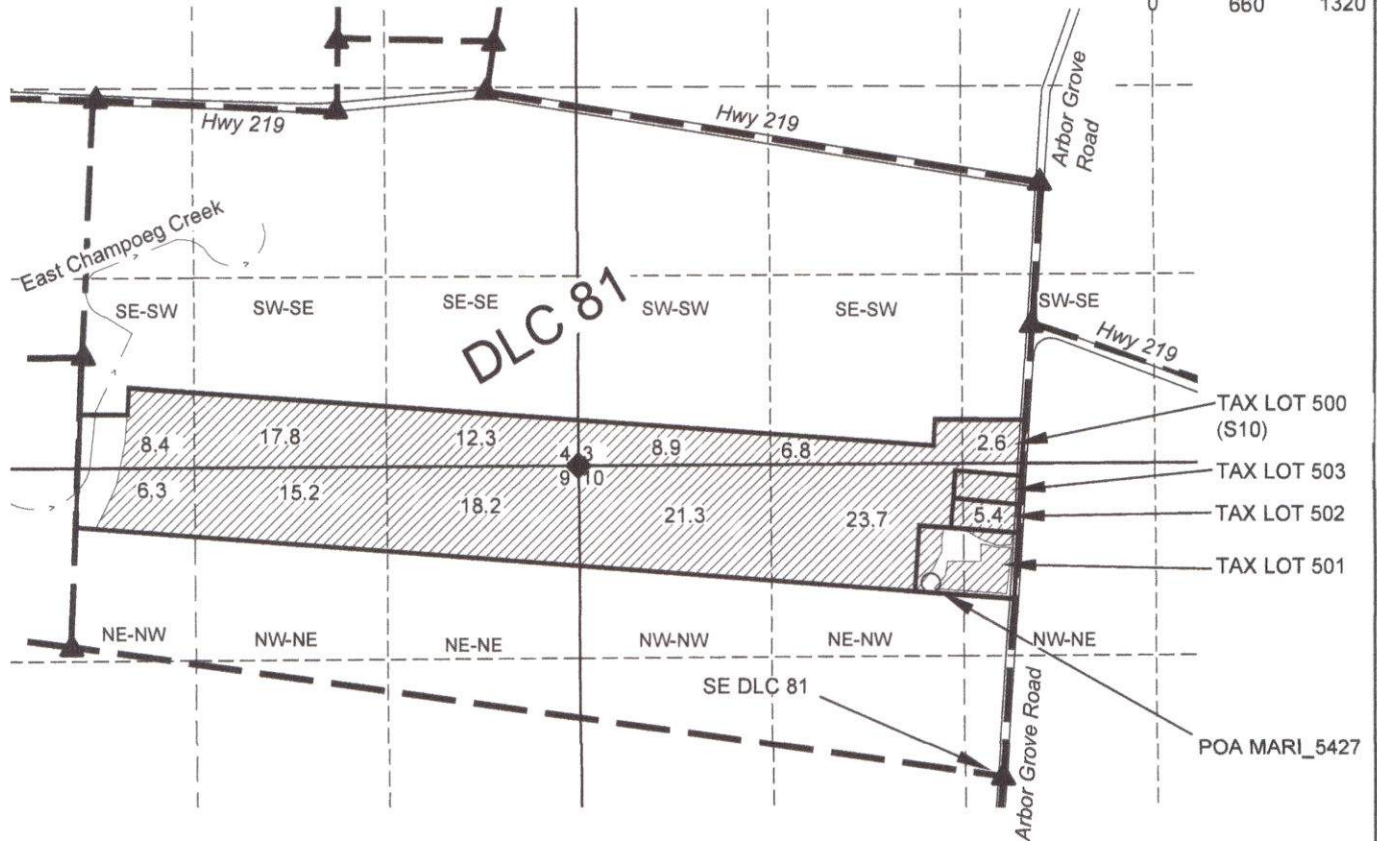


Map For

Claim of Beneficial Use

Sections 3, 4, 9, 10, T5S, R2W, Marion County
Transfer T-143251 IN = 1320 FT
0 660 1320**LOCATION OF POA (WELL)**

1308' N & 444' W OF SE DLC 81 (PER CERTIFICATE 95641) AND 45.156232° N, 122.919842° W, WGS84.

NOTES:

- THE NORTH BOUNDARY OF TAX LOT 500 (S10) HAS BEEN ADJUSTED AND IS THE MAIN REASON FOR THIS PLACE OF USE CHANGE.
- THIS MAP IS NOT INTENDED TO PROVIDE LEGAL DIMENSIONS OR LOCATIONS OF PROPERTY OWNERSHIP LINES.
- PROPERTY, QUARTER-QUARTER, AND DLC LINES ARE BASED ON PARTITION 2021-095 AND THE TAX ASSESSOR MAPS FOR SECTIONS 3, 4, 9, & 10, T5S, R2W.
- WATER CONVEYANCE LINES SHALL BE ALL WITHIN THE PROPERTY AND THEREFORE ARE NOT SHOWN.

LEGEND

- DONATION LAND CLAIM (DLC) CORNER
- SECTION CORNER
- POINT OF APPROPRIATION (POA)
- STREAM OR SURFACE DRAINAGE
- TAX LOT LINE
- SECTION LINE
- QUARTER-QUARTER LINE
- DLC LINE
- IRRIGATION

Received

JUL 14 2026

OWRD



Exp. 30 JUN 2028

MAP BY:
**ASPEN RURAL LAND
CONSULTING**

ERIC URSTADT, PE, PLS

971-250-1520

JUN 2026

BlueSky-WoodburnWest5B