

~~Permit No.~~

WATER RIGHT APPLICATION MAP

T. 30/31 S., R. 15 W., W. M.

69194
"Continental".

APPLICANT:

CITY OF PORT ORFORD
P.O. BOX 310
PORTORFORD, OR
97465

SURVEYED BY:

HGE, INC.
375 PARK AVE.
COOS BAY, OR 97420

MAPPING DATE:

JANUARY 25, 1994

NOTE:

THIS MAP IS FOR THE
PURPOSE OF IDENTIFYING
THE LOCATION OF THE
WATER RIGHT ONLY.

Klooguh
Rock

Certified Water Right Examiner
#041

Russ S. Dodge

Russ S. Dodge
Nov. 19, 1987

STATE OF OREGON

LEGEND

- CITY LIMITS
 --- EXISTING WATER LINE
 --- RAW WATER LINE
 ■ PUMP STATION
 ▲ BOOSTER PUMP FOR
 SMALL RESIDENTIAL AREA

POINT OF
DIVERSION
HUBBARD CREEK
IMPOUNDMENT


 $1'' = 1000'$

ENGINEERS & PLANNERS
375 PARK AVE /COOS BAY OR 97420
19 N W FIFTH ST /PORTLAND OR 97209

RECEIVED
AUG - 2 1994
WATER RESOURCES
SALMON DIVISION

Application No. 14399
Permit No.

PACIFIC OCEAN


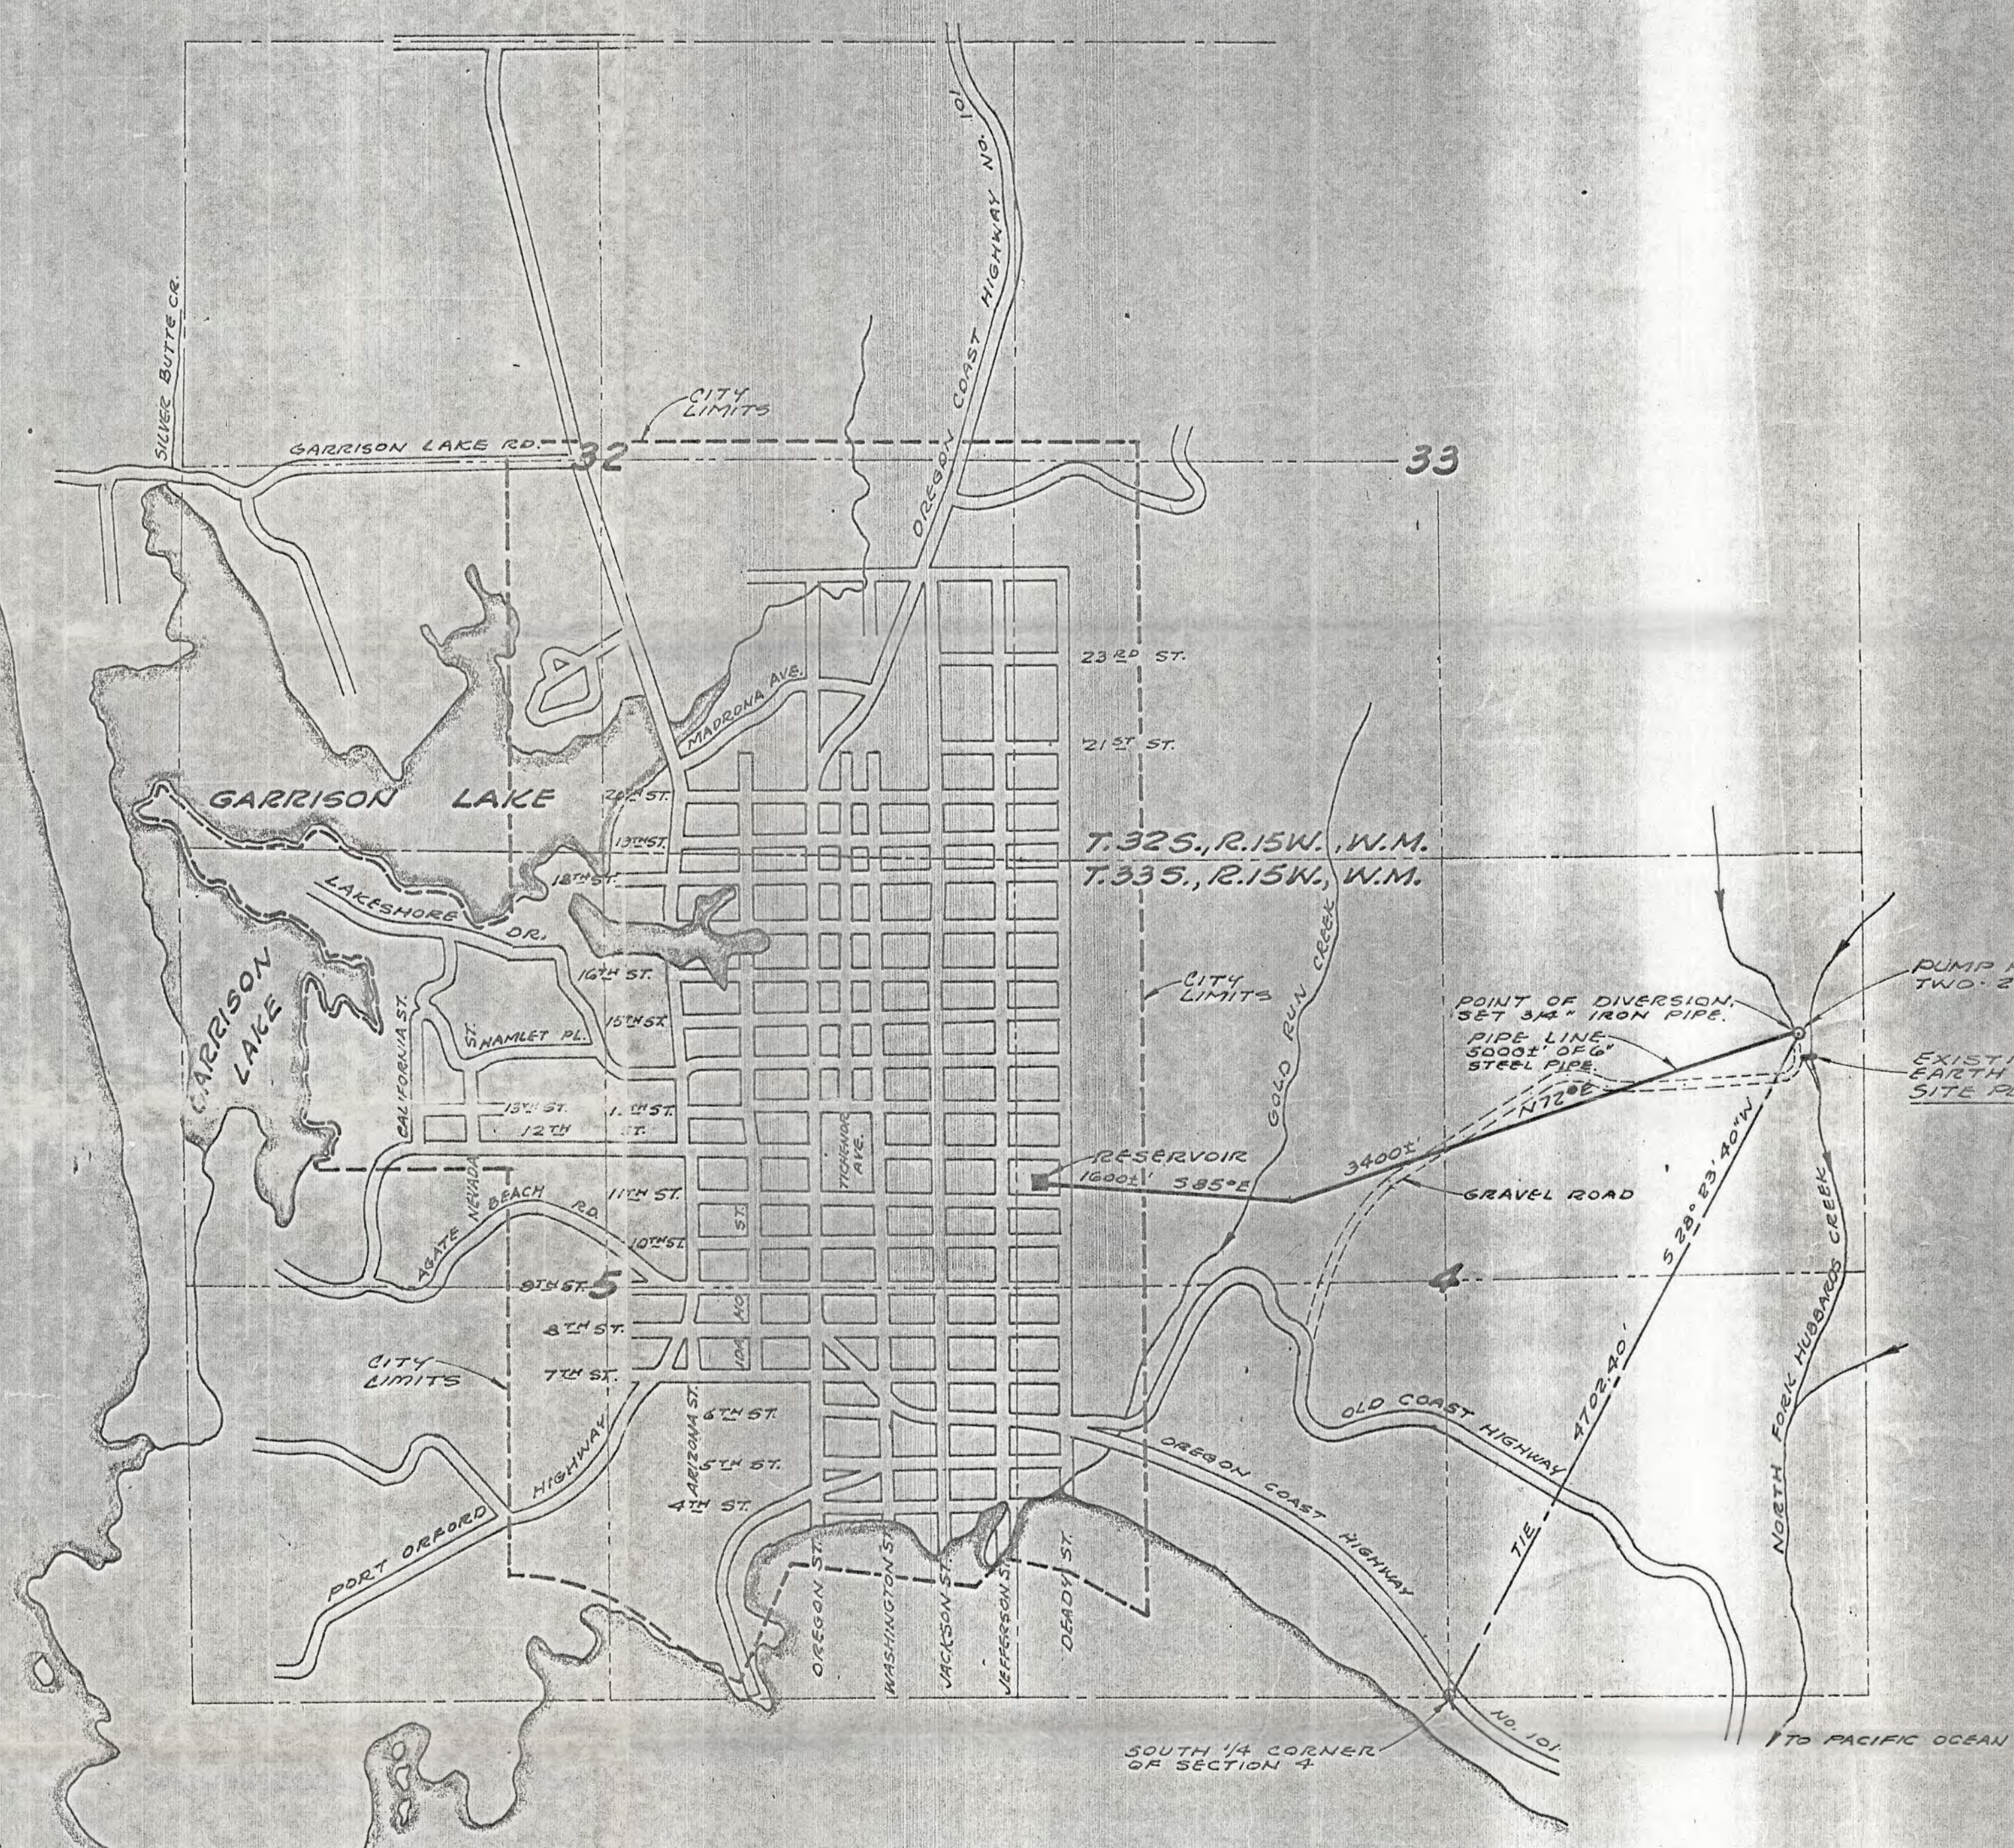


PACIFIC OCEAN


WATER RIGHTS SURVEY
FOR
CITY OF PORT ORFORD, OREGON
SECTIONS 32 AND 33, TOWNSHIP 32 SOUTH, RANGE 15
WEST, W.M. AND SECTIONS 4 AND 5, TOWNSHIP 33
SOUTH, RANGE 15 WEST, W.M., CURRY COUNTY, OREGON.
SCALE: 1" = 800' FEBRUARY, 1968.

REGISTERED
OREGON
LAND SURVEYOR
Robert W. Wade
OCTOBER 4, 1967
433

EXISTING PUMP HOUSE
2 PUMPS EACH
WITH 20 H.P.
MOTOR
6" STEEL PIPE LINE
TO EXISTING RESERVOIR
INTAKE PIPES
POINT OF DIVERSION
SET 3/4" IRON PIPE

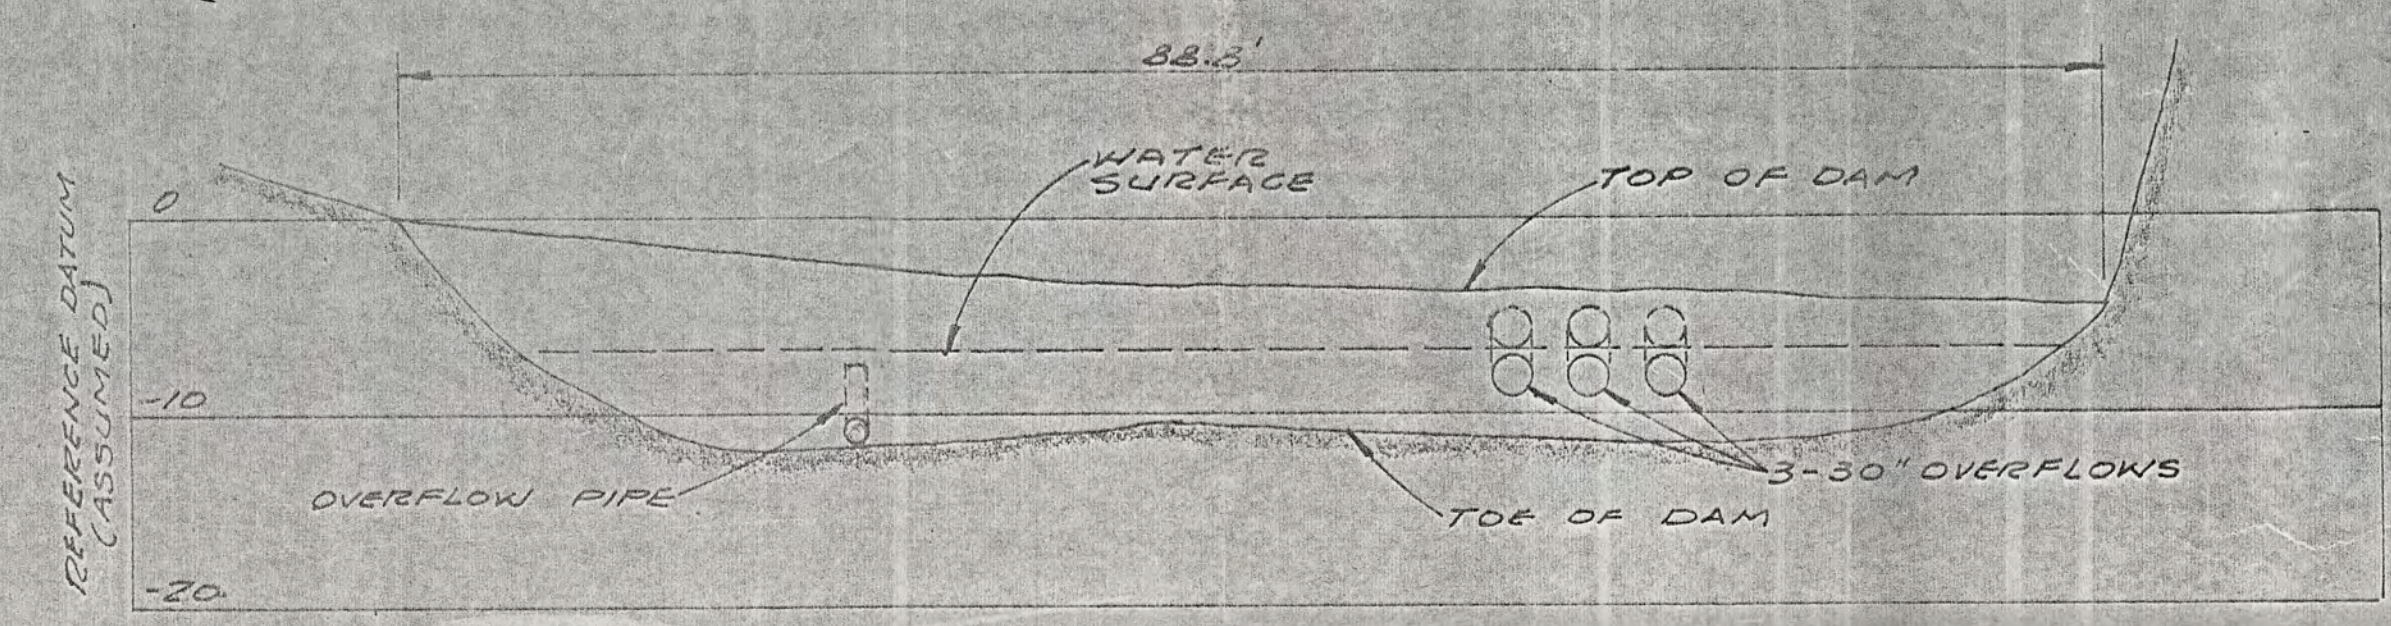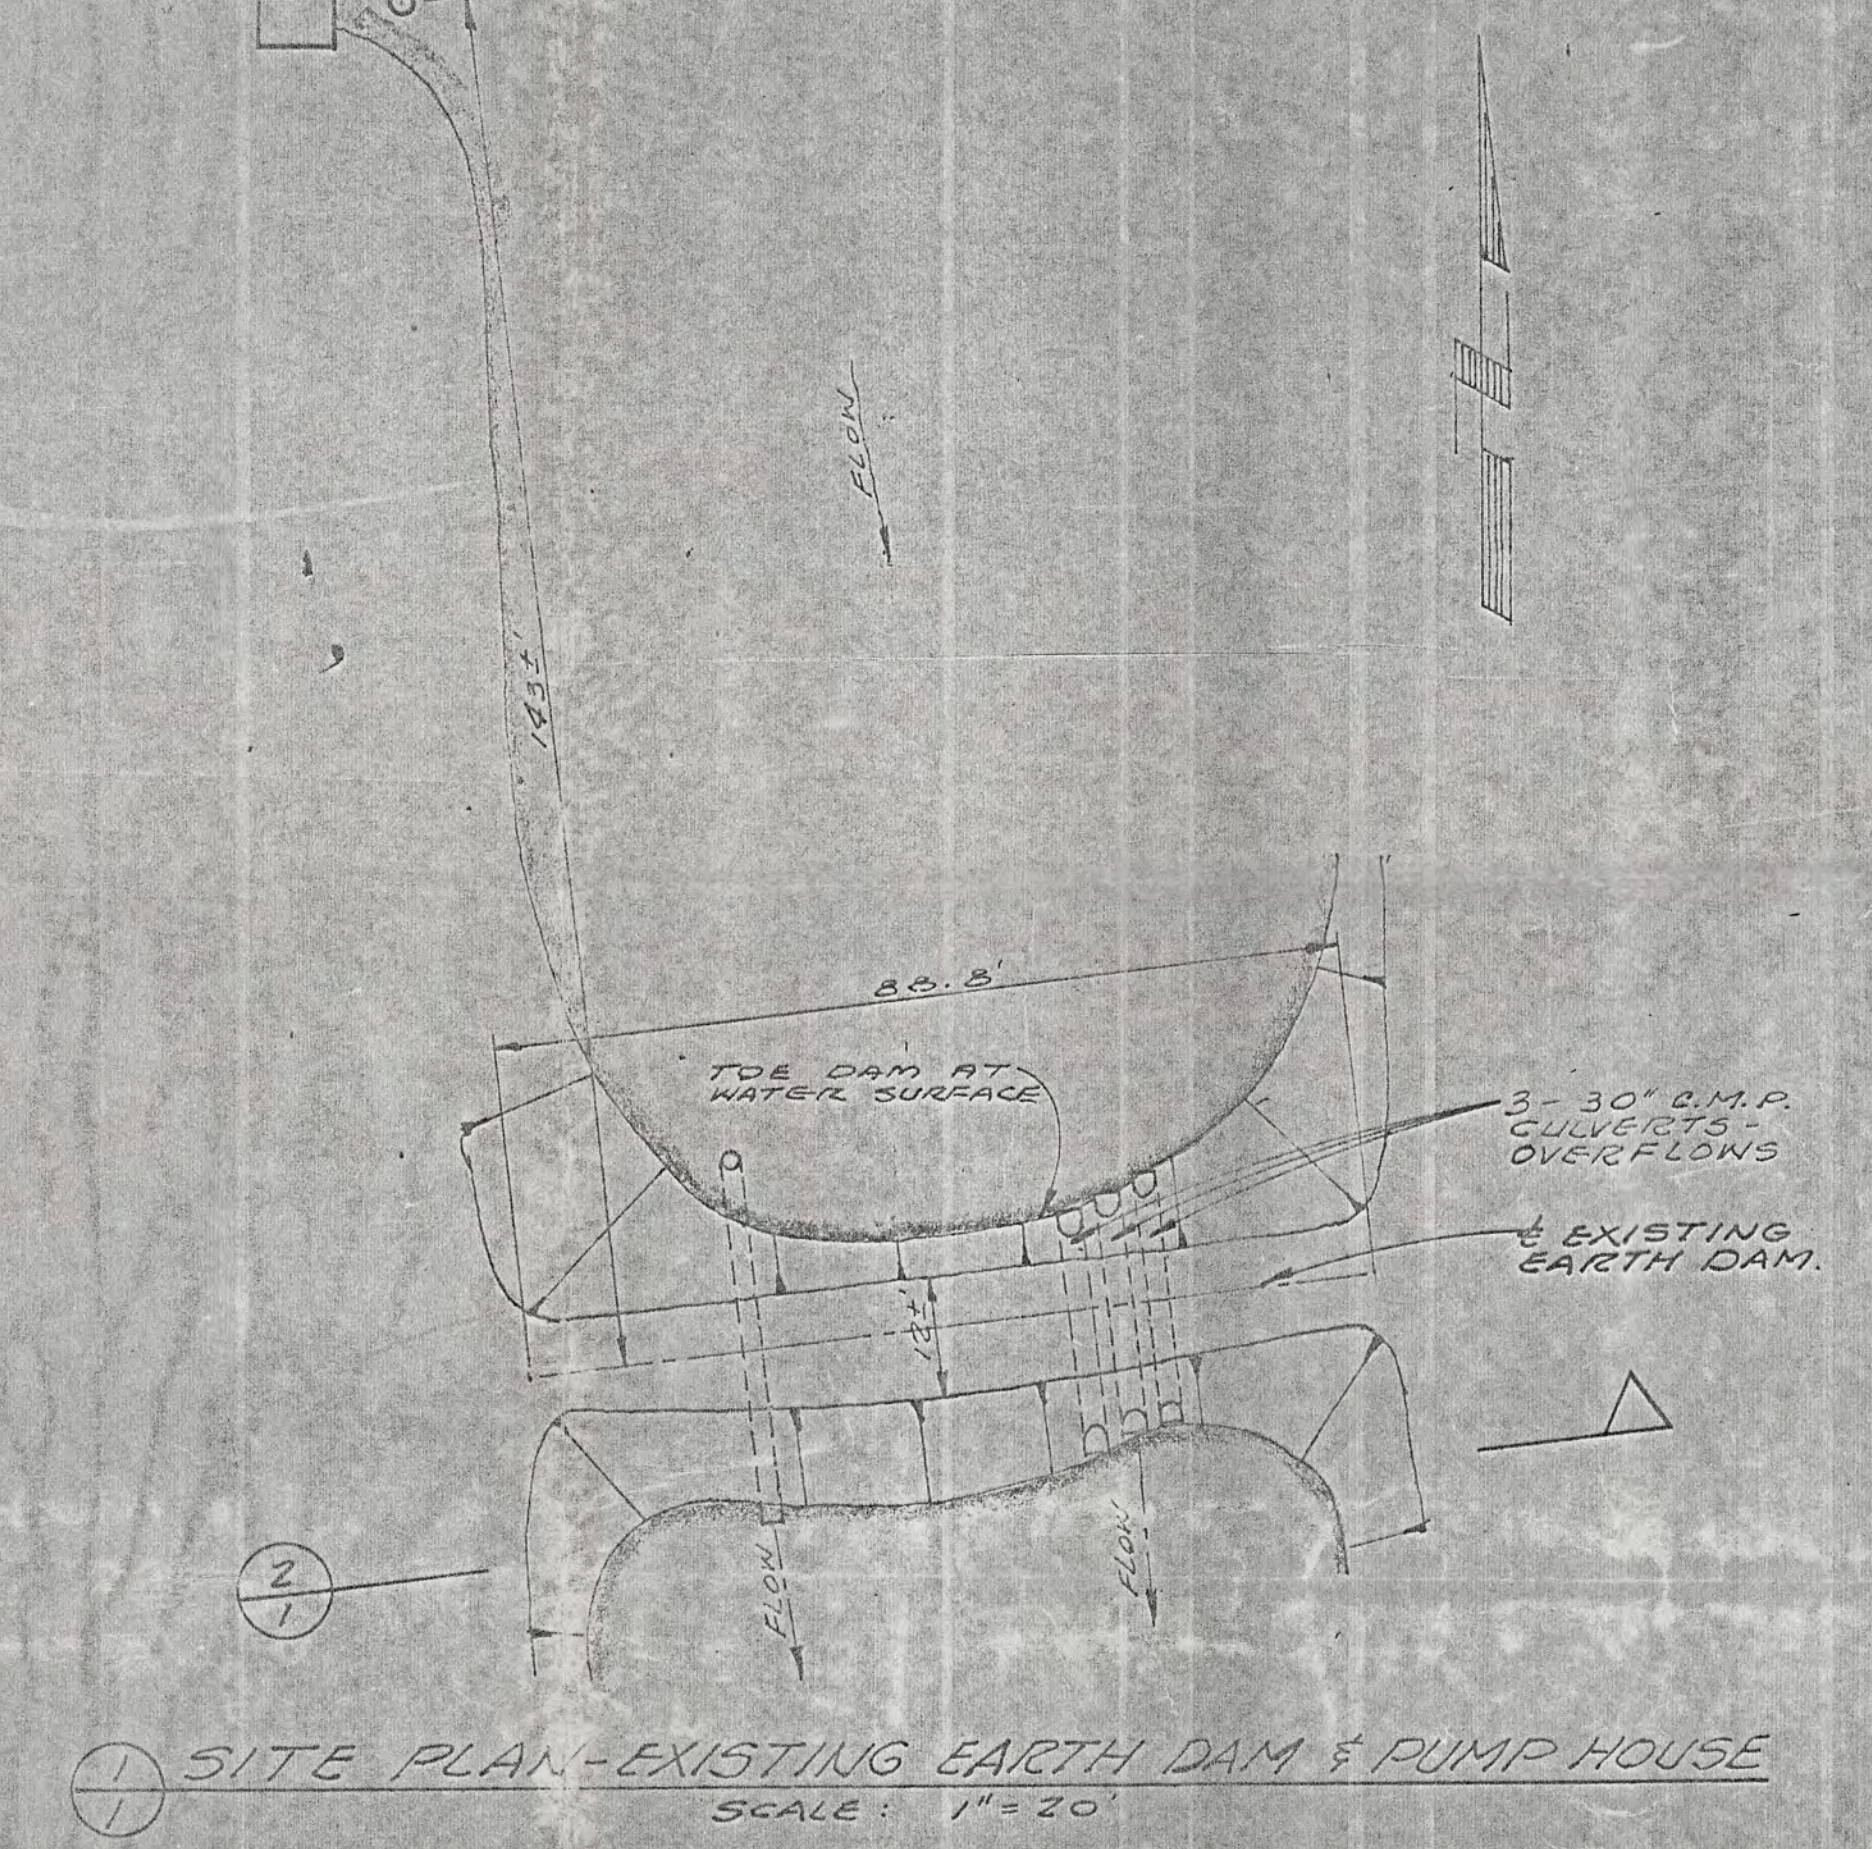

2 FRONT ELEVATION-EXISTING EARTH DAM
HOR. & VERT. SCALES: 1" = 10'

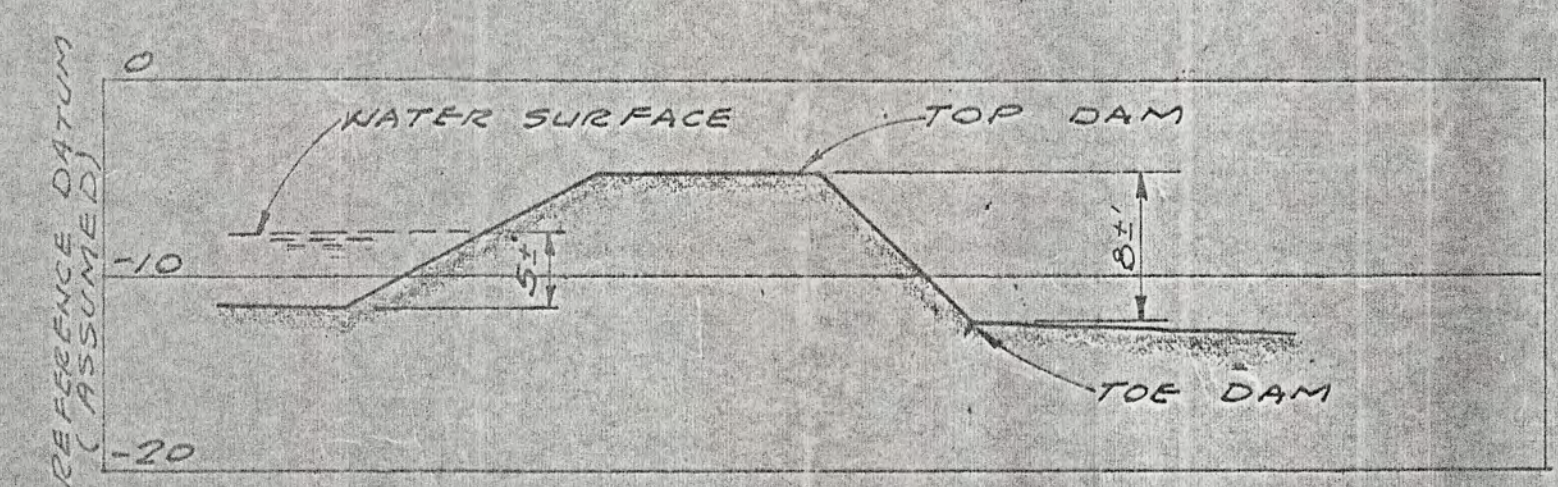

SECTION-EXISTING EARTH DAM
HOR. & VERT. SCALES: 1" = 10'