


EAST BLUFF


IN THE S.W. 1/4 OF SEC. 5, T.18 S.,
R.12 E., W.M., DESCHUTES COUNTY,
OREGON.

AVION WATER CO. INC.
7-8-80

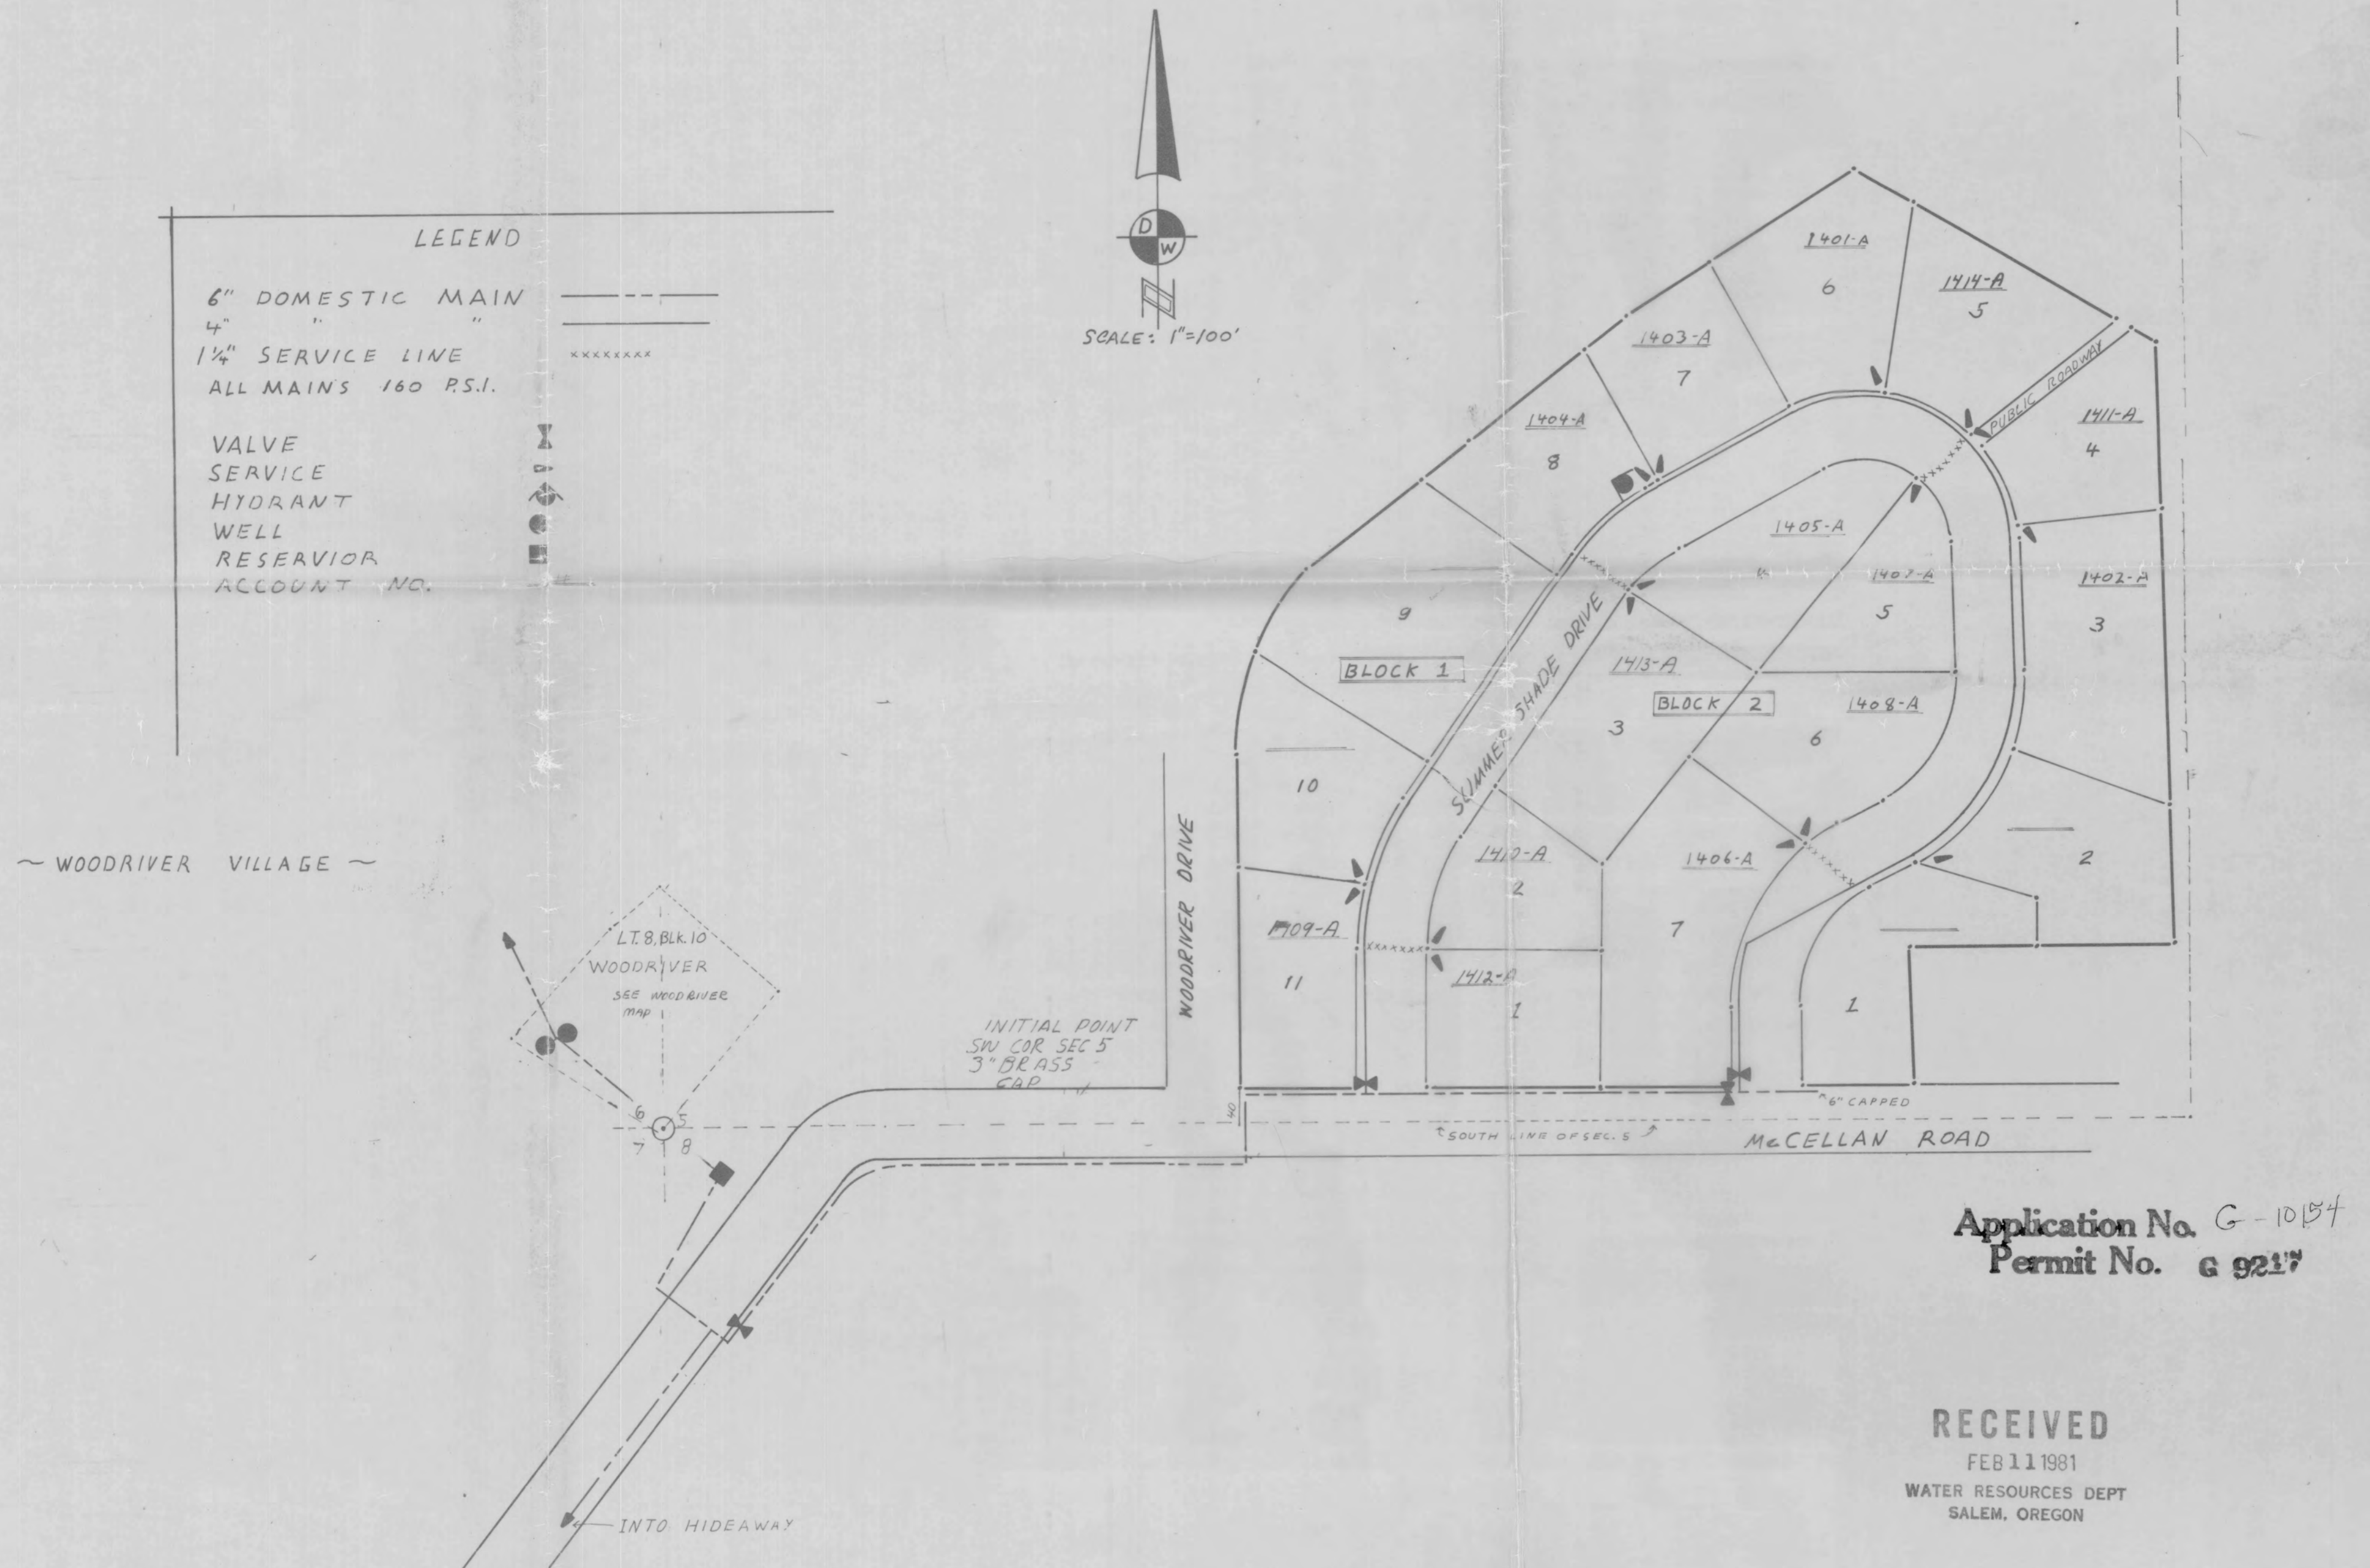

HIDE-AWAY

LOCATED IN THE NE 1/4 NE 1/4 OF SEC 7, T18S, R12E, W.M., Deschutes County

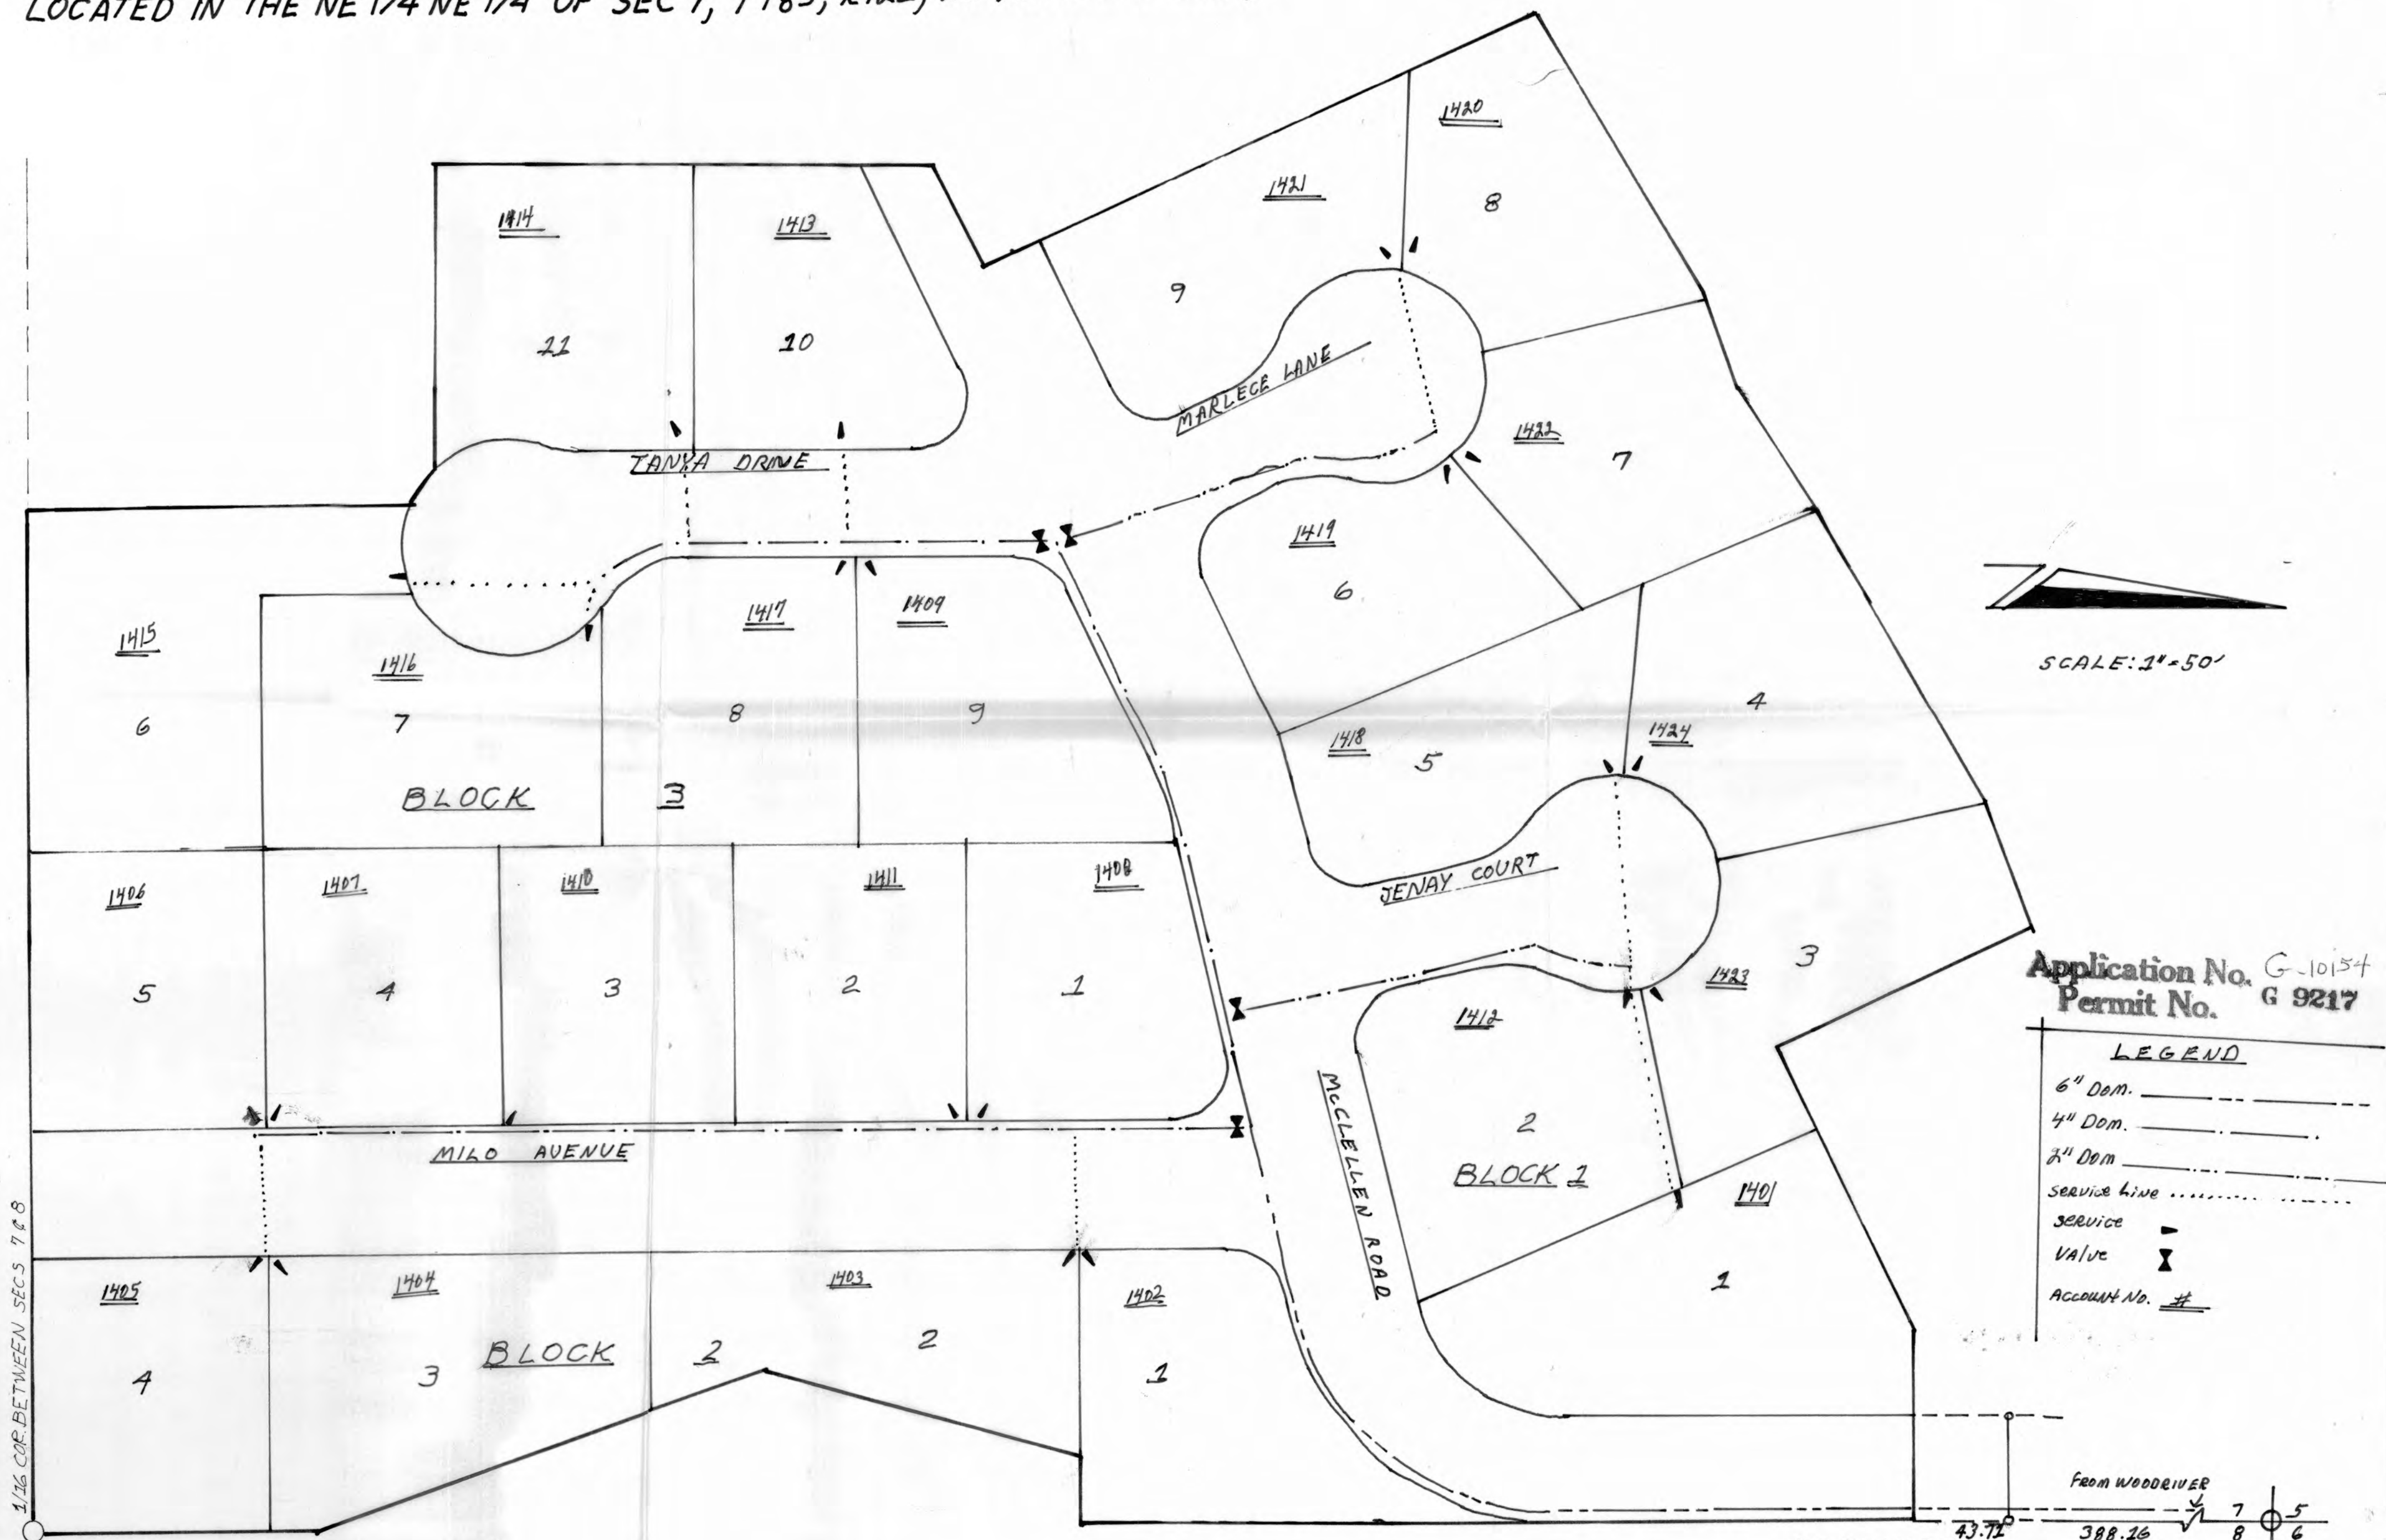

6" Domestic

4" Domestic

1 1/4" Service Line

VALVE

HYDRANT


SERVICE

ACCOUNT No.

BLOWOFF

2" Domestic

Woodriver Village

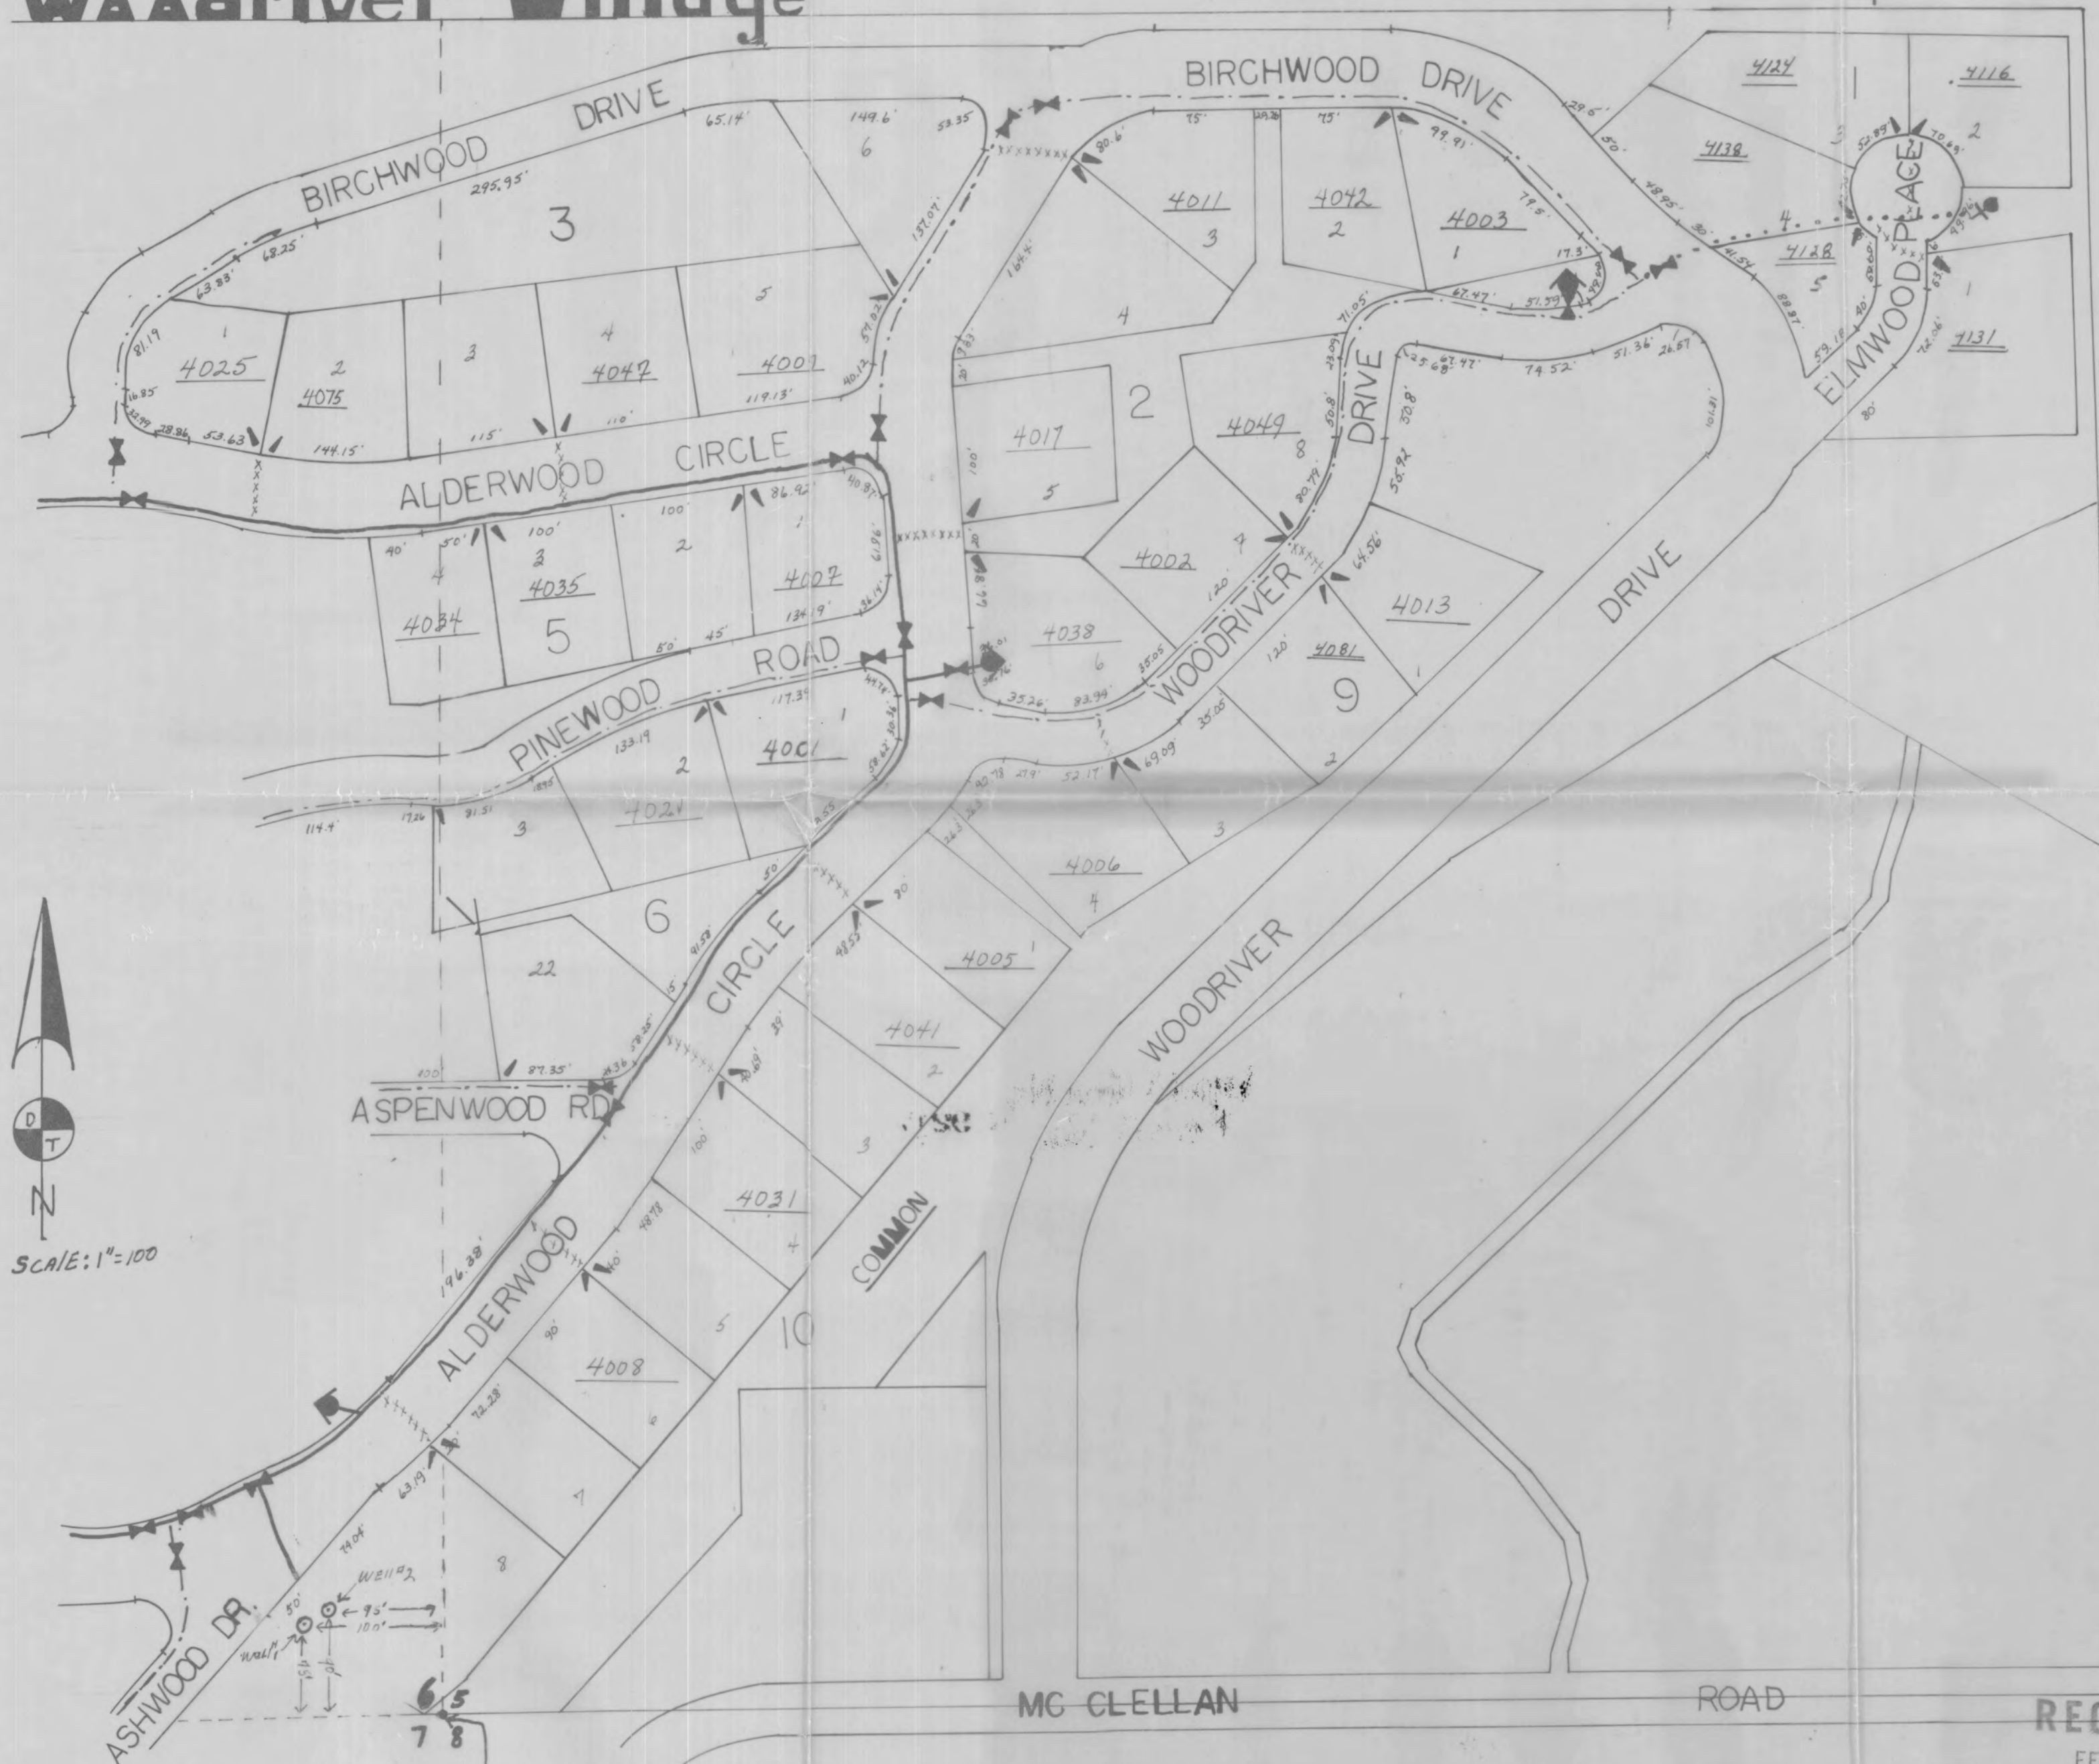

POINT OF BEGINNING INITIAL POINT
2 1/2 BRASS AP
T.18S. R.12E. W.M.

RECEIVED

FEB 11 1981

WATER RESOURCES DEPT
SALEM, OREGON

Application No.
Permit No.

G 10154
G 9217

AVION WATER CO.
11-13-80

NE1/4 NE1/4 SEC. 7 T.18S. R.12E.W.M.

Wood River Village

LEGEND

4" Domestic

2" Domestic

1/4" service Line

VALVE

HYDRANT

SERVICE

ACCOUNT NO.

SHOWOFF

Scale 1" = 100'




RECEIVED

FEB 11 1981

WATER RESOURCES DEPT.
SALEM, OREGON

Application No. G-10154
Permit No. G-9217

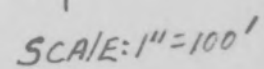


T. 18S. R. 12E. W. 12.

FEB 11 1981

Application No. G-10154 FEB 11 1981
Permit No. G 9217-9218 WATER RESOURCES DEPT
SALEM, OREGON

HIDE-AWAY

LOCATED IN THE NE 1/4 NE 1/4 OF SEC 7, T18S, R12E, W.M., Deschutes County

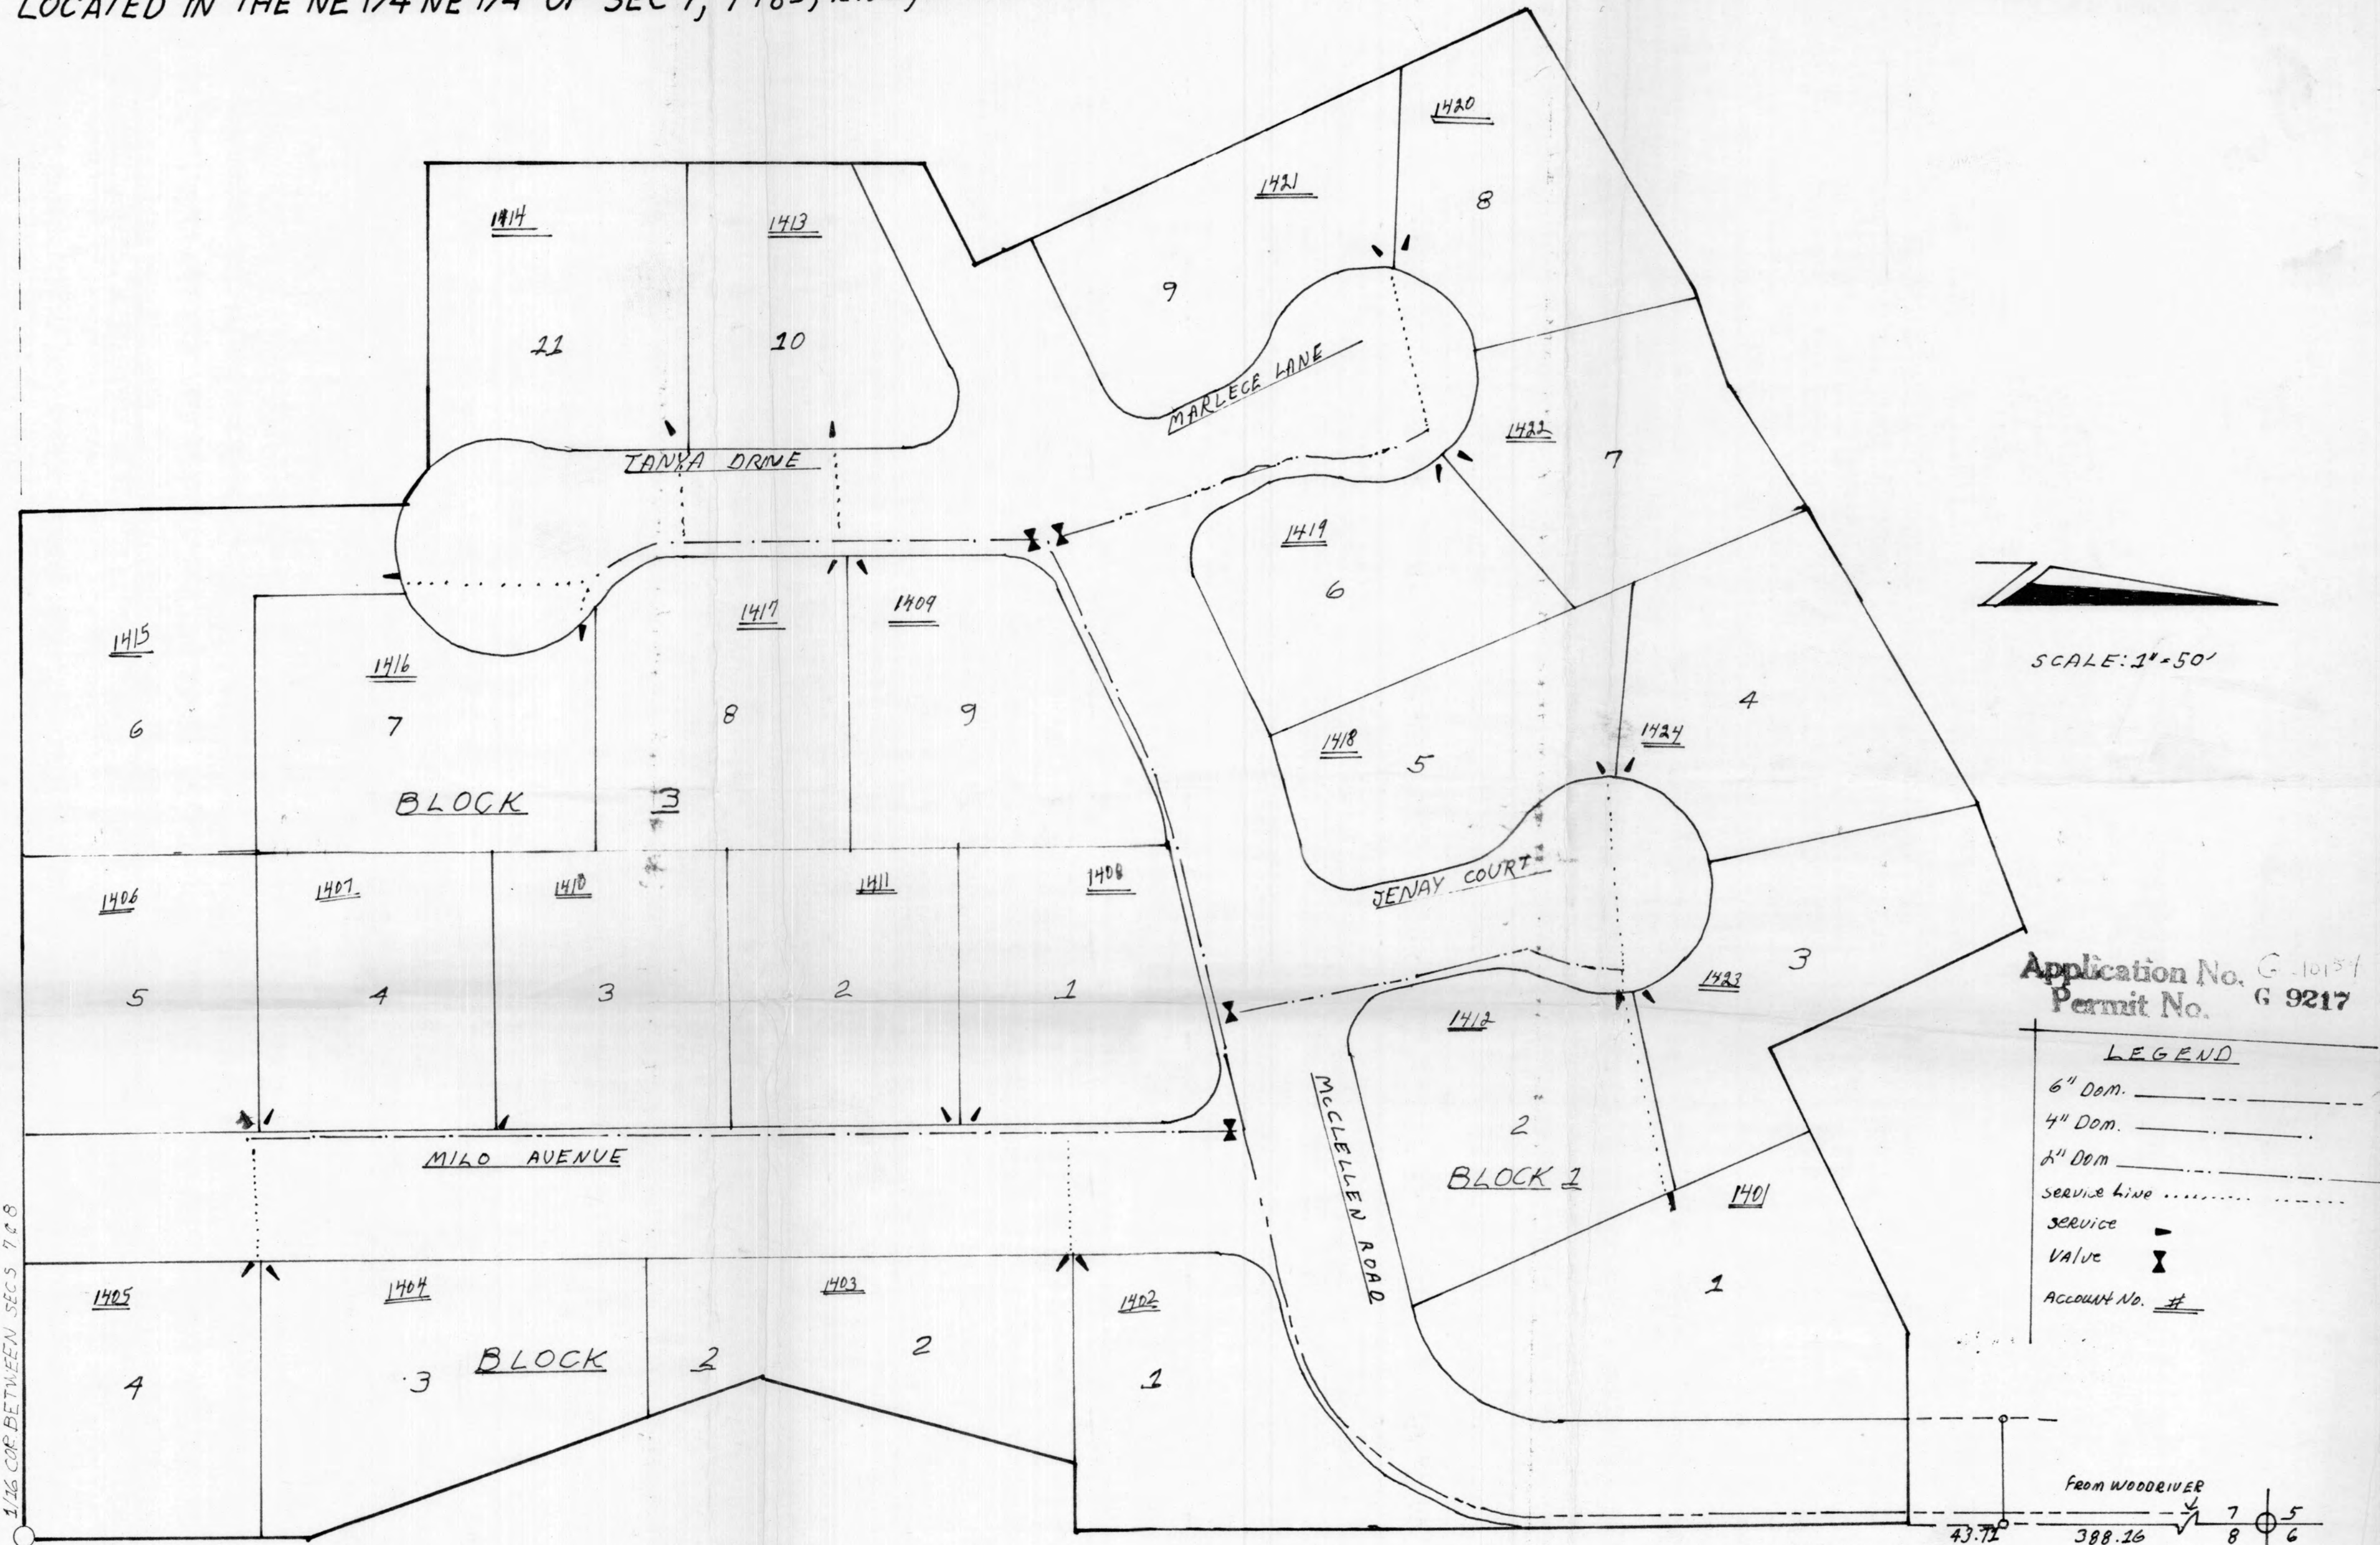

RECEIVED
FEB 11 1991
WATER RESOURCES DEPT
SALEM, OREGON

EAST BLUFF

IN THE S.W. 1/4 OF SEC. 5, T.18 S.,
R.12 E., W.M., DESCHUTES COUNTY,
OREGON.

AVION WATER CO. INC.


7-8-80

LEGEND

6" DOMESTIC MAIN
4" "


1 1/4" SERVICE LINE
ALL MAINS 160 P.S.I.

VALVE
SERVICE
HYDRANT
WELL
RESERVIOR
ACCOUNT NO.

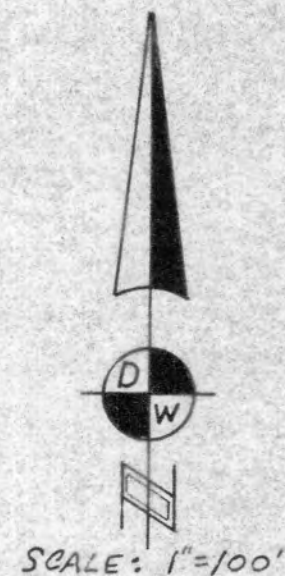

SCALE: 1"=100'

~ WOODRIVER VILLAGE ~

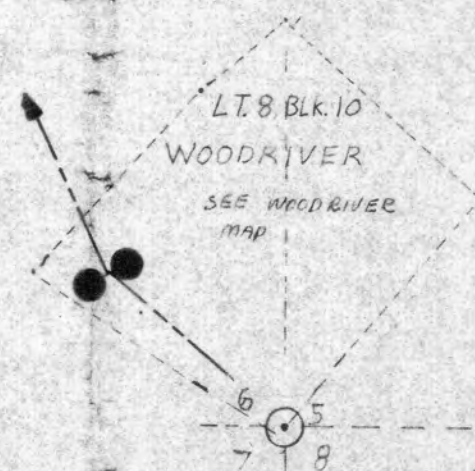

INITIAL POINT
SW COR SEC 5
3" BRASS
CAP

WOODRIVER DRIVE

SUMMER SHADE DRIVE

BLOCK 1

BLOCK 2

SOUTH LINE OF SEC. 5

McCELLAN ROAD

Application No. G-10154
Permit No. G 9217

RECEIVED

FEB 11 1981
WATER RESOURCES DEPT
SALEM, OREGON


INTO HIDEAWAY

AVION WATER CO.
11-13-80


NE1/4 NE1/4 SEC. 7 T.18S. R.12E.W.11.

Wood River Village

LEGEND
4" Domestic
2" Domestic
1/4" service Line
VALVE
HYDRANT
SERVICE
ACCOUNT NO. #
GLOWOFF #
T.18S. R.12E. W.11.

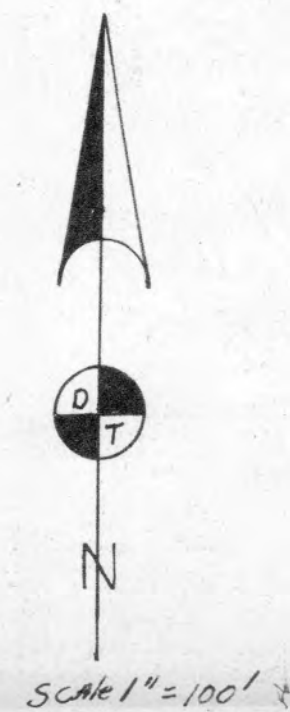

DESCHUTES RIVER

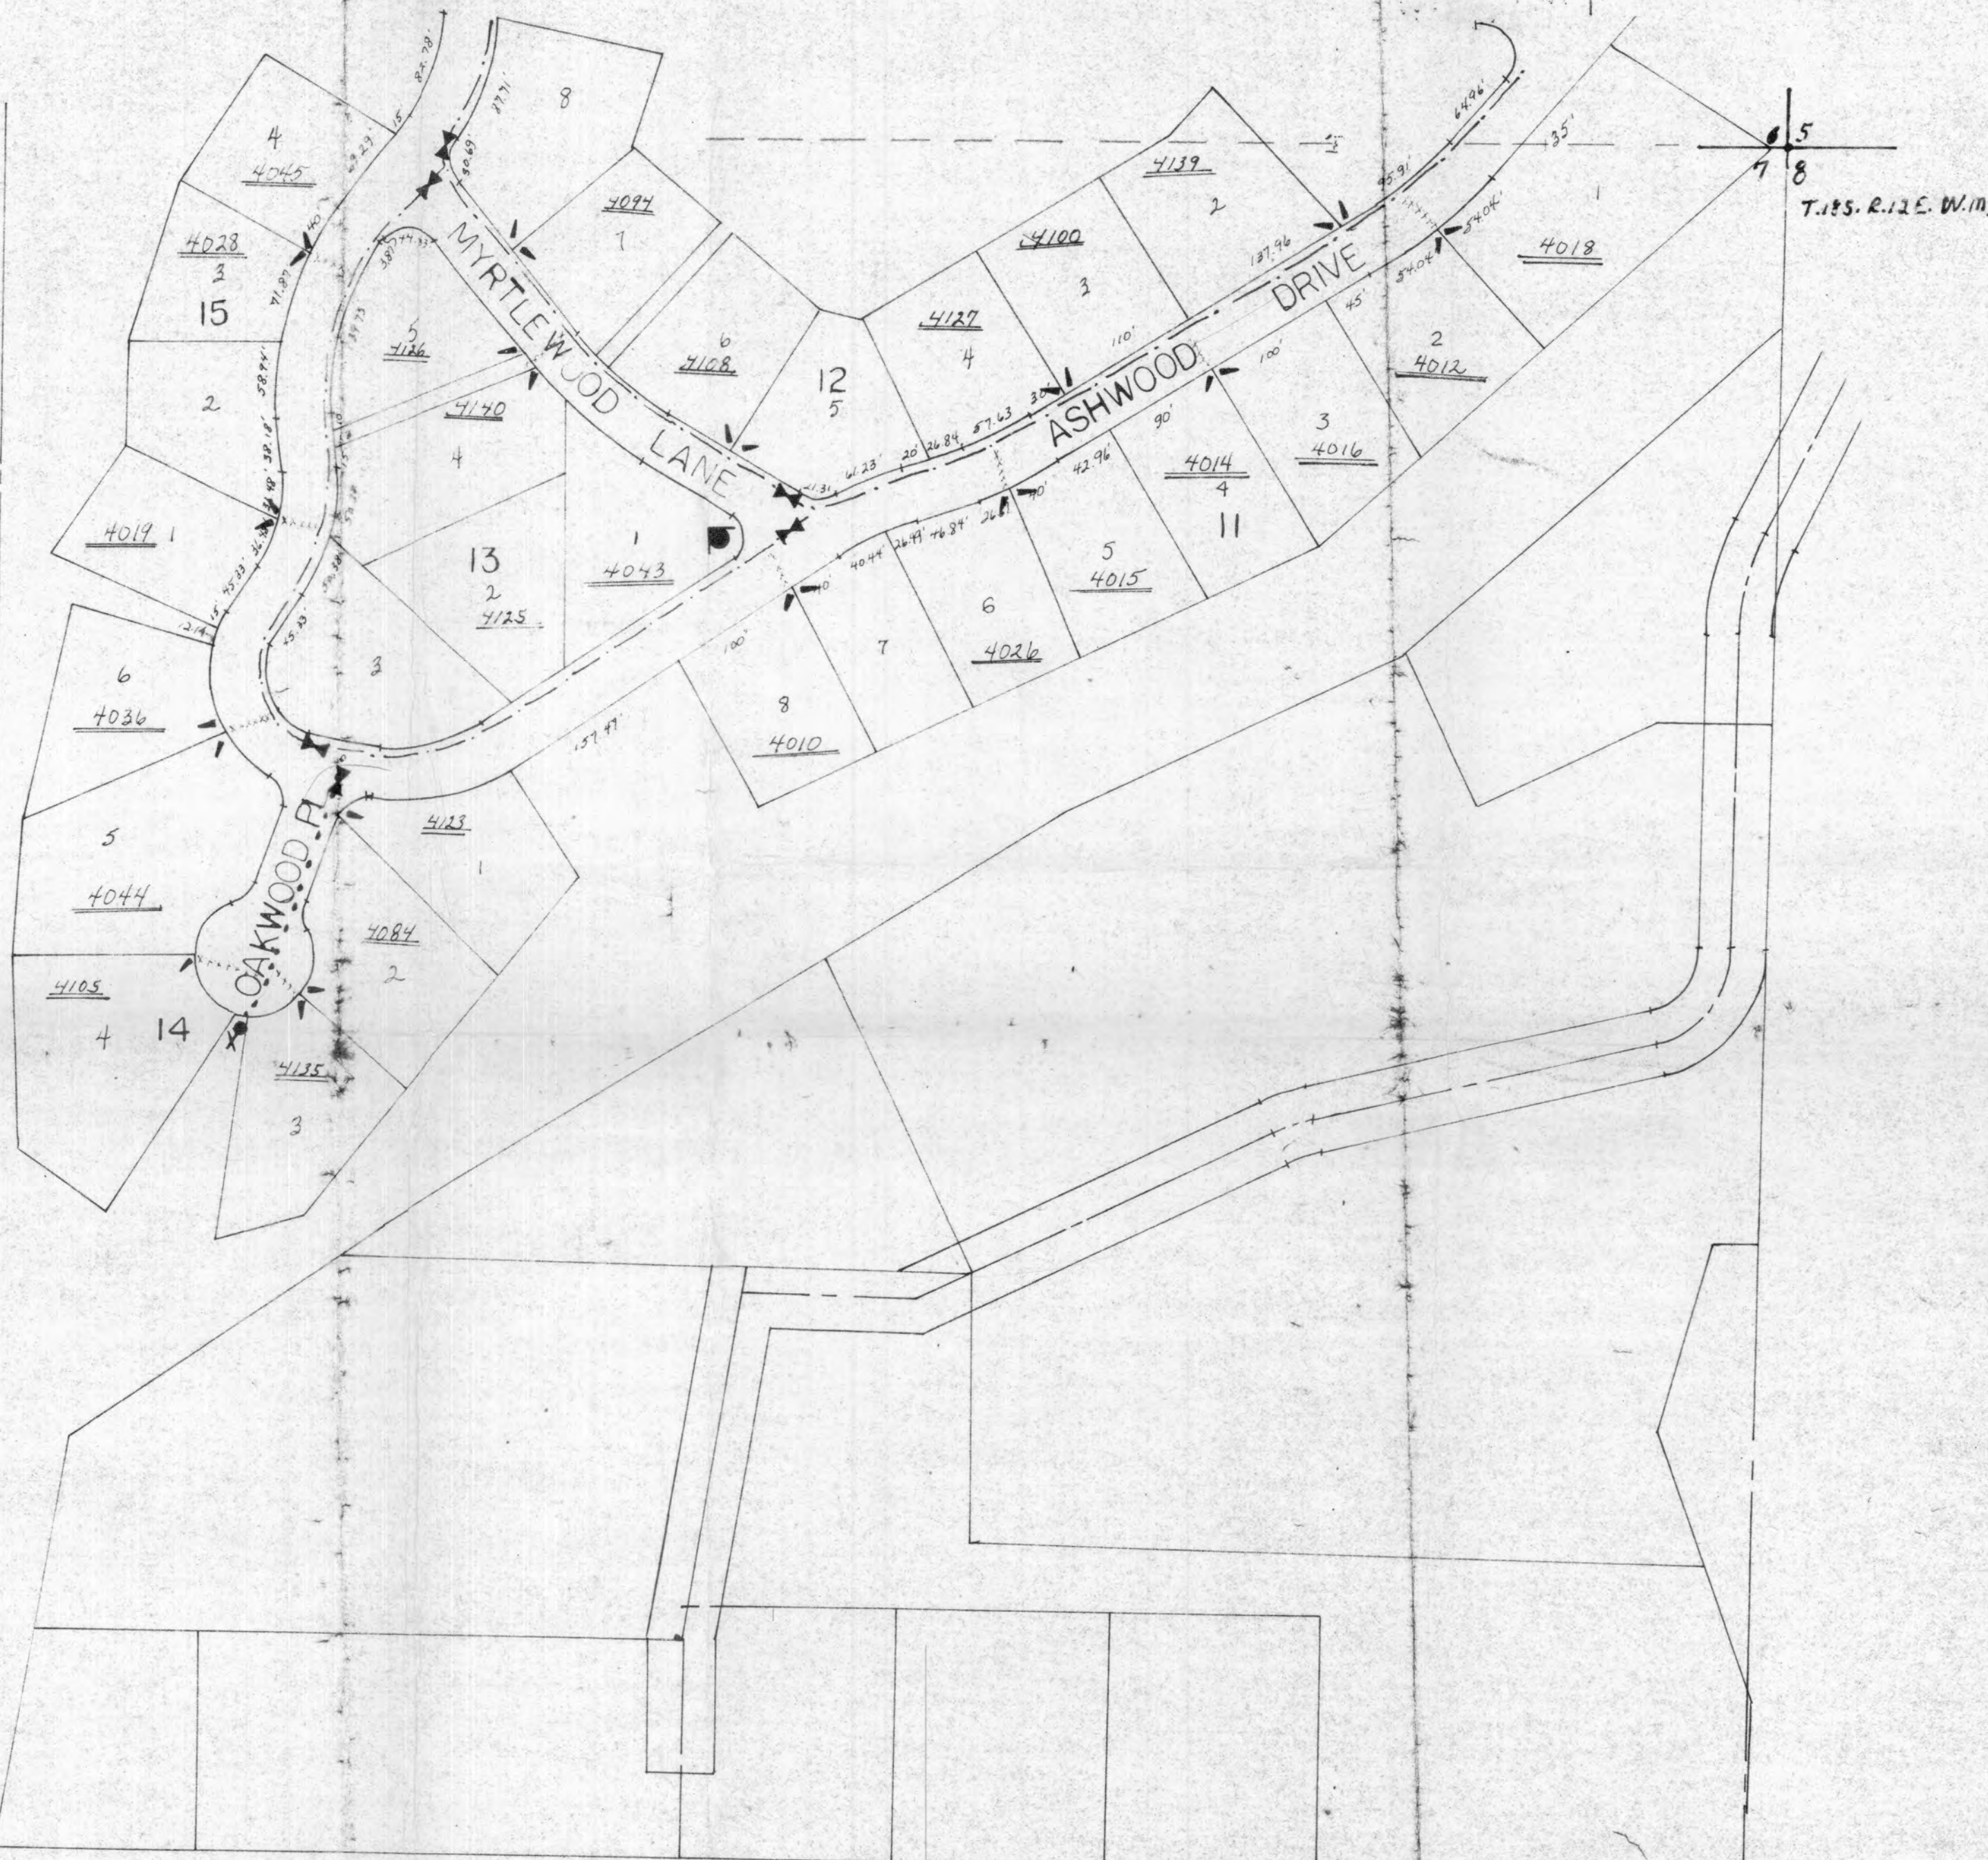

RECEIVED


FEB 11 1981

WATER RESOURCES DEPT
SALEM, OREGON

Application No. G-10154
Permit No. 9217

6" Domestic	-----
4" Domestic	-----
1 1/4" Service Line	XXXXXX
Valve	⌵
HYDRANT	⌵
Service	⌵
Account No.	#
Blowoff	⌵
2" Domestic	

Woodriver Village

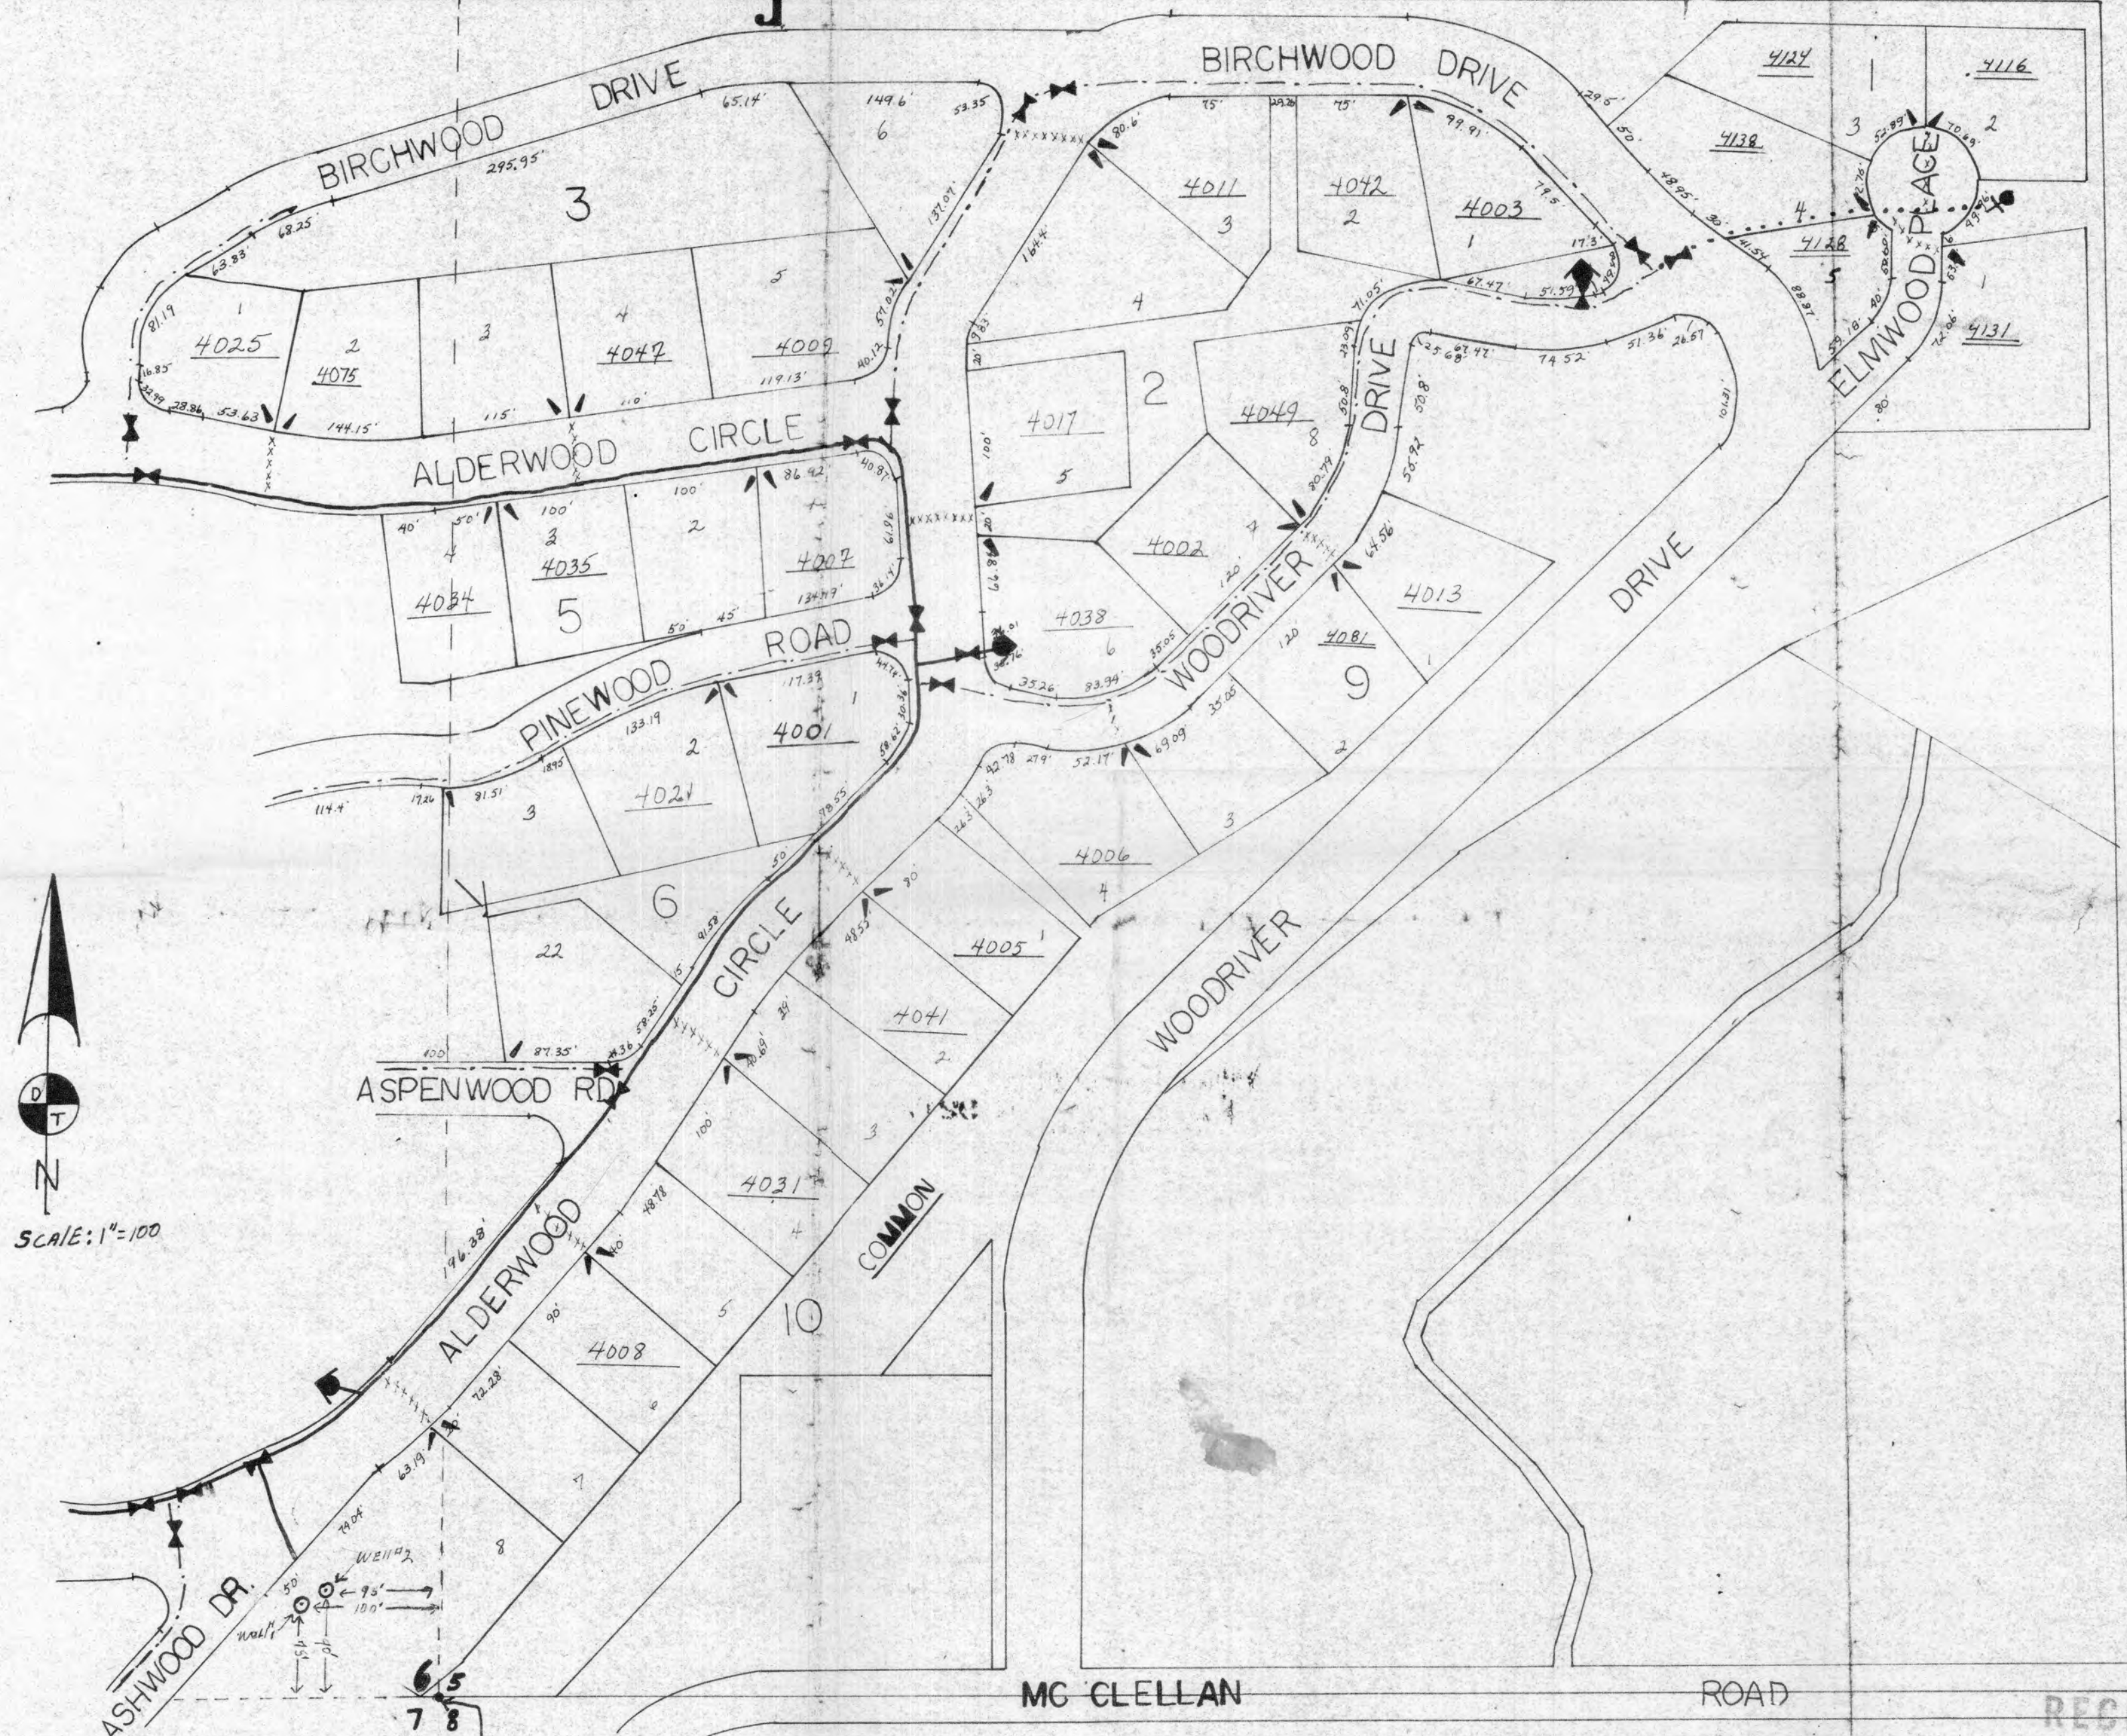

POINT OF BEGINNING INITIAL POINT
1 1/2" BRASS AP
T.18S R.12E.W.M.

RECEIVED


FEB 11 1981

WATER RESOURCES DEPT
SALEM, OREGON

Application No. C 10154
Permit No. G 9217

Wood River Village

LEGEND
 6" Domestic ———
 4" Domestic - - - - -
 1 1/4" Domestic
 Valve 
 Hydrant 
 Service 
 Account No. 

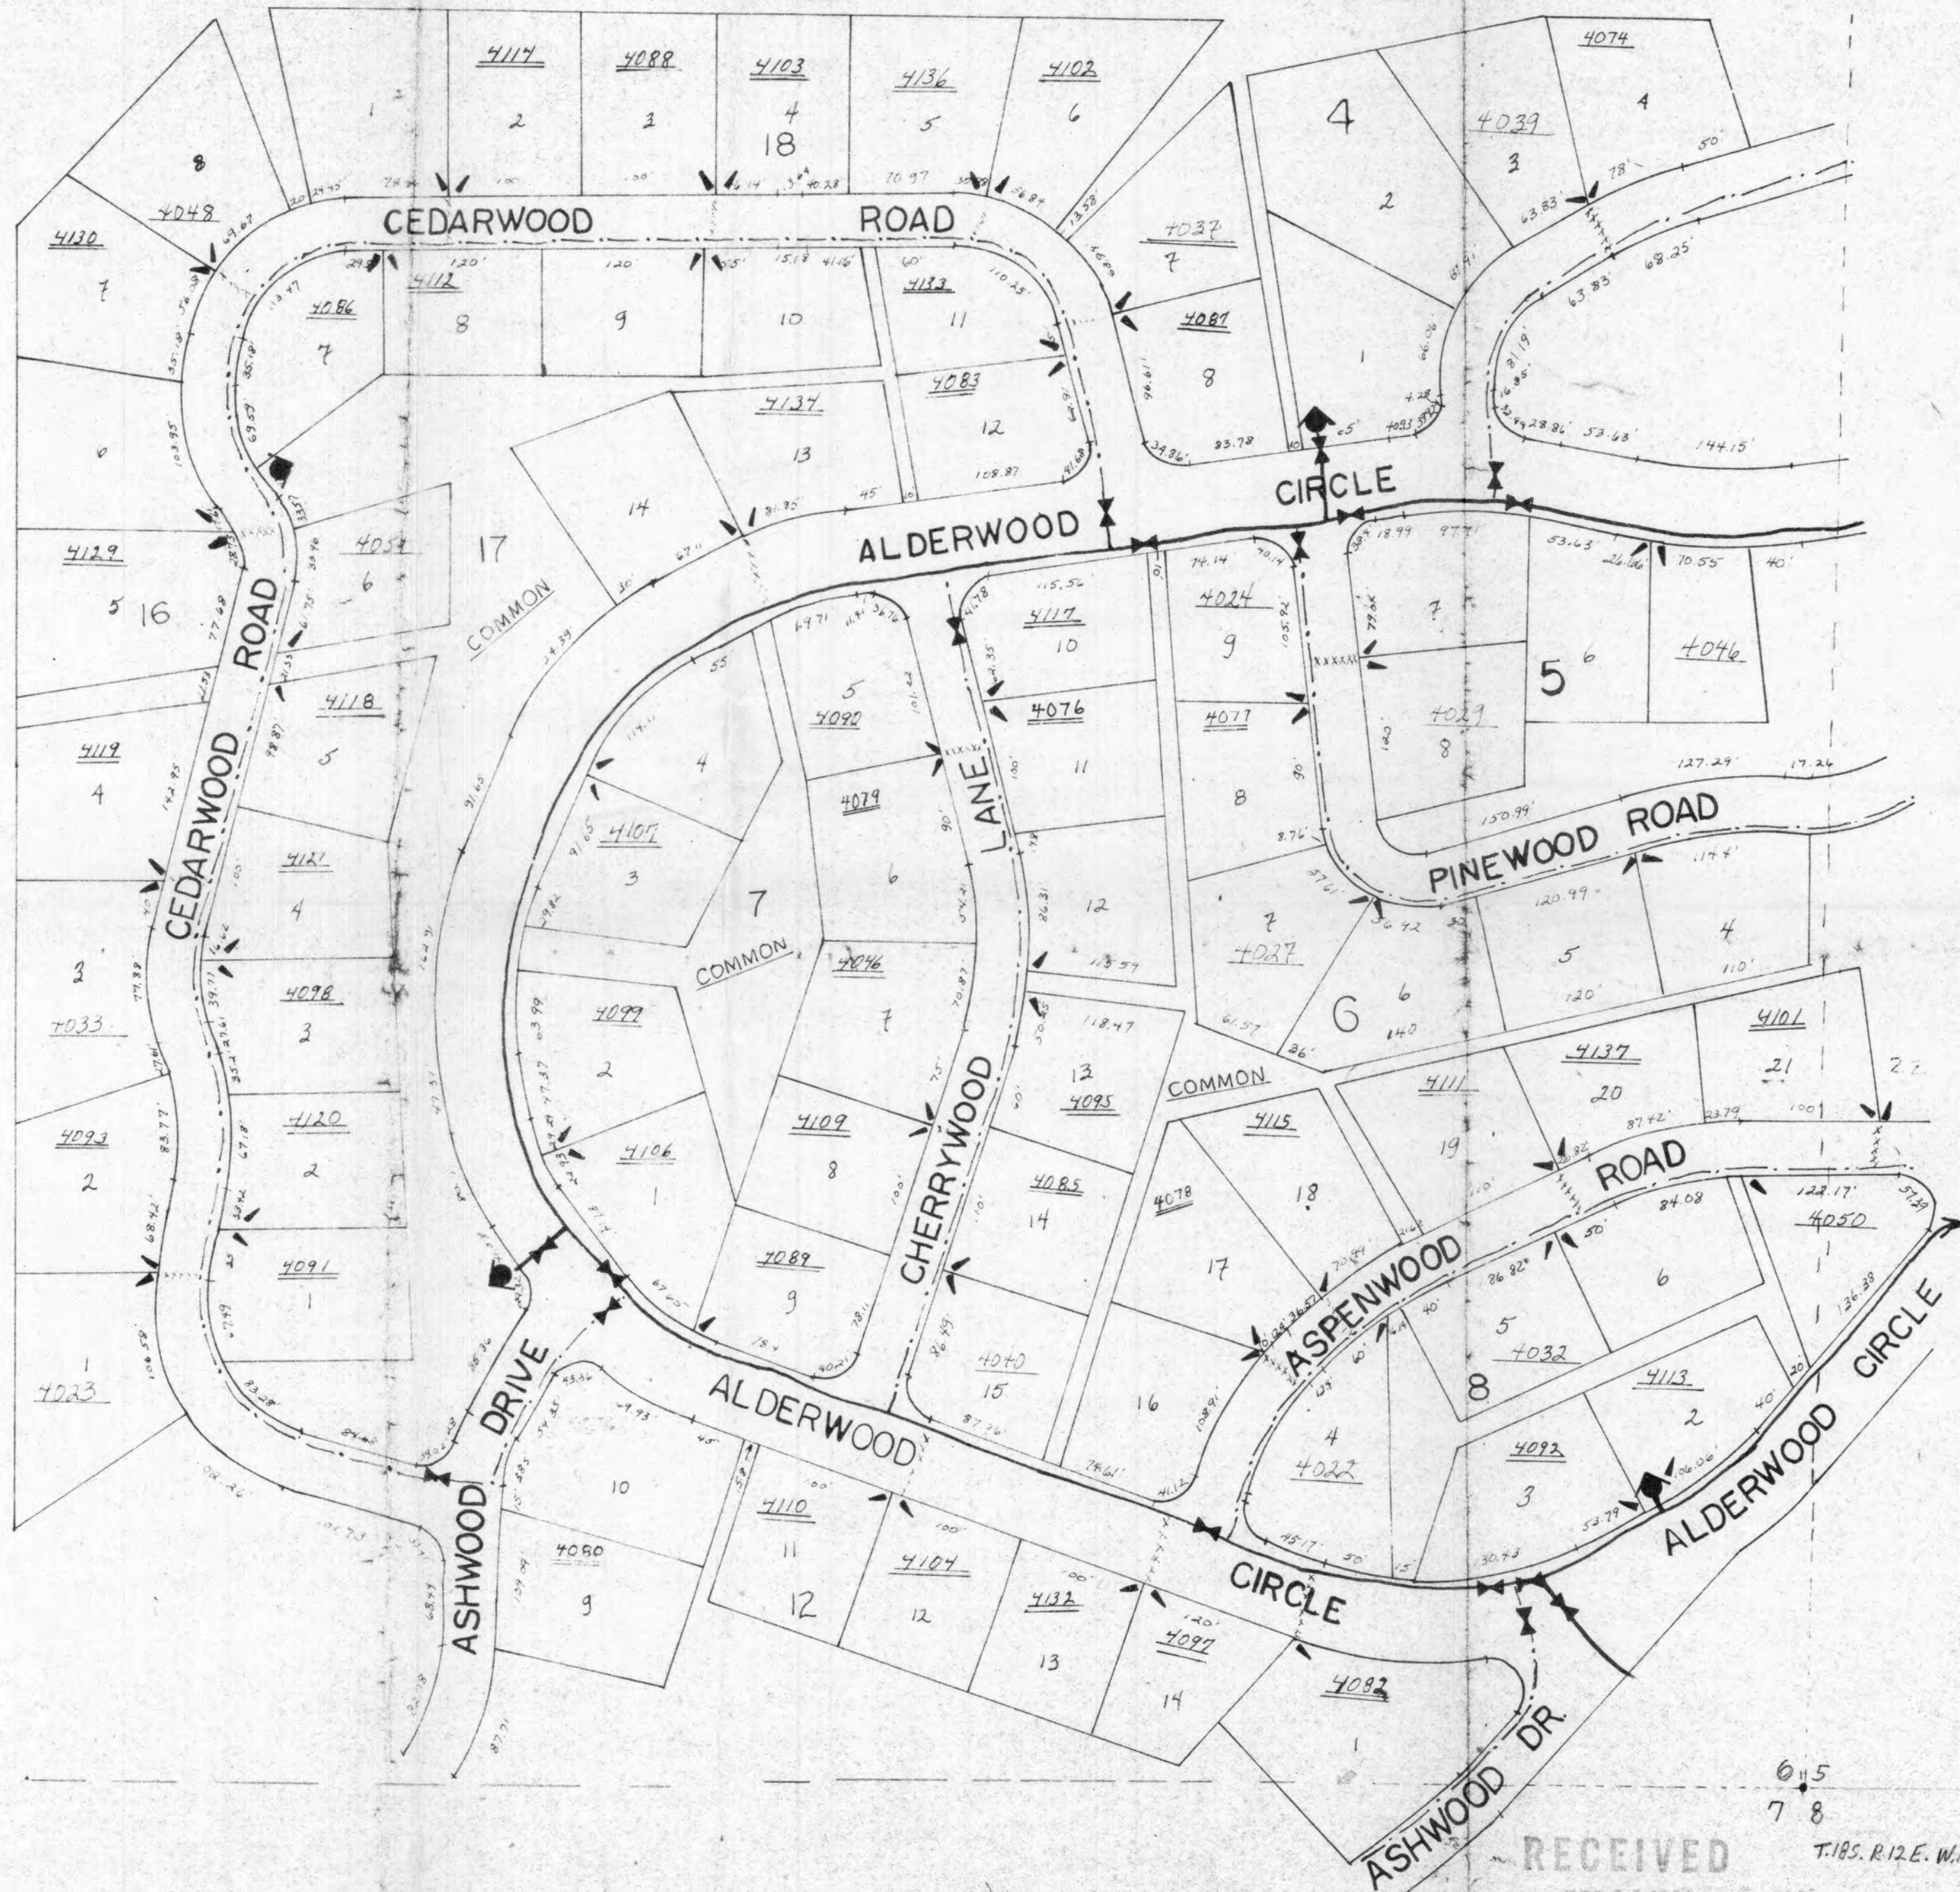

Application No. G-10154
 Permit No. G 9217-9218

RECEIVED

FEB 11 1981

WATER RESOURCES DEPT
 SALEM, OREGON

615
 78
 T.18S. R.12E. W.M.