


CLAIM OF BENEFICIAL USE SURVEY R15296 & S55139
T35S R1W S35 W.M. TL 600
ROGUE RIVER BASIN-JACKSON COUNTY, OREGON

Received
JUL 21 2026

OWRD

NENE

NWNE

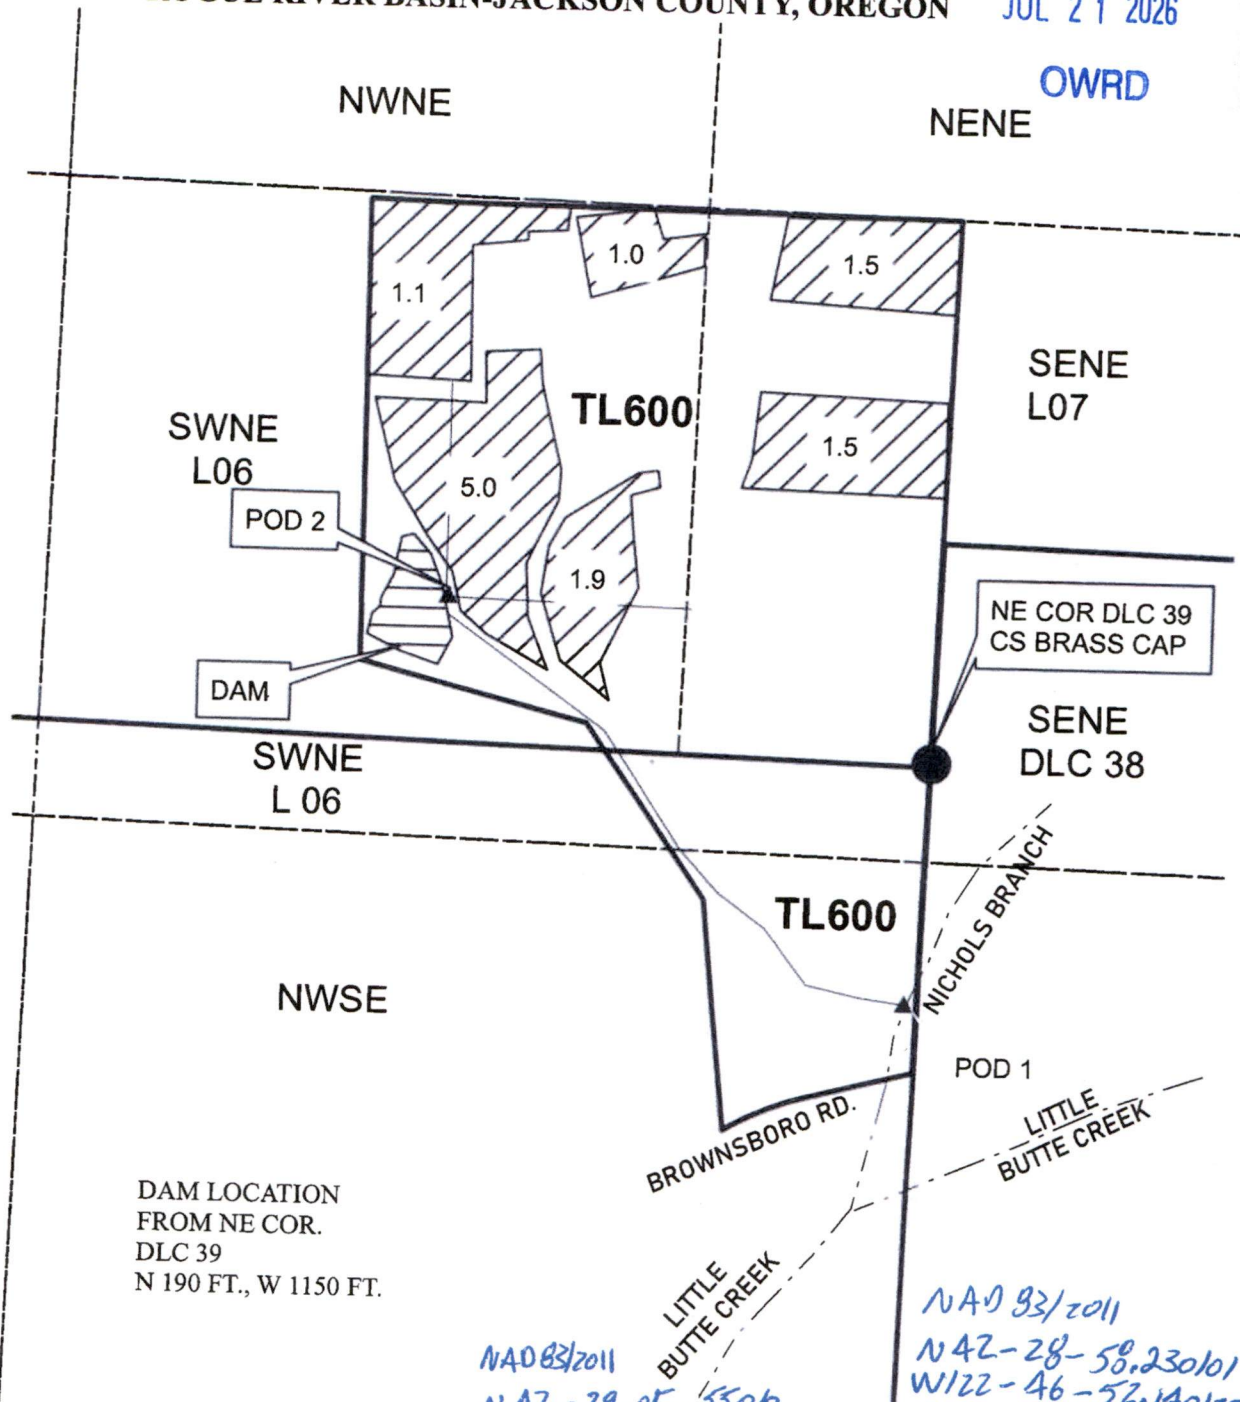


N

SCALE 1 INCH =
400 FEET

Prepared For:
Snow View Holdings LLC.
1635 Brownsboro HWY.
Eagle Point, OR 97524

Prepared By:
Scott Fein Water Rights
Certified Water Right Examiner
600 Tyler Creek Rd.
Ashland, OR 97520
sfeinsurveyor@gmail.com
541-842-0795

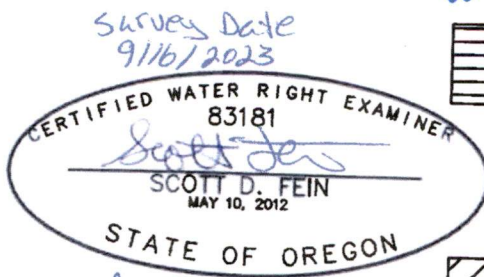

For water rights purposes only.
Not for property boundary
locations or dimensions.
No unauthorized reproduction
or modification.

NAD83/2011
N 42-29-05, 5506
W 122-47-04, 63020
RESERVOIR R15296
LOCATION
FROM NE COR.
DLC 39
S 500 FT., W 40 FT.
0.30 ACRES
5.0 ACRE FEET

S55296
POU 12.0 ACRES
NURSERY USE

3 INCH PIPELINE

NAD83/2011
N 42-28-58, 230101
W 122-46-52, 140120

POD 1
NICHOLS BRANCH
FROM NE COR.
DLC 39
S 500 FT., W 40 FT.
NAD83/2011
N 42-29-06, 11010
W 122-47-03, 09101
POD 2
RESERVOIR R15296
FROM NE COR.
DLC 39
N 330 FT., W 1020 FT.

FLOWMETER @ EACH