


T 13 S, R 5 W, W.M.

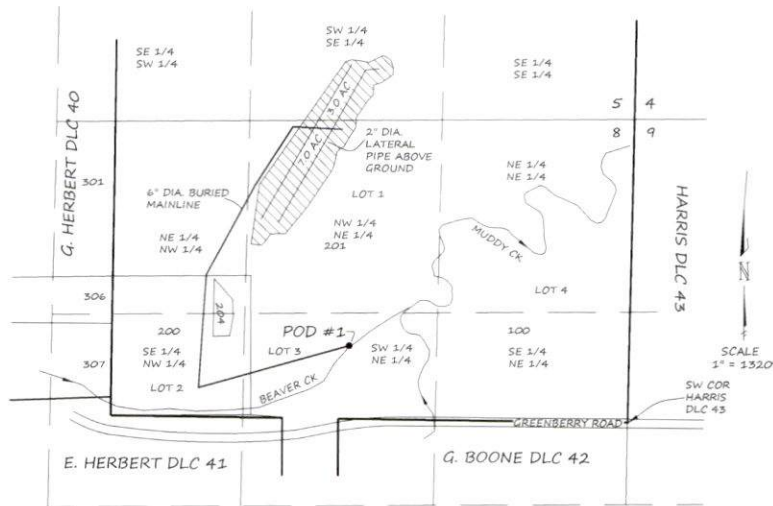

SPECIAL ORDER VOLUME 134, PAGE 1071 T- 14352

 DENOTES AREA OF TRANSFER
BENEFICIAL USE

POD #1 - 440' NORTH AND 380' EAST FROM
NE CORNER HERBERT DLC #41
(SAME LOCATION AND CONDITIONS
AS IN CERT. #33400 AND CERT. #
91283)
LAT = 44.45782°
LONG = 123.32045°
NAD 83


PUMP, SCREEN AND METER AT POD #1 AS PER
CERT. #91283. WATER DELIVERY SYSTEM SAME
AS APPROVED IN CERT. #91283.

NOTE:
THE PREPARATION OF THE MAP WAS
FOR THE PURPOSE OF IDENTIFYING THE
LOCATION OF THE WATER RIGHT ONLY.
IT IS NOT INTENDED TO PROVIDE
LOCATION NOR DIMENSIONS OF PROPERTY
OWNERSHIP LINES.

CLAIM OF BENEFICIAL USE MAP
FOR

DAVID V. AND MARGARET S. BUCHANAN, TRUSTEES
26335 GREENBERRY ROAD
CORVALLIS, OR 97333

BY
H. TIMOTHY FASSBENDER, PLS, CWRE
2896 SARAH LANE
EUGENE, OR 97408
JUNE 29, 2026

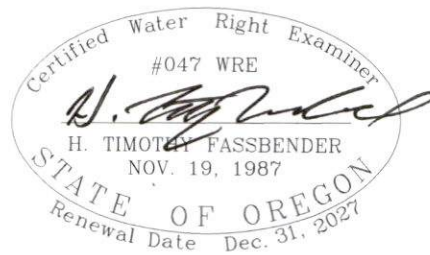

Received
JUL 22 2026
OWRD