


T.6S. R.2W. Section 35 T.7S. R.2W. Section 2, W.M.

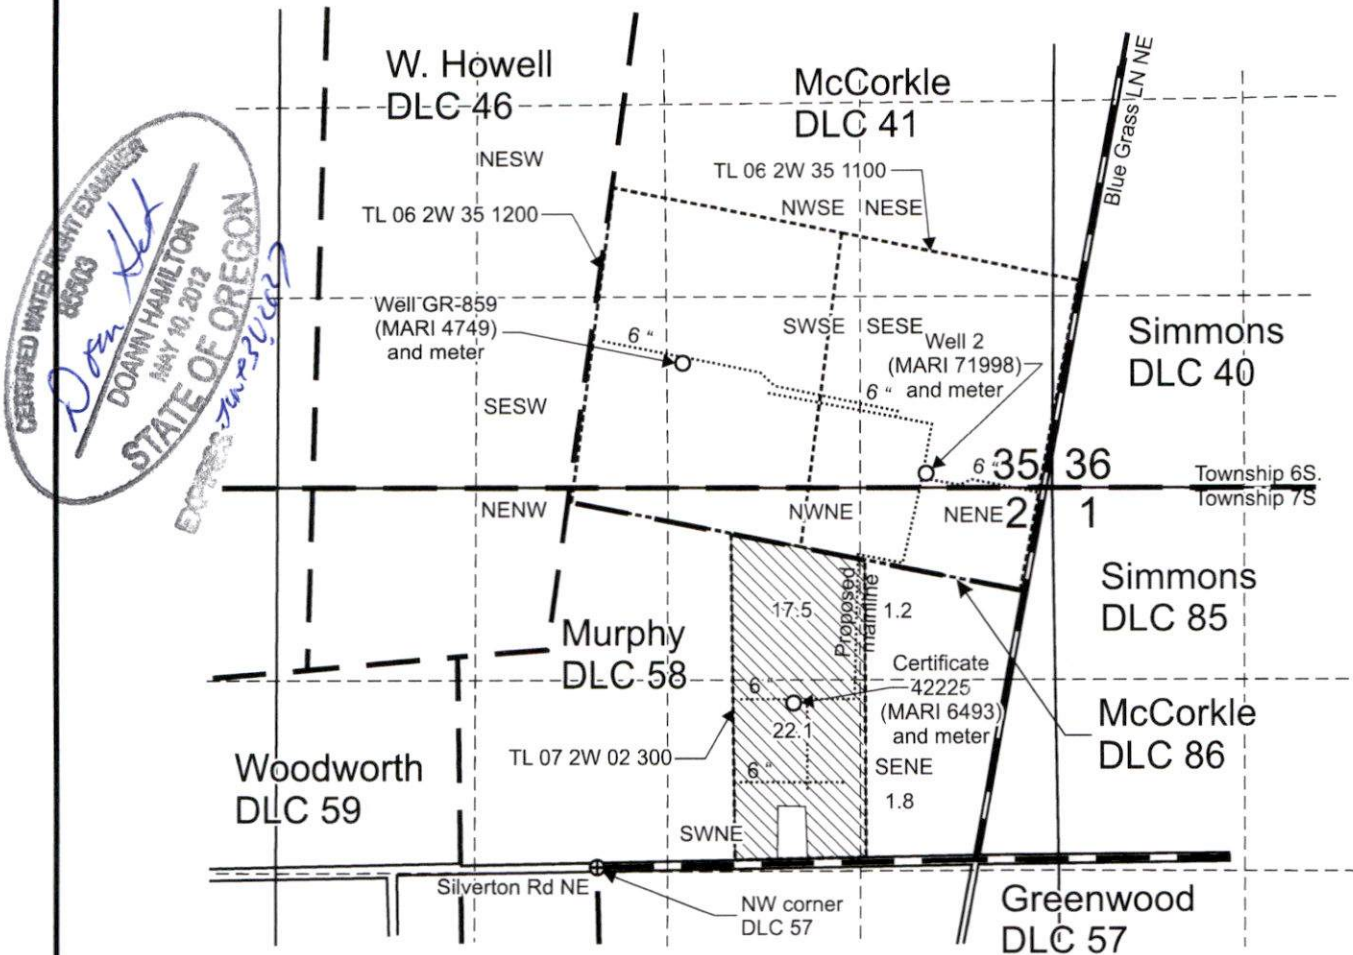

Certificate 42225 Well (MARI 6493) 1,110 feet north and 1,350 feet east from NW corner, DLC 57. (44.994511, -122.893767, WGS-84)

Well 2 (MARI 71998) Is located 100 feet north and 865 feet west from the SE corner, Section 35. (44.99887216, -122.89009717, WGS 84)

GR-859 Well (MARI 4749) west 17 degrees north 2,640 feet from SE corner, Section 35. (45.00085215, -122.89610068, WGS-84)

 Area (42.6 Acres) irrigated under T-14580, formerly Certificate 42225, priority date 4-9-1969.

- Tax lot boundary
- • — Donation Land Claim boundary
- Irrigation mainlines

Scale: 1" = 1,320'



Received by OWRD


Salem, OR

This map was prepared for the purpose of identifying the location of a water right only and is not intended to provide legal dimensions or location of property ownership lines.

Claim of Beneficial Use Map
T-14580, formerly Certificate 42225

Jensen Family LLC.
T.6S. R.2W. Section 35,
T.7S. R.2W. Section 2, W.M.

 WILL MCGILL SURVEYING LLC

