


T.5S. R.2W. Sec. 13, 14 & 23, W.M.

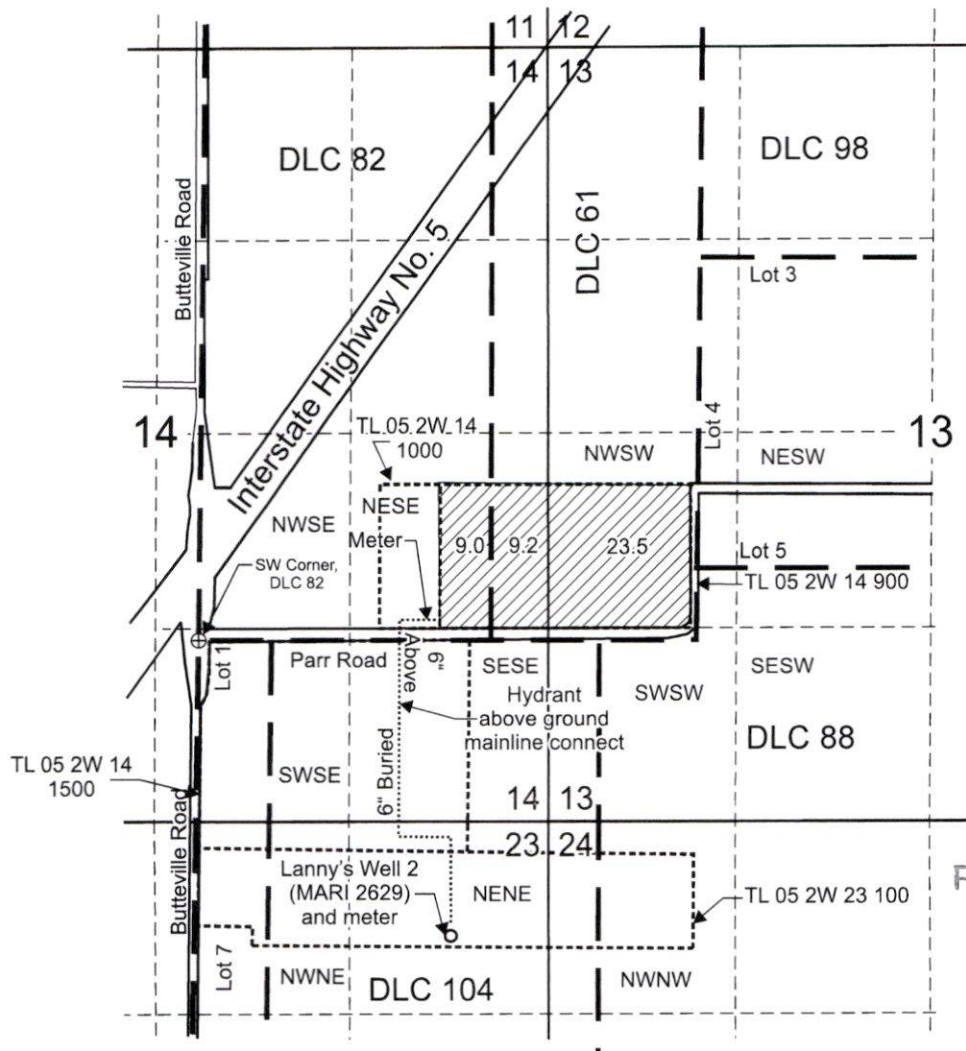

Received by OWRD
JUL 27 2026
Salem, OR

Lanny's Well 2 (MARI 2629) is located 2,080 feet south and 1,680 feet east from the SW corner, DLC 82. (45.12749566, -122.8909267, WGS-84)

 Area (41.7 Acres) irrigated under T-14102, formerly Certificate 36320, priority date April 21, 1967.

- Tax lot boundary
- Donation Land Claim boundary
- Buried and above-ground irrigation main line



Scale: 1" = 1,320'



This map was prepared for the purpose of identifying the location of a water right only and is not intended to provide legal dimensions or location of property ownership lines.

Claim of Beneficial Use Map
T-14102, formerly Certificate 36320

Weisz Family, LLC
T.5S. R.2W. Sec. 13, 14 & 23, W.M.

 WILL MCGILL SURVEYING LLC

07/2026