ADDITIONAL POINT OF DIVERSION

RECEIVED
MAR 01 1995
WATER RESOURCES DEPT.
SALEM, OREGON

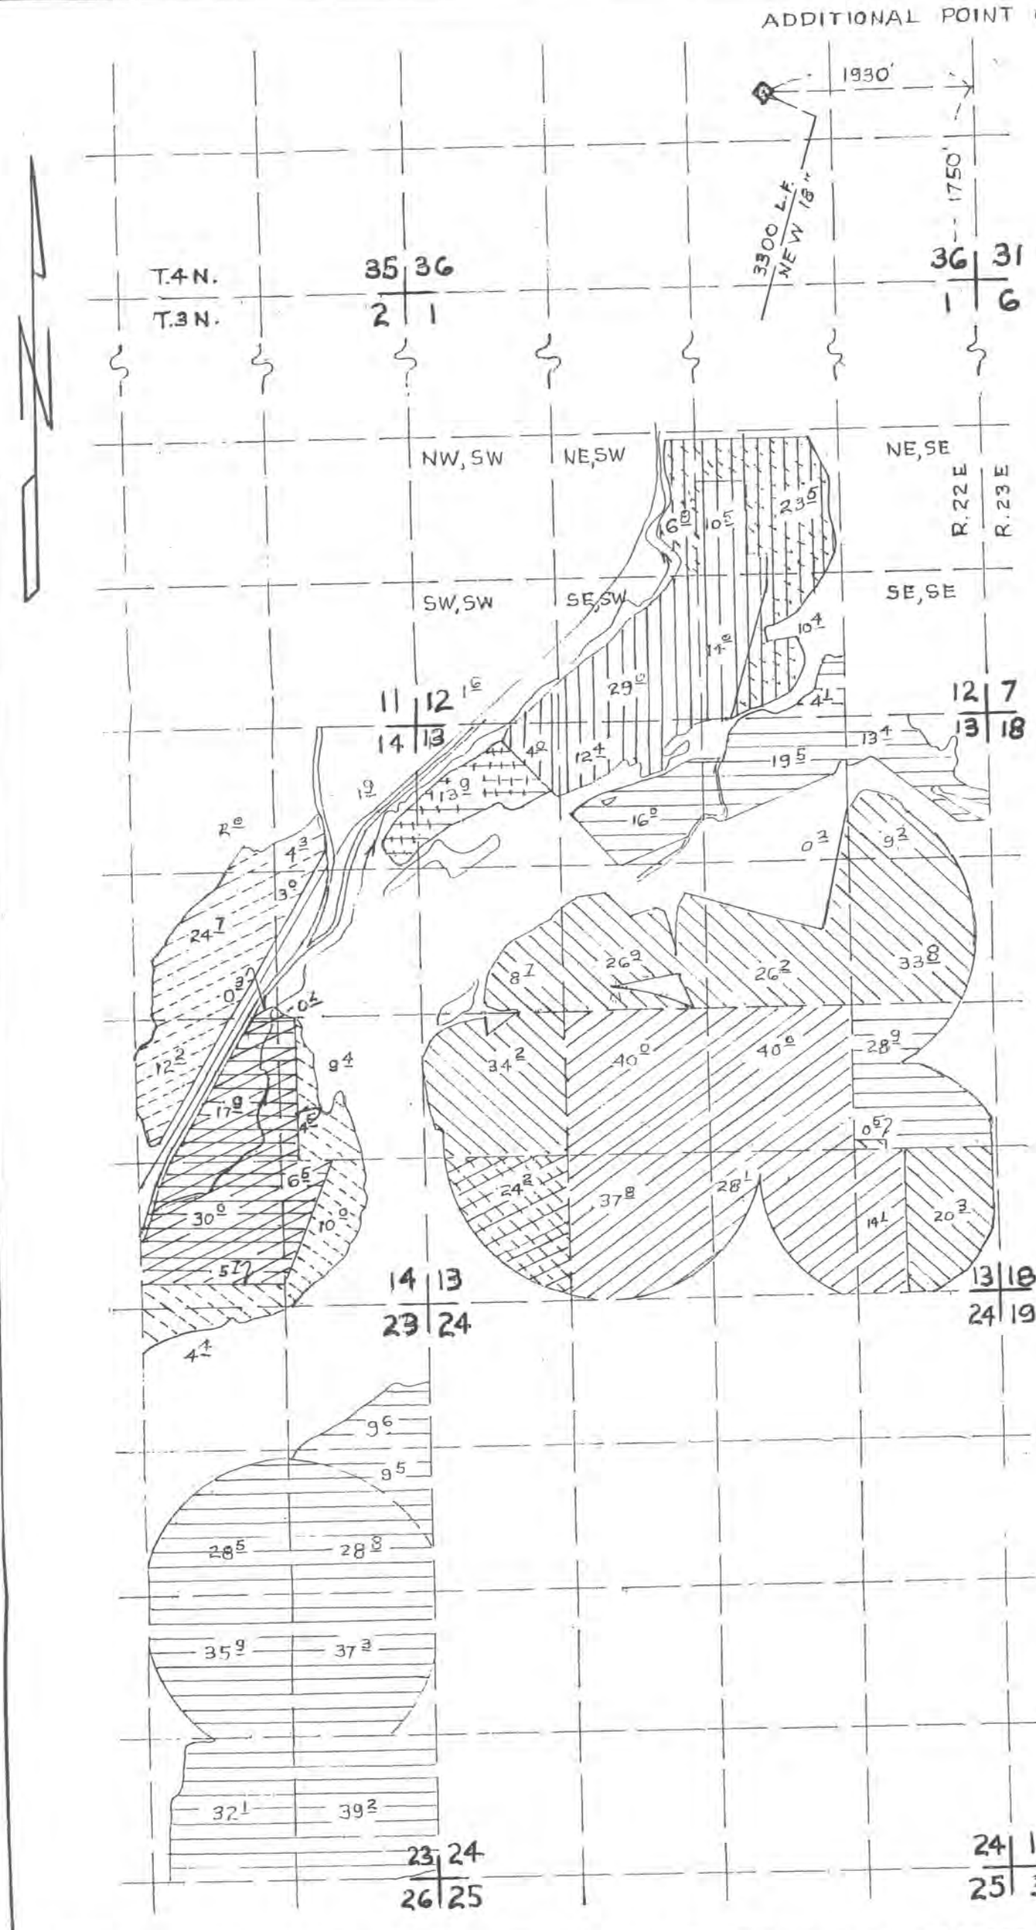

35002 DAVIS PRIMARY

35002 SULLIVAN PRIMARY

35002 DAVIS SUPPL.

35002 SCHRIMSHER SUPP.

35003 SULLIVAN PRIMARY

35004 SULLIVAN PRIMARY

35005 CRISP PRIMARY

35005 CRISP SUPPL.

35005 SULLIVAN SUPPL.

38225 CRISP

KRUMBEIN ENGINEERING LTD. ENGINEERS – SURVEYORS – PLANNERS 361 S.E. Second Pendleton, Oregon	Scale 1"=1320'	Drn. By DHK	Drng. No. 9501B	Revision 1
	Date 2-23-95	Ckd. By	Job No. 91-4	Revision 2

FINAL PROOF MAP

BRIAN SULLIVAN

T-6496

SEC. 36, T. 4N., R. 22 E.W.M
SECS. 12, 13, 14, 23 T. 3N., R. 23 E.

Certified Water Right Examiner 9078
David H. Krumbein
Nov. 19, 1987
STATE OF OREGON

RENEWS 6/30/95