


Nickel Mountain, LLC
Location of Jenni Lake Impoundment
in SW 1/4 of the SW 1/4 of Section 16
T30S, R6W, W.M., Douglas County, Oregon
Tax Lot 200

Datum: WGS84
Map Created: 7/22/2026

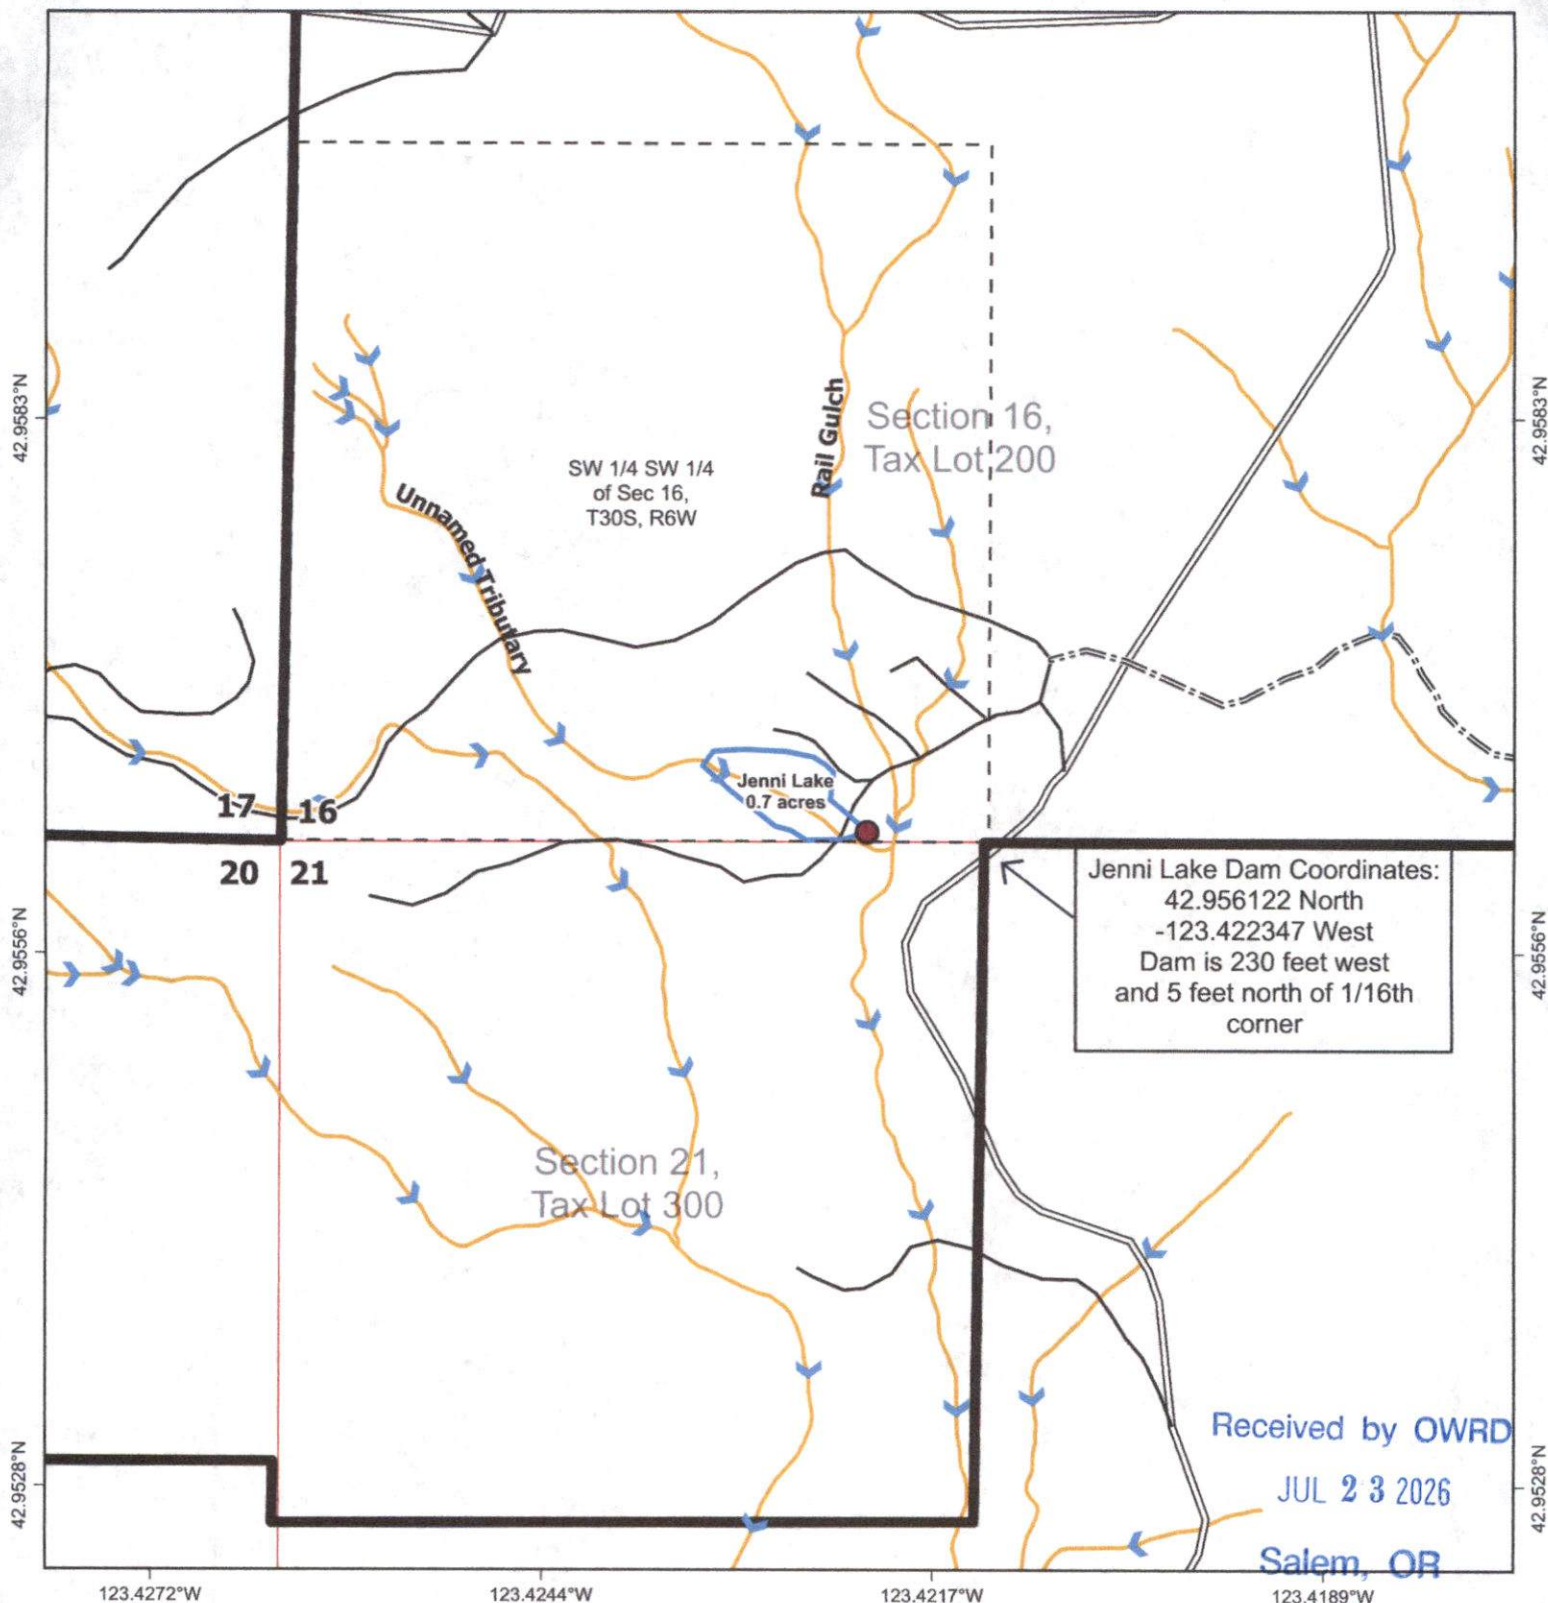

- | | | |
|--------------------|---------|-----------------|
| NM Ownership Roads | Streams | |
| Sections | Paved | Non-Fish, Small |
| SWSW Sec 16 | Rock | Flow Direction |
| Jenni Lake | Native | Jenni Lake Dam |

This product is for informational purposes and may not have been prepared for, or be suitable for legal, engineering, or surveying purposes. Users of this information should review or consult the primary data and information sources to ascertain the usability of the information.