


Claim of Beneficial Use - Oak Park Farms/Coon Application S-87969, Permit S-54896

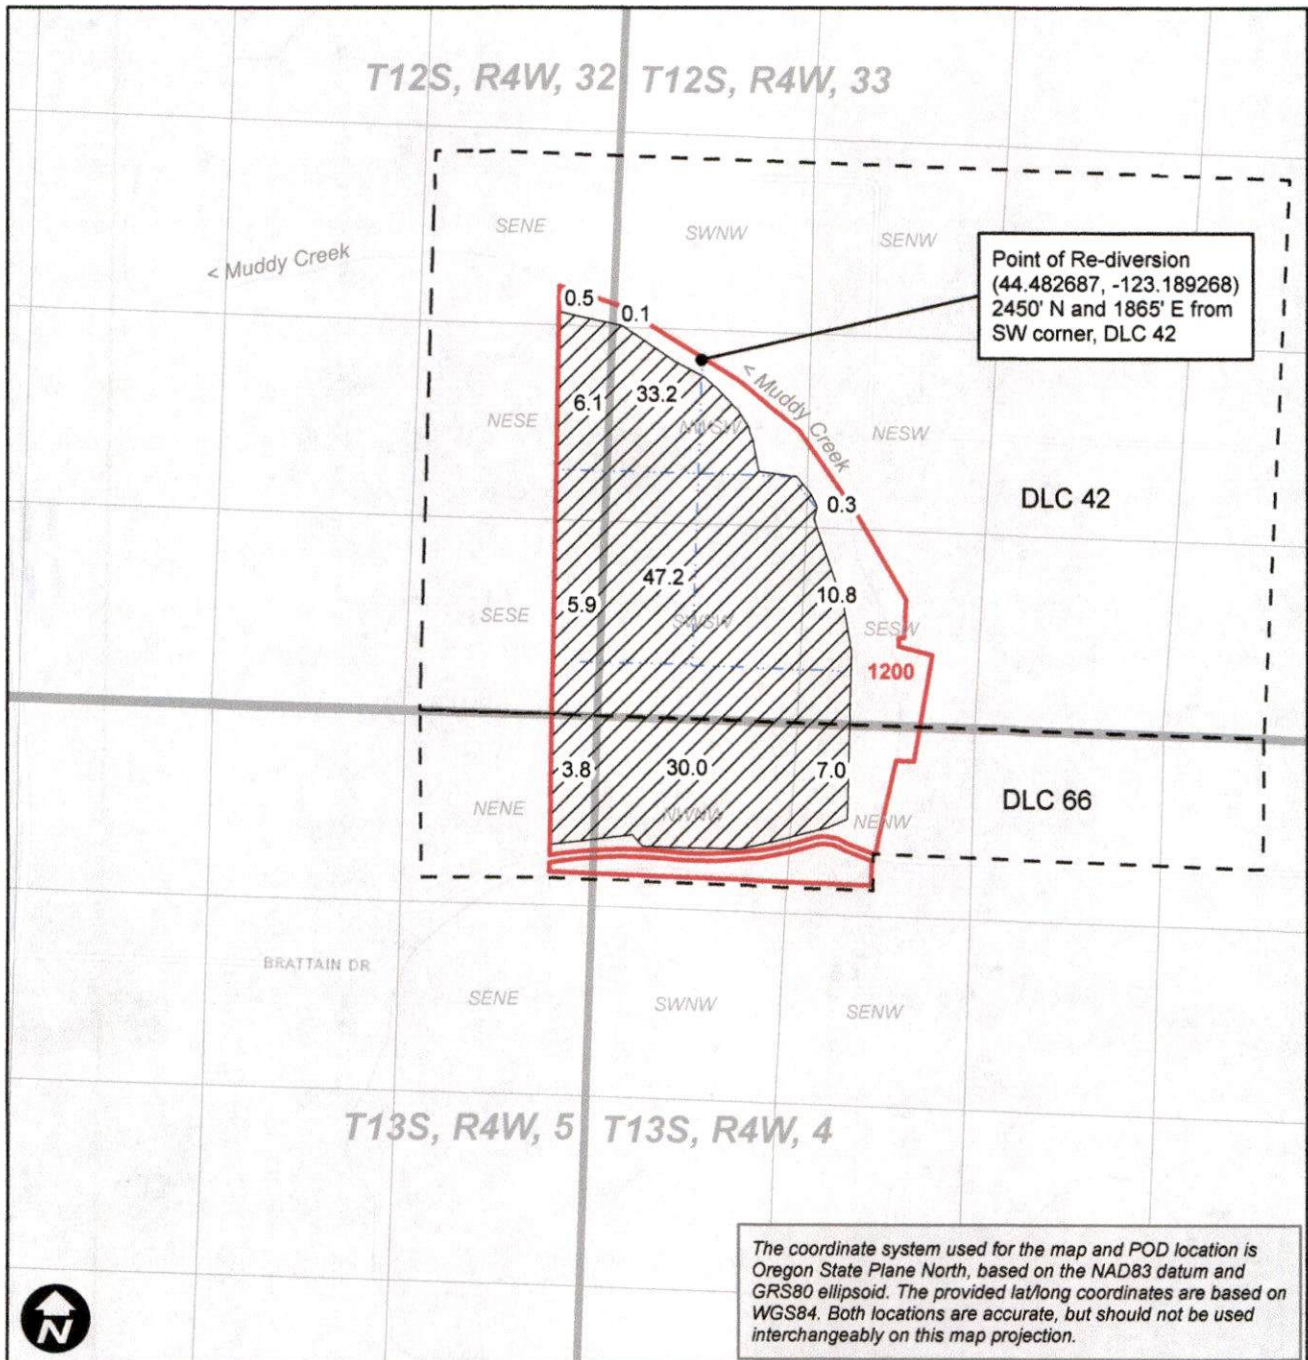

Legend

- IR POU
- DLC
- Mainline
- Taxlot

Received by OWRD

JUL 27 2026

Salem, OR



EXPIRES: 12/31/2026