


T18S R41E WM

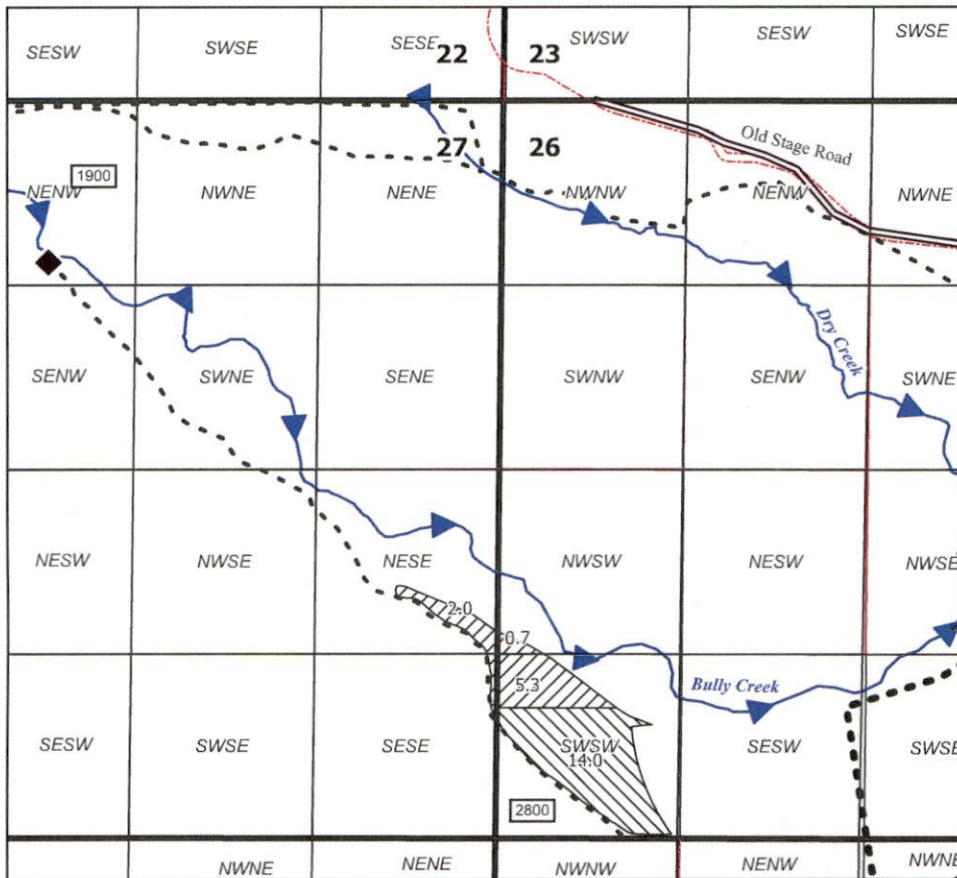

LEGEND

- ◆ POD 4
- Dirt road
- - - Ditch
- Cert_51082 8/31/1978
- ▨ POD 4
- Cert_51109 2/7/1912
- ▨ POD 4
- ▭ Malheur County Taxlot Boundary



Received by OWRD
JUL 29 2026
Salem, OR



Transfer T-16682 Claim of Beneficial Use Map for POD 4 (Map 3 of 3) Malheur County, OR

Prepared on behalf of Bill and Cindy Romans
1 inch = 1,320 feet




Notes:

This map is not intended to provide legal dimensions or locations of property ownership lines

POD 4: 1,120' S and 2,130' E from the NW corner of Section 27 (WGS84: 43.9792529°, -117.6798228°)

Fish screen is located at the point of diversion and concrete weir flow measurement device is located

Date: 7/22/2026
Drawn by: Paul F. Garvin

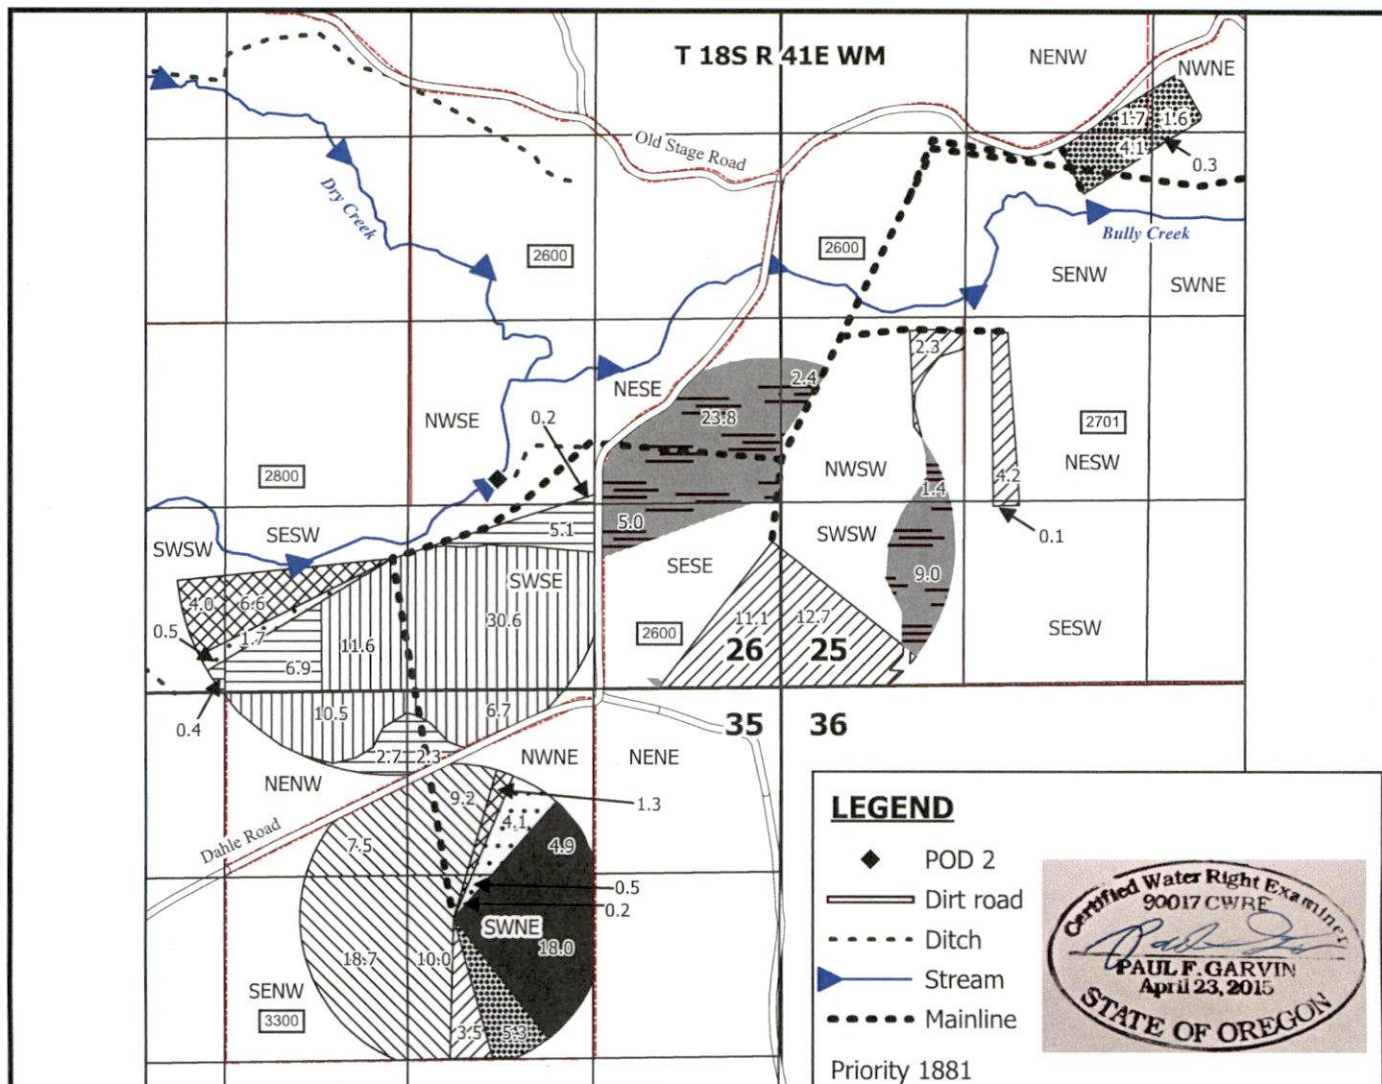

Notes:


This map is not intended to provide legal dimensions or locations of property ownership lines

POD 2: 1,490' N and 2,030' W from the SE Corner of Section 26 (WGS84: 43.9723454°, -117.6550339°)

Fish screen and flowmeter located within a 10 foot radius of the point of diversion

LEGEND

- ◆ POD 2
- Dirt road
- - - Ditch
- Stream
- - - Mainline

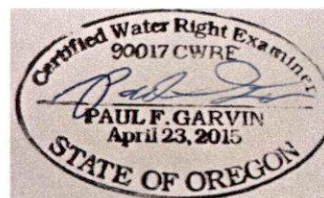

- Priority 1881
 To POD 2
- Priority 1886
 Stay POD 4 to POD 2
 To POD 2
- Priority 10/3/1978
 To POD 2
- Priority 1876
 To POD 2
- Priority 1876
 To POD 2
- Priority 11/18/1968
 To POD 2 (IS to IR)
- Priority 1886
 To POD 2
- Priority 8/31/1978
 To POD 2
- Malheur County Taxlot Boundary [2701]

Received by OWRI

JUL 29 2026

Salem, OR




Transfer T-16682 Claim of Beneficial Use Map for POD 2 (Map 2 of 3) Malheur County, OR

Prepared on behalf of Bill and Cindy Romans




1 inch = 1,320 feet

Date: 7/22/2026
Drawn by: Paul F. Garvin

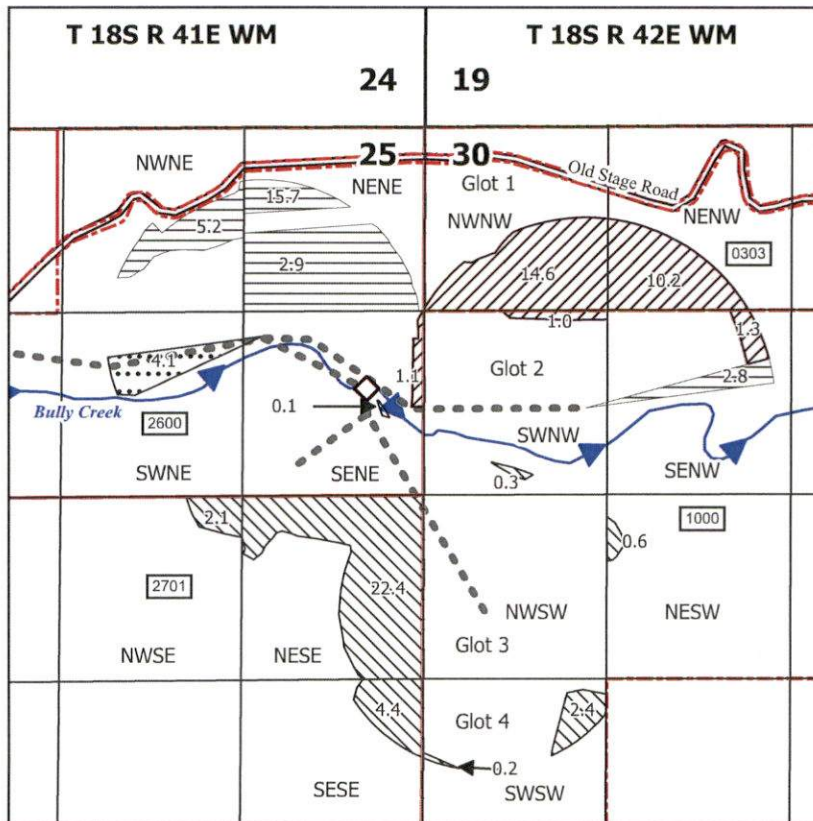

LEGEND

- POD 1
- Priority 1876
 - To POD 1
- Priority 1883
 - To POD 1
- Priority 1883
 - To POD 1
 - To POD 1 and IS to IR
- Malheur County Taxlot Boundary
- Dirt road
- Ditch
- Stream
- Mainline

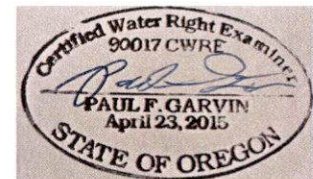

Received by OWRD

JUL 29 2026

Salem, OR



Transfer T-16682 Claim of Beneficial Use Map for POD 1 (Map 1 of 3) Malheur County, OR

Prepared on behalf of Bill and Cindy Romans

1 inch = 1,320 feet



Notes:

This map is not intended to provide legal dimensions or locations of property ownership lines

POD 1: 1,860' S and 410' W from the NE Corner of Section 25 (WGS84: 43.9777869°, -117.6289469°)

Fish screen and flowmeter located within a 10 foot radius of the point of diversion