


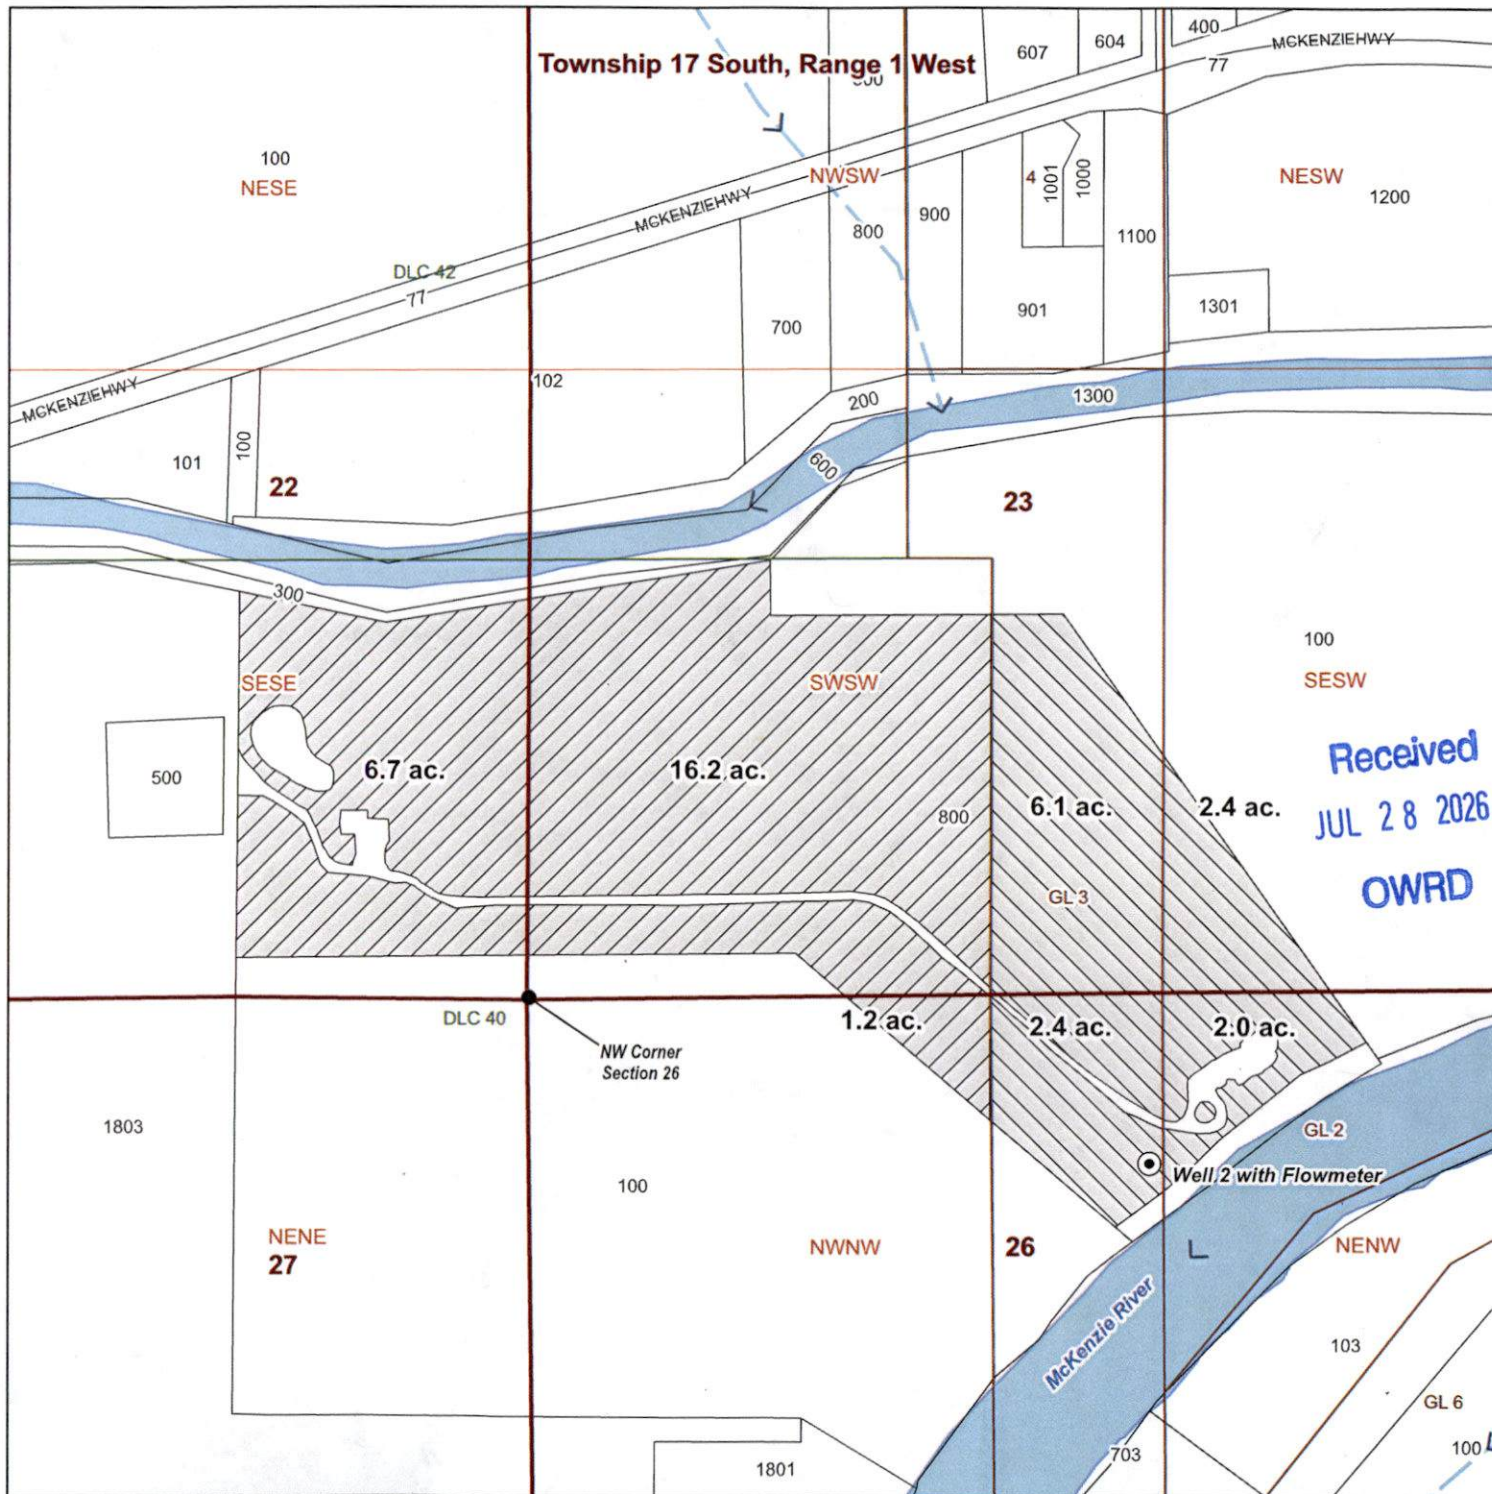

LEGEND


Place of Use (POU)

- Portion of Certificate 75779 affected by T-14351 (IR, 12.9 ac.)
- Portion of Certificate 86849 affected by T-14351 (IR, 24.1 ac.)
- Point of Appropriation (POA)
- Taxlots
- Roads
- Waterbody
- Watercourse (Perennial)
- Watercourse (Intermittent)

POA Location Description


Well 2
 Located 348 feet South and 1285 feet East from the NW corner of Section 26 (NWNW), Township 17 South, Range 1 West, W.M. (WGS84; 44.069463, -122.779516)

Received
 JUL 28 2026
 OWRD

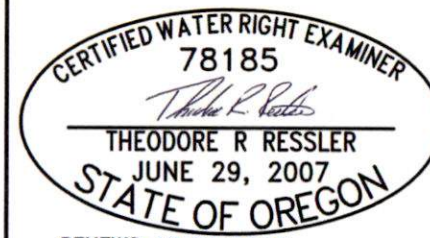

RENEWS: 12-31-2026

CWRE Seal and Signature

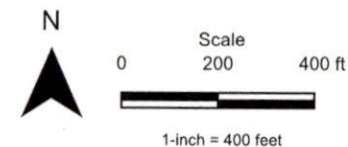

Date: 7/6/2026
 Data Sources: BLM, OWRD, USGS, Lane County
 Project CRS: EPSG: 6823 - NAD83 (2011) / Oregon Eugene zone (ft)
 Disclaimer: This map is not intended to provide legal dimensions or property ownership lines.

Claim of Beneficial Use Transfer T-14351

Water Rights in the Name of David and Barbara Barzelton
 Lane County

