


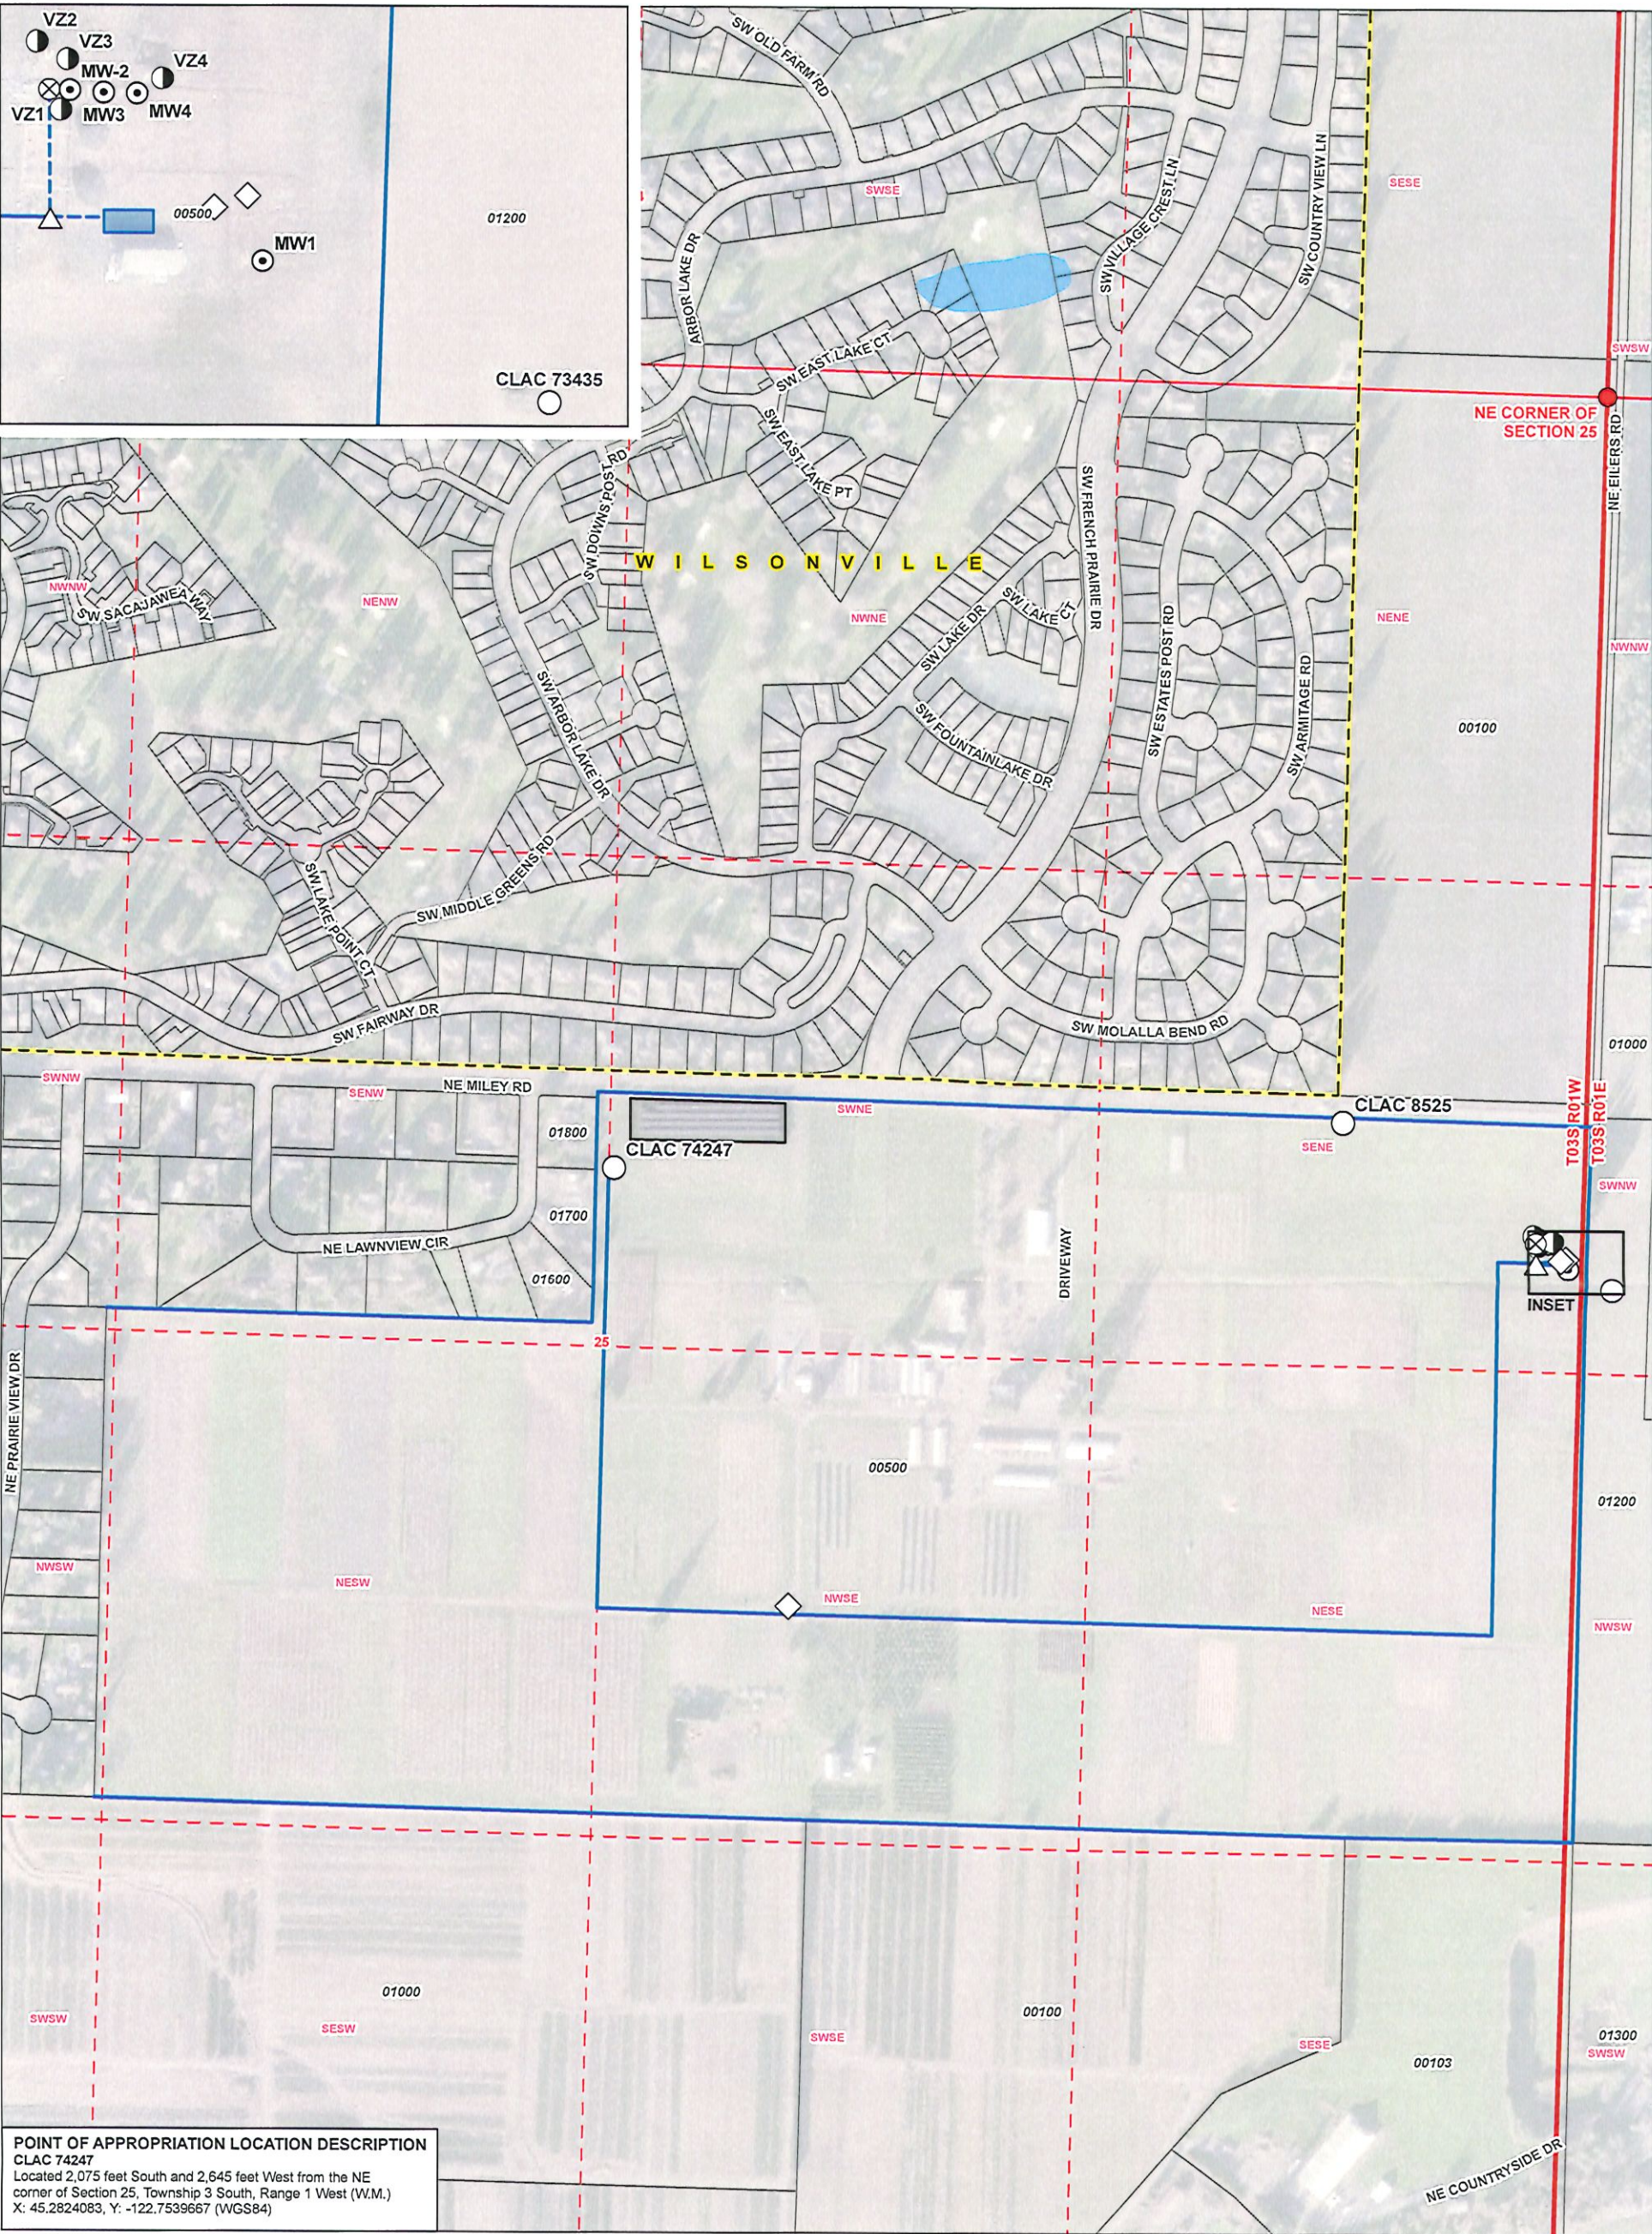

**LEGEND**

- Monitoring Well
- Vadose Zone Well
- Drywell
- Well
- Pretreatment Ex-Situ Unit
- Above Ground Water Storage Tank
- Connection Pipe
- Water Main
- Infiltration Basin
- Agrivoltaic Solar Panels
- All Other Features
- City Boundary
- Tax Lot

**RECEIVED**  
AUG 03 2026  
OWRD

**FIGURE 1**  
**Site Map of Proposed Project**  
**Limited License Application for**  
**Artificial Groundwater Recharge**  
Oregon State University


Date: August 3, 2026  
Data Sources: BLM, ESRI, ODOT, USGS, Imagery (2022)

Document Path: \\VMS\GIS\_Files\0863\_OSU\Source\_Figures\002\_AR\_Suppr\LL\_Appl\Figure1\_Artificial\_GW\_Recharge\_PLSS.aprx, Figure1\_Artificial\_GW\_Recharge\_PLSS, bramos

LL-2035

Water Solutions, Inc.



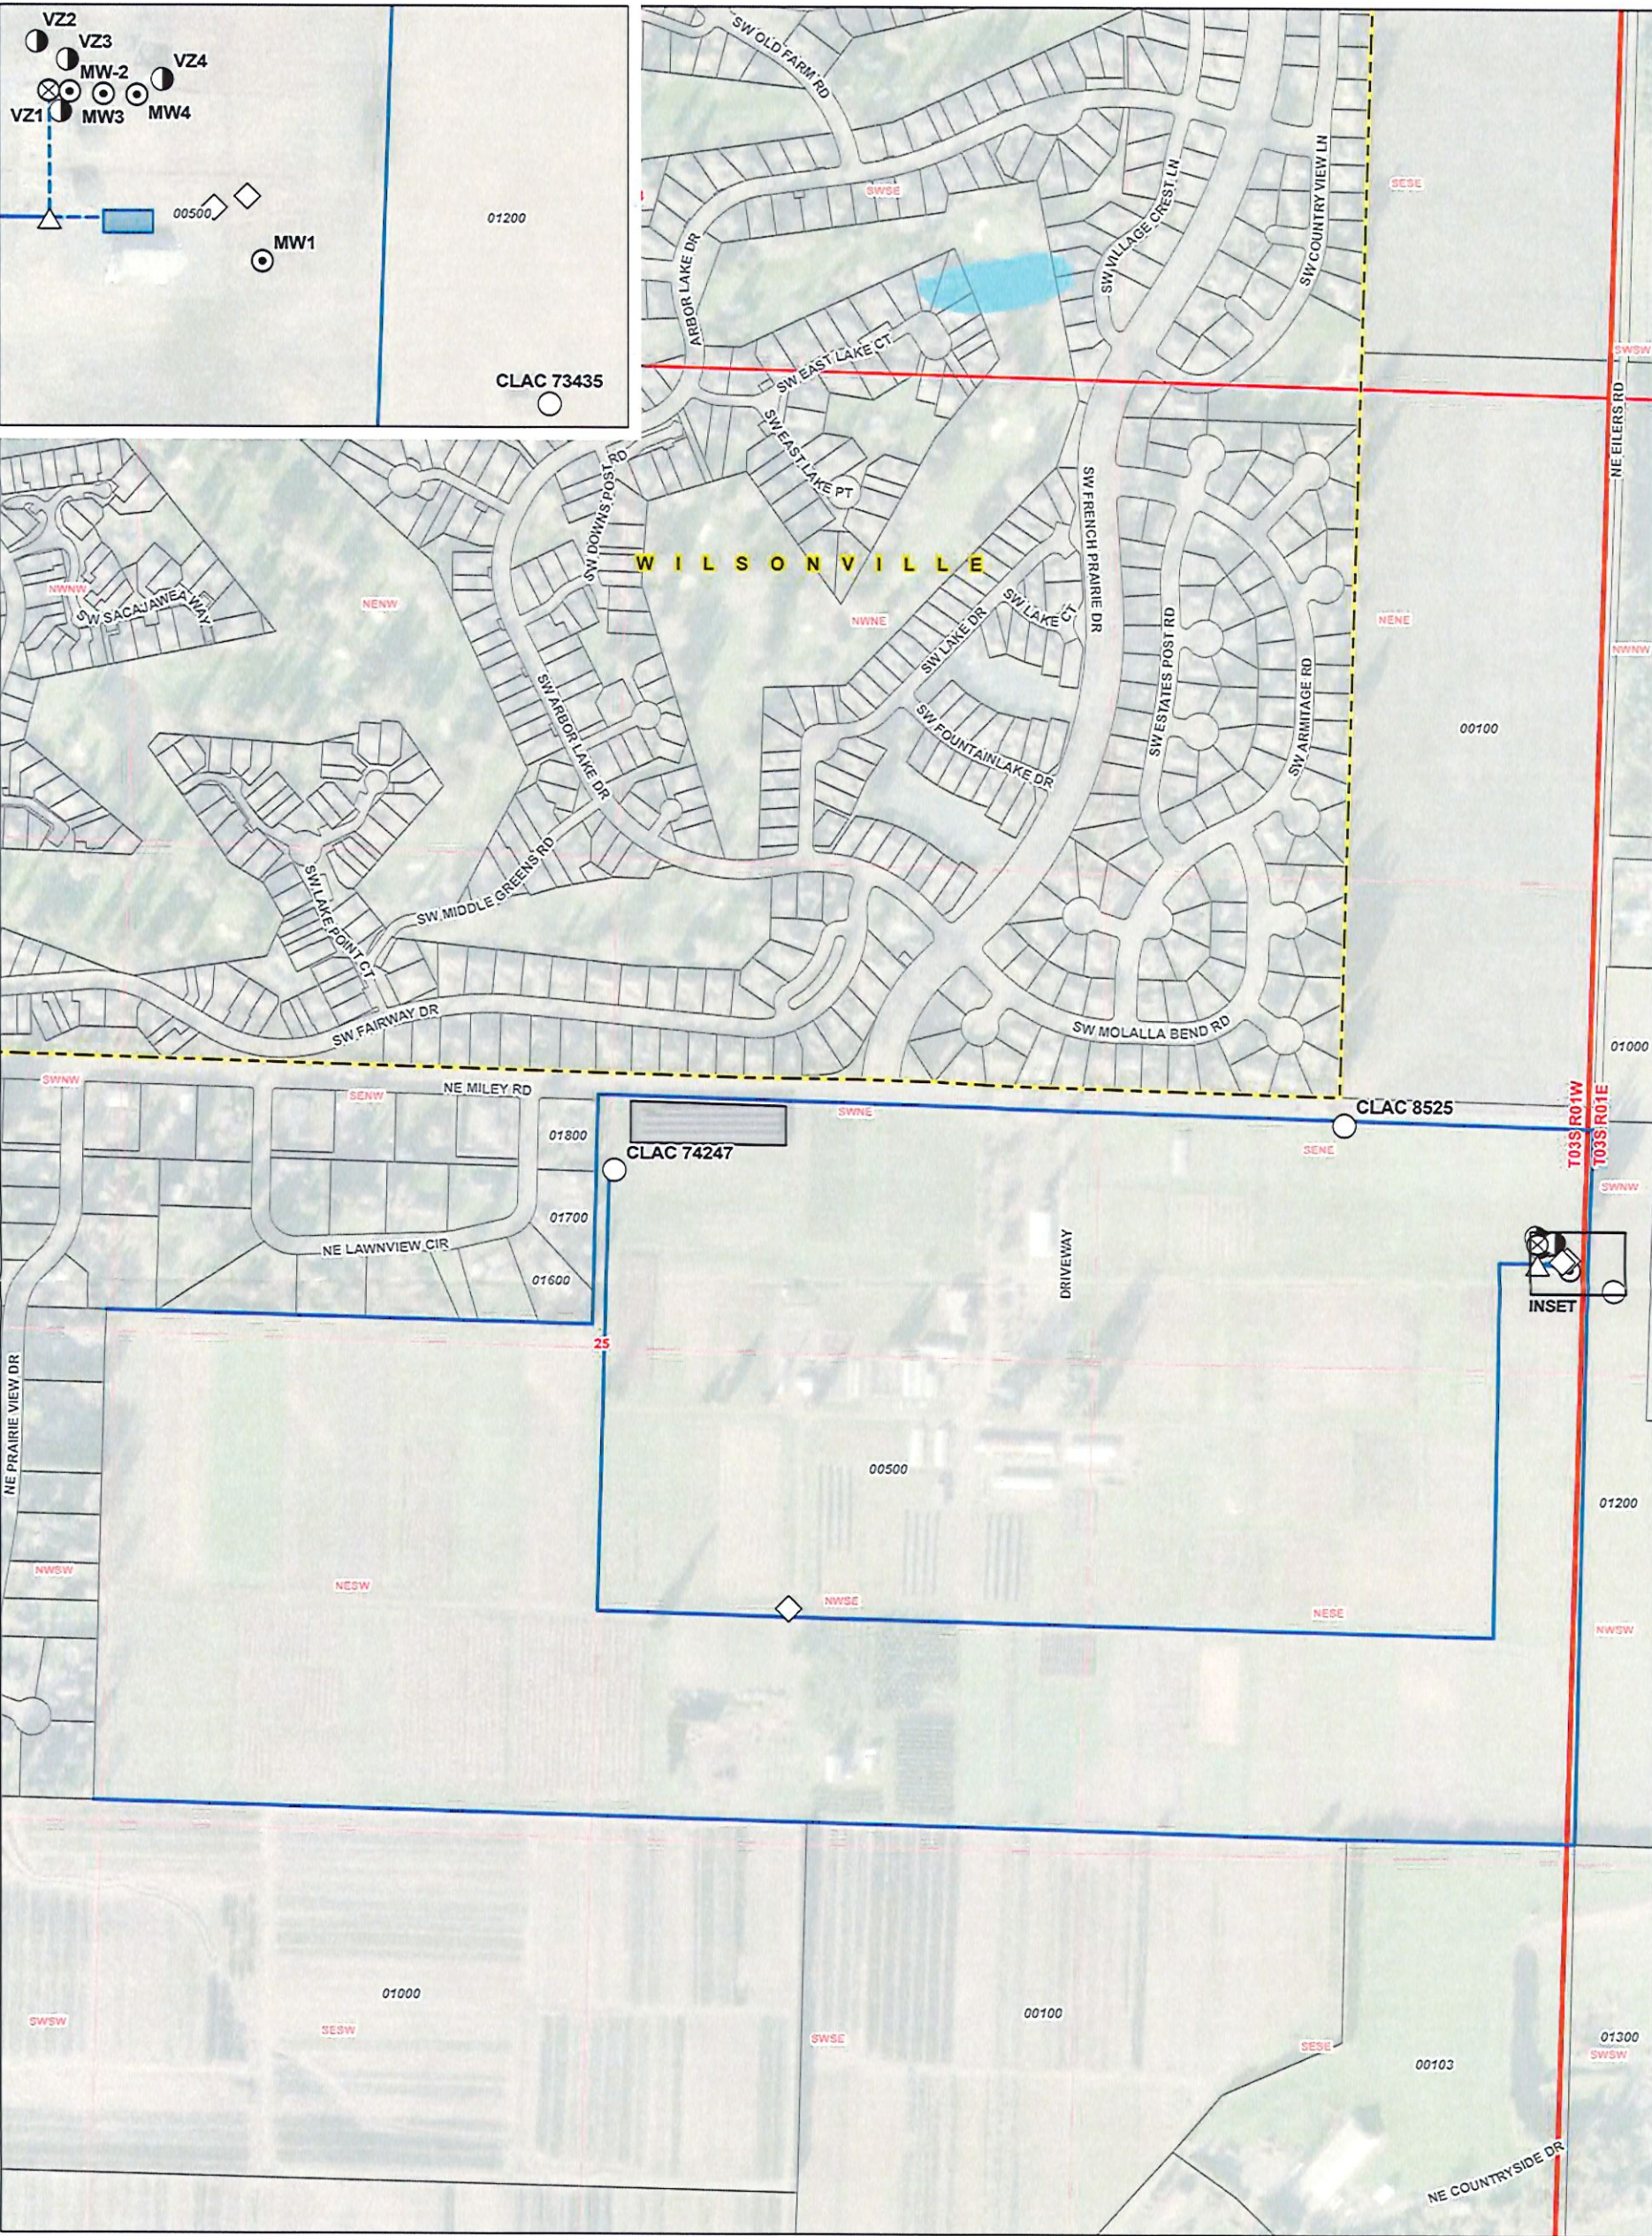

Superseded

LEGEND

- |                                 |                          |
|---------------------------------|--------------------------|
| Monitoring Well                 | Connection Pipe          |
| Vadose Zone Well                | Water Main               |
| Drywell                         | Infiltration Basin       |
| Well                            | Agrivoltaic Solar Panels |
| Pretreatment Ex-Situ Unit       | All Other Features       |
| Above Ground Water Storage Tank | City Boundary            |
|                                 | Tax Lot                  |

Date: May 11, 2026  
Data Sources: BLM, ESRI, ODOT, USGS, Imagery (2022)

Document Path: \\VMS\GIS\_Files\0863\_OSU\Source\_Figures\002\_AR\_Supprt\LL\_Appl\Figure1\_Artificial\_GW\_Recharge\_PLSS.aprx, Figure1\_Artificial\_GW\_Recharge\_PLSS, bramos

FIGURE 1  
Site Map of Proposed Project  
Limited License Application for  
Artificial Groundwater Recharge  
Oregon State University

