



GIS: C:\Users\haldrich\OneDrive - haldrich.com\Documents\ArcGIS\Projects\0214086-001 BAYHORSE SILVER MINE\BAYHORSE SILVER.mxd - 7/15/2026 1:32 PM

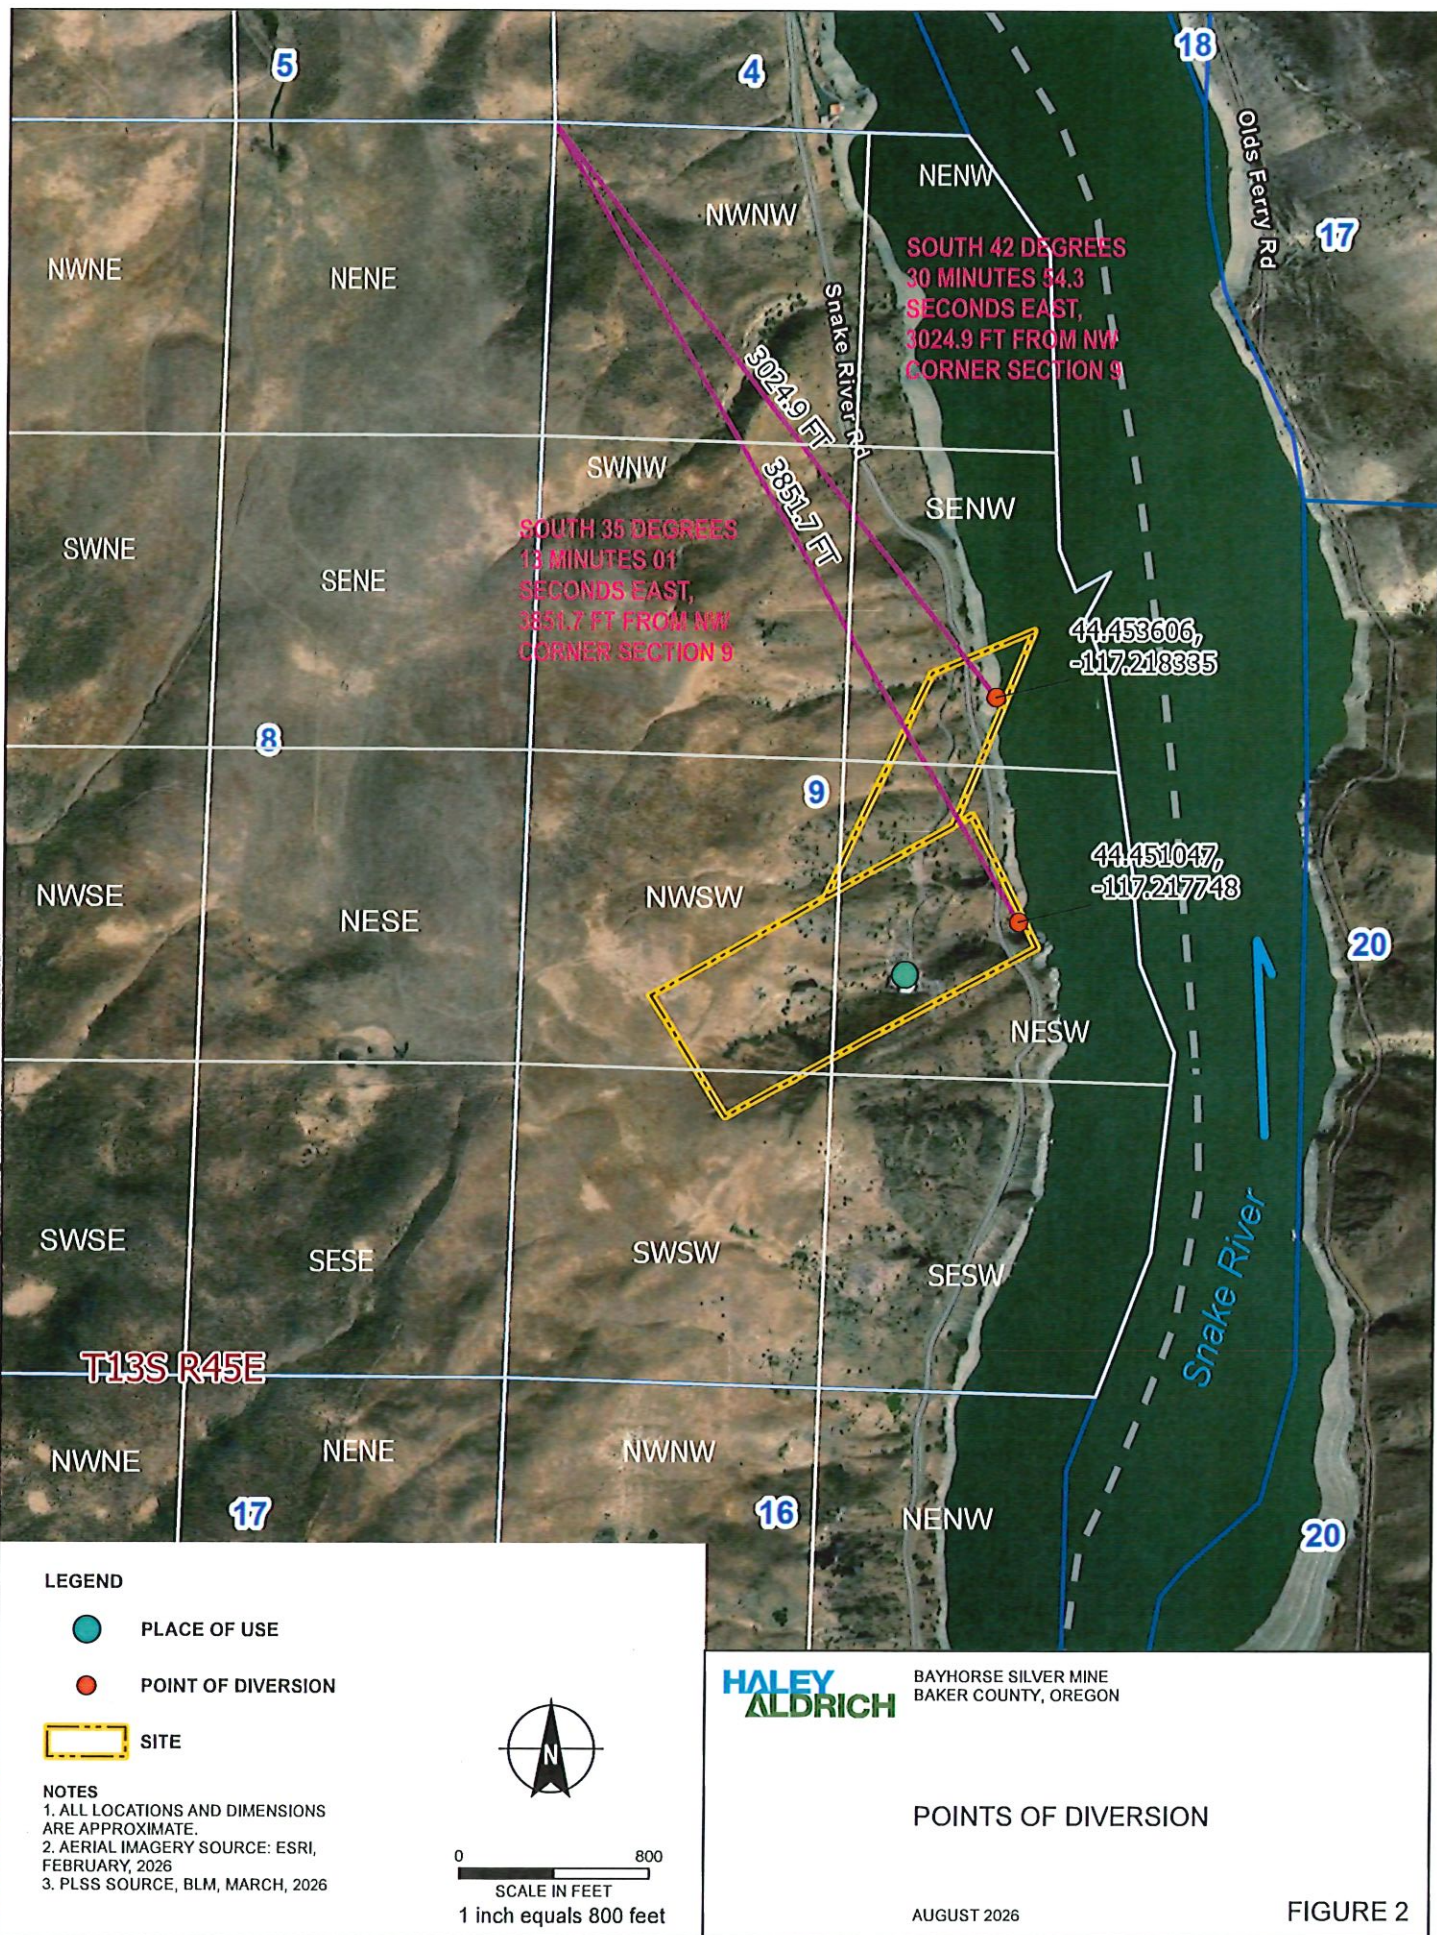

LL-2034

GIS: C:\Users\hahut\OneDrive - haleyaldrich.com\Documents\ArcGIS\Projects\0214686-001 BAYHORSE SILVER.aprx - hahut - 7/15/2026 11:11 AM

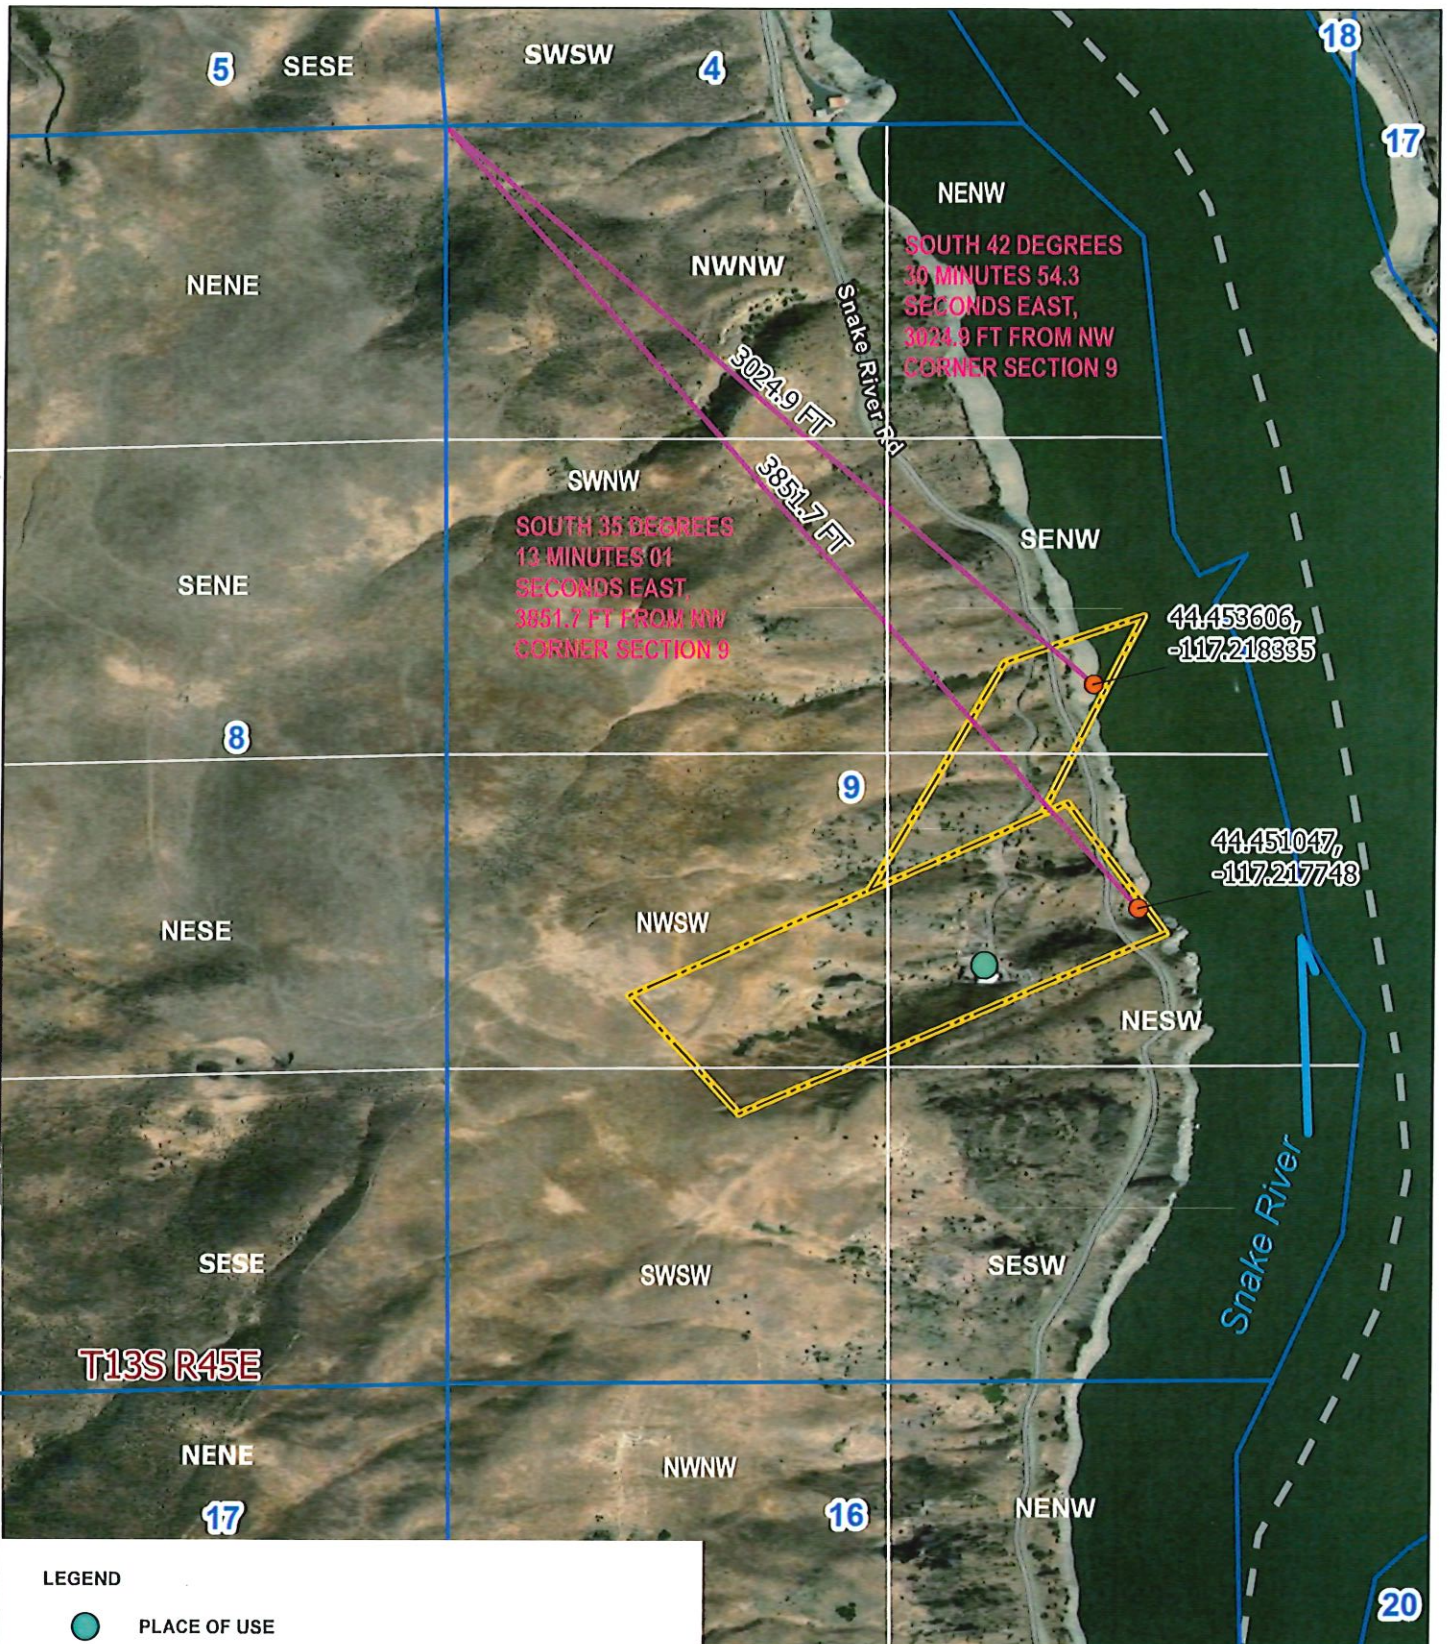


#### LEGEND

- PLACE OF USE
- POINT OF DIVERSION
- SITE

#### NOTES

1. ALL LOCATIONS AND DIMENSIONS ARE APPROXIMATE.
2. AERIAL IMAGERY SOURCE: ESRI, FEBRUARY, 2026
3. PLSS SOURCE, BLM, MARCH, 2026

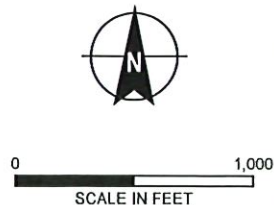

**HALEY  
ALDRICH**

BAYHORSE SILVER MINE  
BAKER COUNTY, OREGON

POINTS OF DIVERSION

JULY 2026


RECEIVED

AUG 03 2026

OWRD

FIGURE 2

*Superseded*

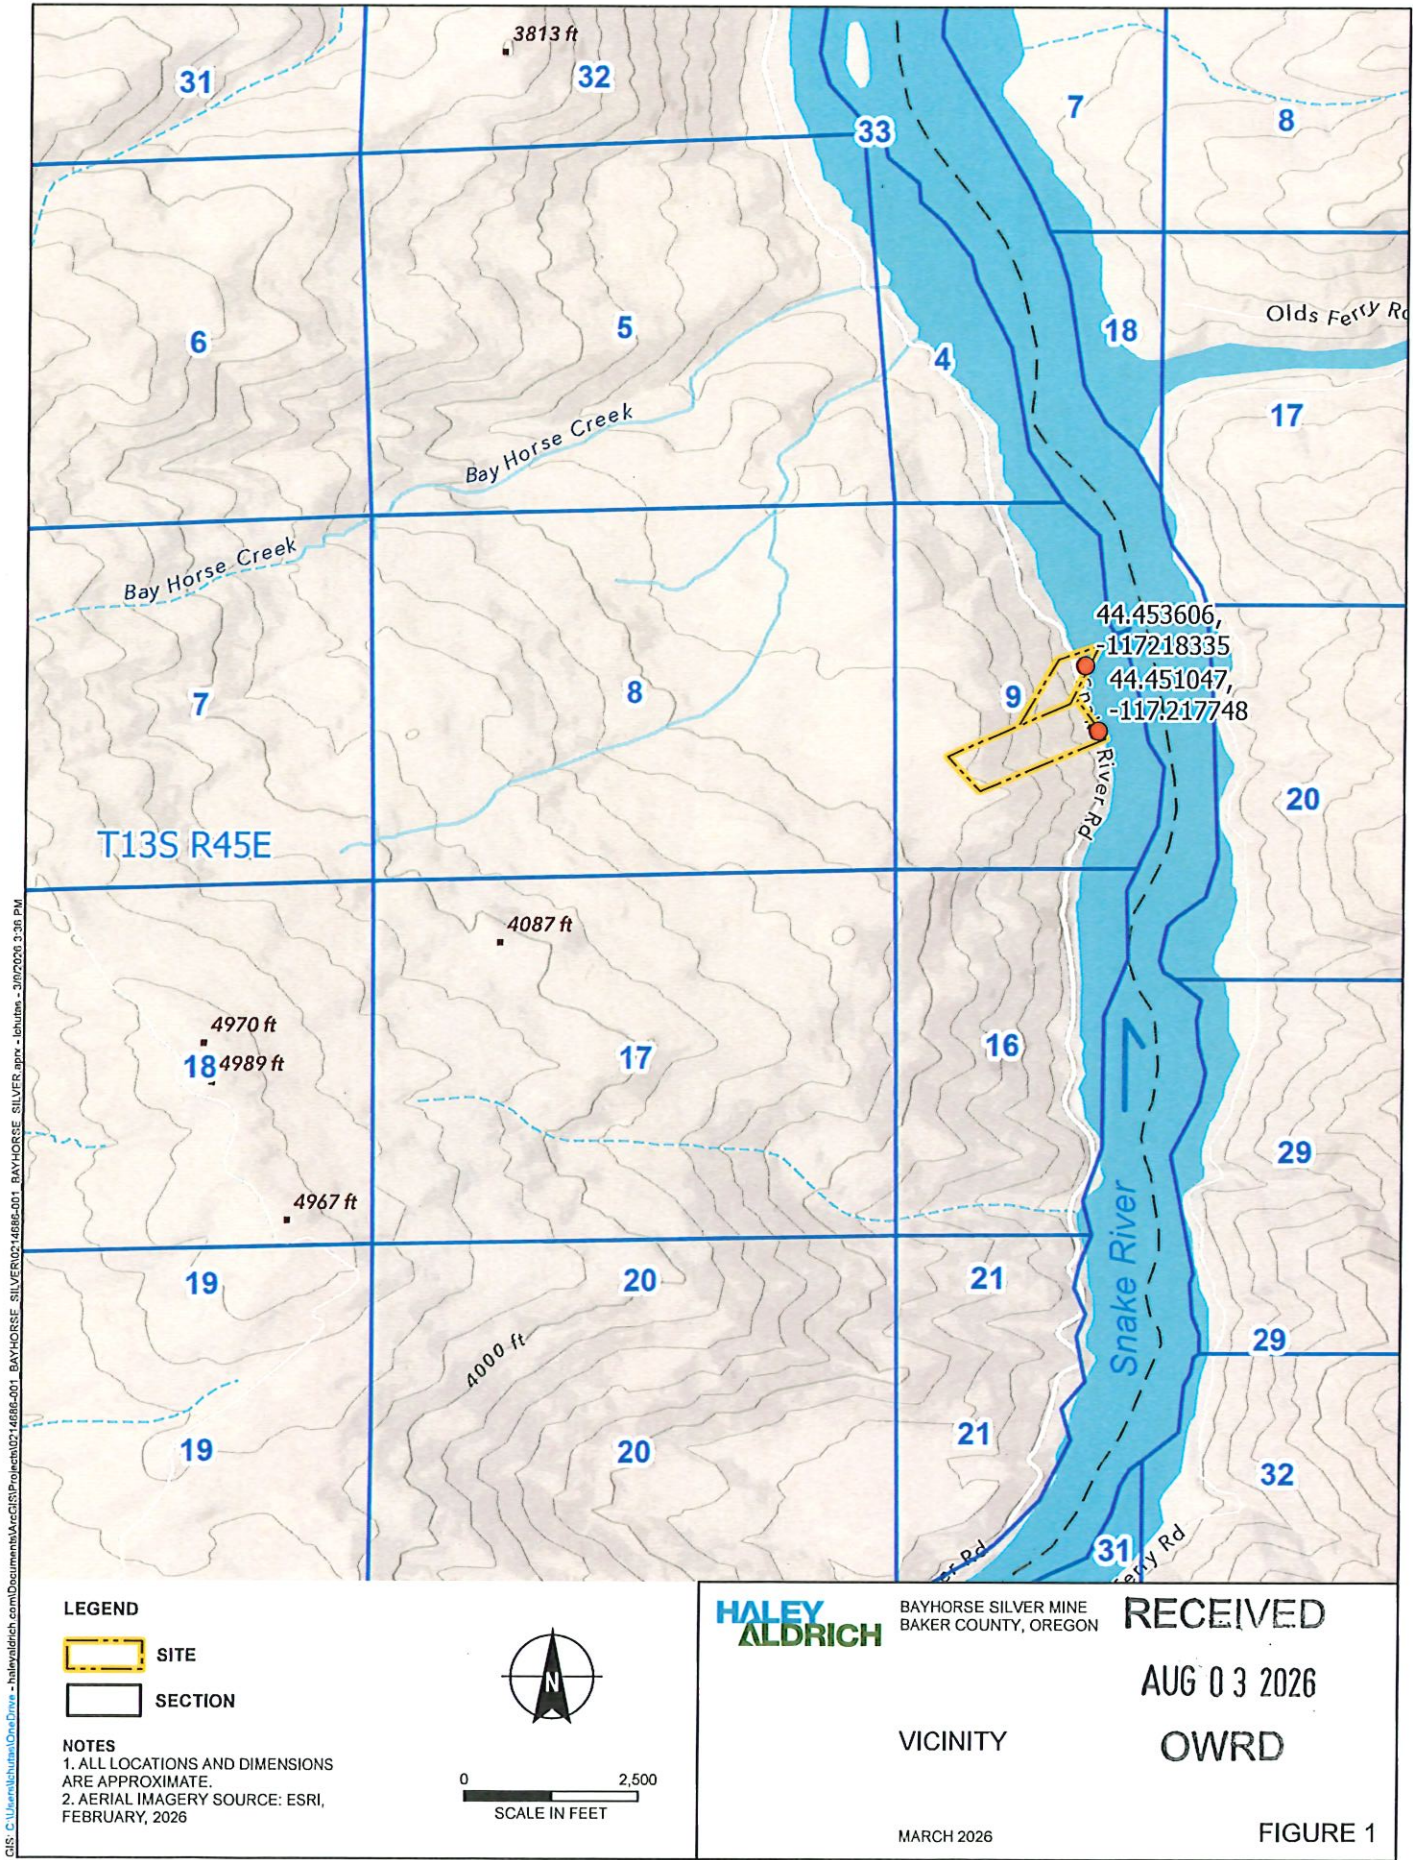

44-2034

100' 0 100' 200'

SCALE 1" = 100'

ALL DISTANCES SHOWN HERE ARE IN FEET UNLESS NOTED OTHERWISE



| LINE | LINE No. | BEARING      |
|------|----------|--------------|
| 1    | 130.07   | 51° 19' 30"  |
| 2    | 80.04    | 55° 33' 30"  |
| 3    | 129.06   | 53° 37' 30"  |
| 4    | 197.59   | 59° 11' 00"  |
| 5    | 103.05   | 180° 31' 00" |
| 10   | 64.80    | 57° 45' 30"  |
| 11   | 170.18   | 52° 45' 30"  |
| 12   | 121.05   | 55° 30' 00"  |
| 13   | 142.07   | 50° 00' 00"  |
| 14   | 129.06   | 53° 37' 30"  |
| 15   | 226.12   | 58° 16' 00"  |
| 16   | 80.07    | 51° 19' 30"  |
| 17   | 115.53   | 53° 41' 00"  |
| 18   | 78.04    | 59° 11' 00"  |
| 19   | 145.07   | 52° 45' 30"  |
| 20   | 259.12   | 51° 44' 00"  |
| 21   | 301.14   | 51° 44' 00"  |
| 22   | 44.52    | 53° 37' 30"  |
| 23   | 103.05   | 180° 31' 00" |
| 24   | 209.09   | 58° 16' 00"  |
| 25   | 78.04    | 59° 11' 30"  |
| 26   | 326.15   | 52° 45' 30"  |

**SURVEY FOR:**  
**BAYHORSE SILVER, INC.**

**CK3, LLC**

**ENGINEERING-SURVEYING & PLANNING**


ONTARIO

368 SW 5TH AVE.  
PHONE (541) 889-5411  
FAX (541) 889-2074

HERMISTON

945 W. ORCHARD AVE.  
HERMISTON, OR 97838  
PHONE (541) 567-2334  
FAX (541) 587-2305

|              |           |                   |             |          |          |
|--------------|-----------|-------------------|-------------|----------|----------|
| CHECKED BY:  | LCK       | FIELDBOOK No.     | O-352       | PAGE(S): | 3-8      |
| DRAWN BY:    | RAC       | DWG FILE No.:     | B-1331      |          |          |
| APPROVED BY: | LCK       | FILENAME:         | VO22013.dwg | JOB No.: | VO-22013 |
| DATE:        | 8/18/2002 | DATE RE-DESIGNED: |             |          |          |

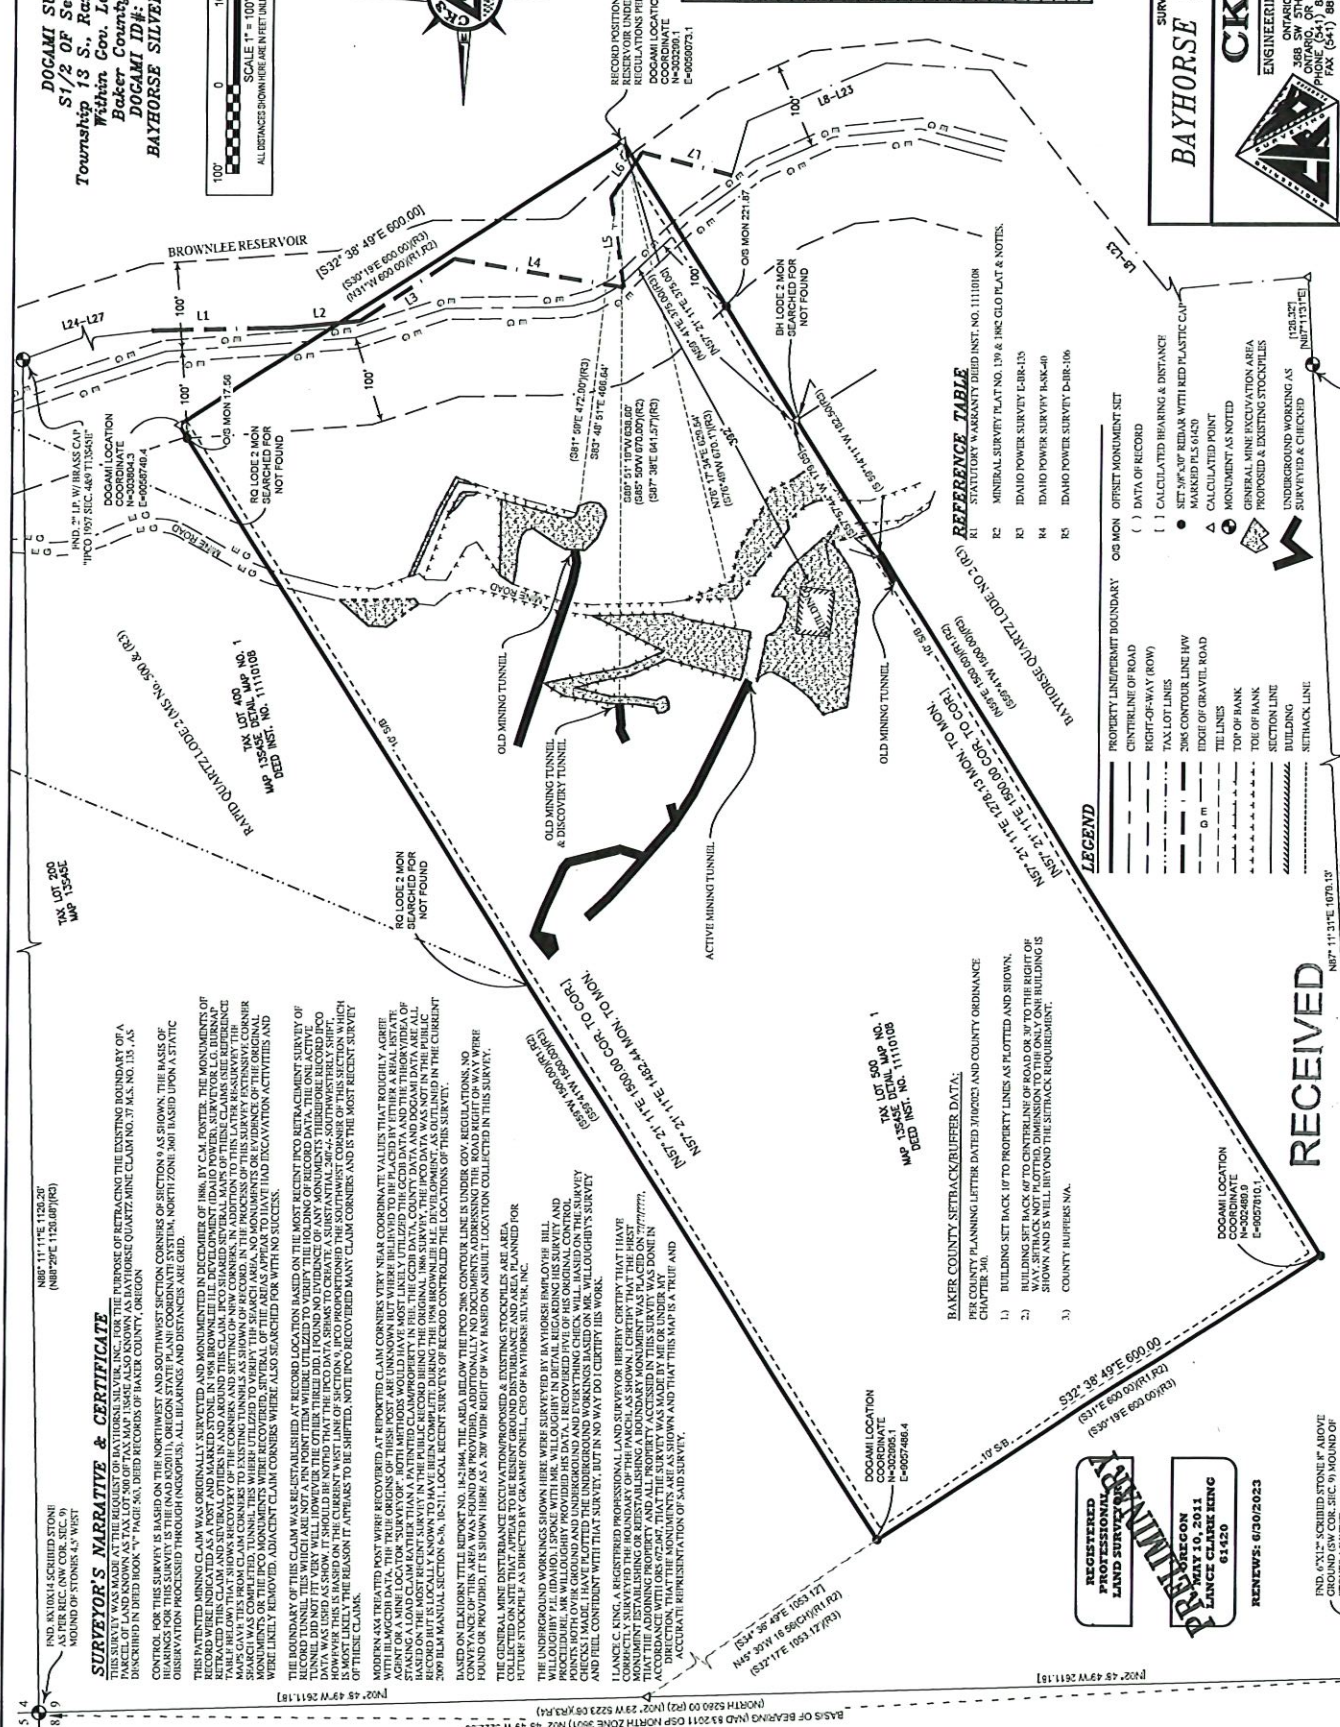

RECEIVED

AUG 03 2026

OWRD

# hh-2034