

T.16S. R.11E. Section 9, W.M.

Well (DESC 412, 62324, 65042) is located 635 feet north and 365 feet west from the SE corner, Section 9. (44.198233, -121.405306, WGS-84)

 Area (20.0 Acres) irrigated under Application G-11540, Permit G-10676


----- Tax lot boundary

..... Water main line



TL 16 11 0900 700

Scale: 1" = 400'

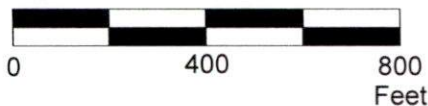

This map was prepared for the purpose of identifying the location of a water right only and is not intended to provide legal dimensions or location of property ownership lines.

Claim of Beneficial Use Map
Application G-11540, Permit G-10676

Jan Hupp
T.16S. R.11E. Section 9, W.M.

07/2026

 WILL MCGILL SURVEYING LLC

US 20

NESE

SESE

11.0

9.0

2.5'

2.5'

Well
(DESC 412,
62324, 65042)

Meter location

Bunk House

Received by OWRD

AUG 04 2026

Salem, OR

9 10
16 15