

● Well & Meter

□ Cistern

----- Pipeline

 Place of Use - Irrigation

— Section


----- Quarter Quarter

 Tax Lot




RENEWS: 06/30/2028

**T18S R14E, WM
DESCHUTES COUNTY, OR**

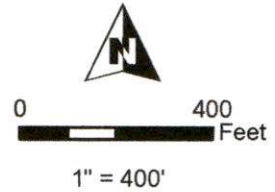

Well (DESC 56861/L-76715) Location:
1050' S, 830' W of N 1/4 Cor Sec 16
Lat: 44.017700 Long: -121.060083 WGS1984

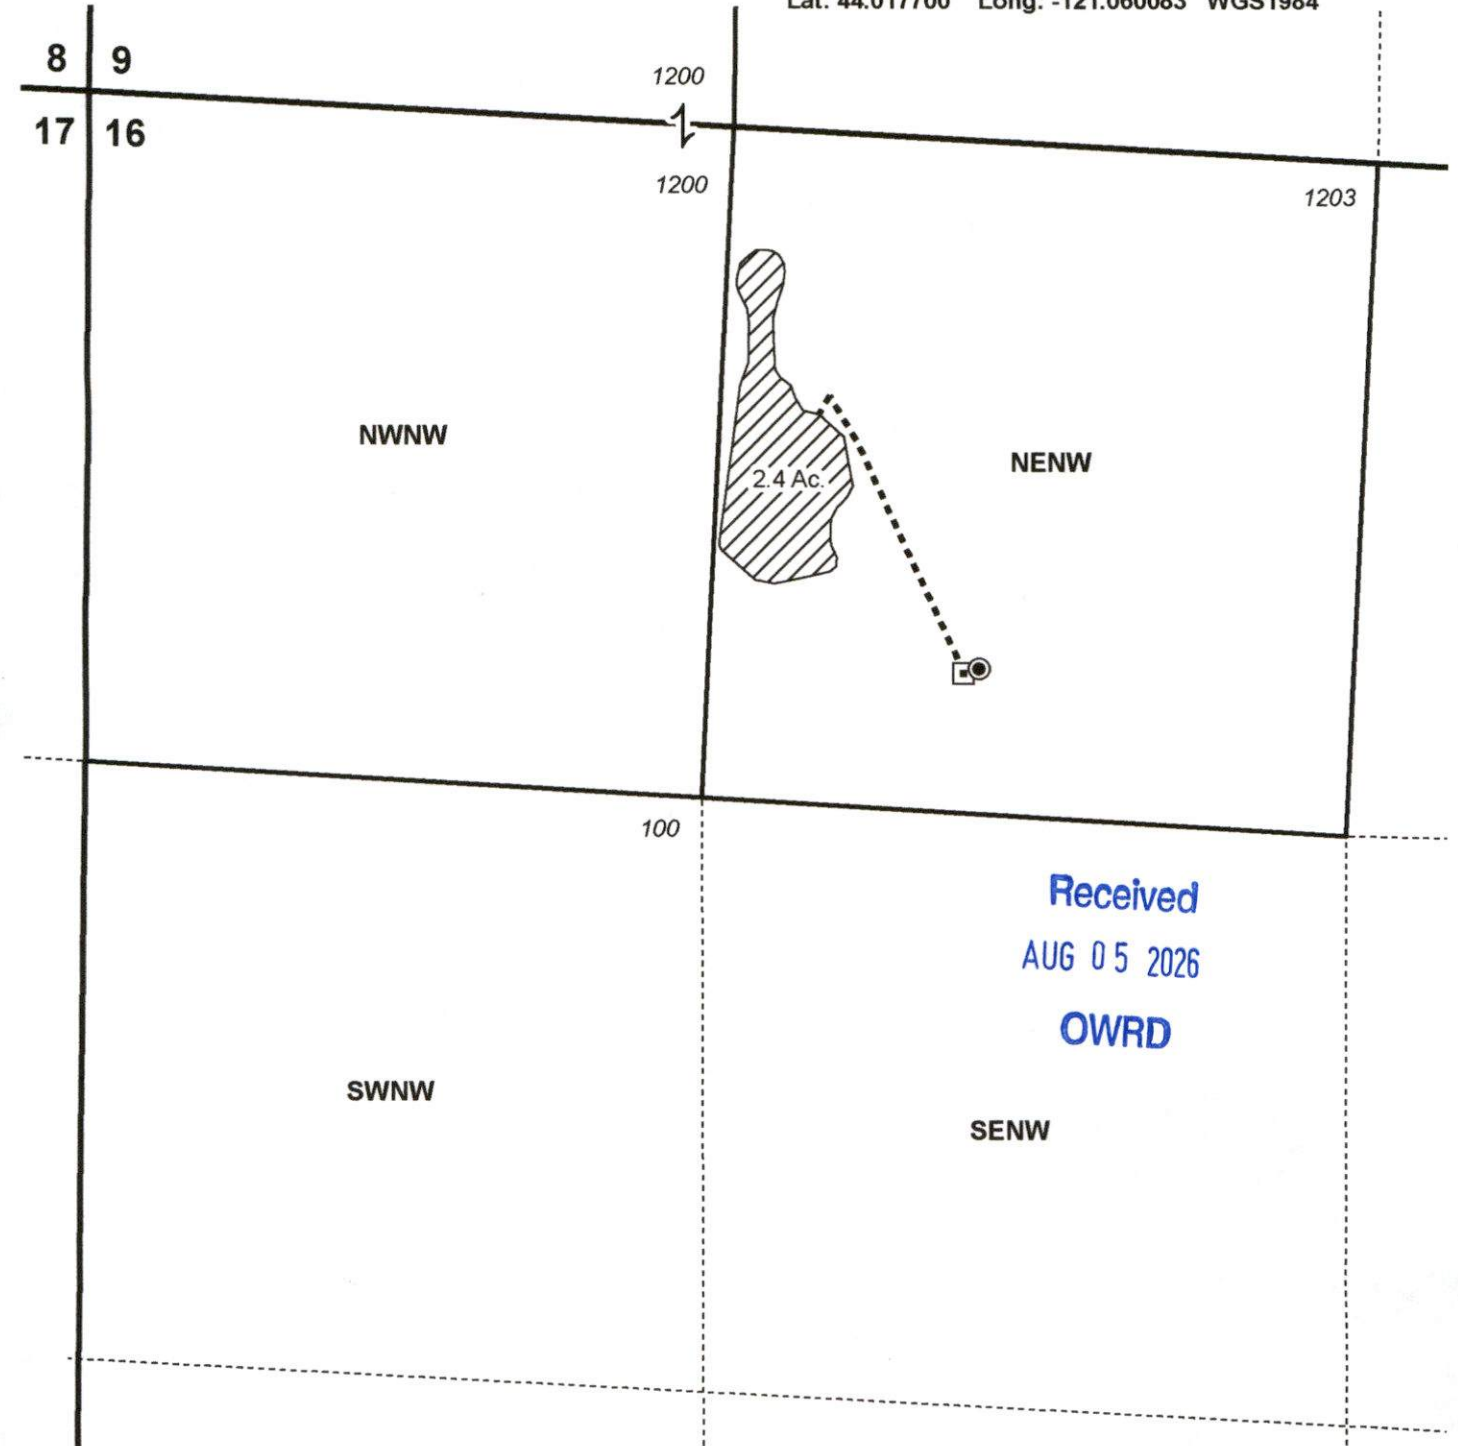

Received
AUG 05 2026
OWRD

CLAIM OF BENFICIAL USE MAP
Moss

Date: 7/19/2026 Ap G-16343 Permit G-16844

This map is not intended
to provide legal dimensions
or locations of property
ownership lines.

WATER RIGHT SERVICES, LLC
PO BOX 1830, BEND, OR 97709
WWW.OREGONWATER.US
info@oregonwater.us 541-389-2837