


Claim of Beneficial Use - A & S Investments LLC Transfer T-13619

Township 4S, Range 3W, W.M.

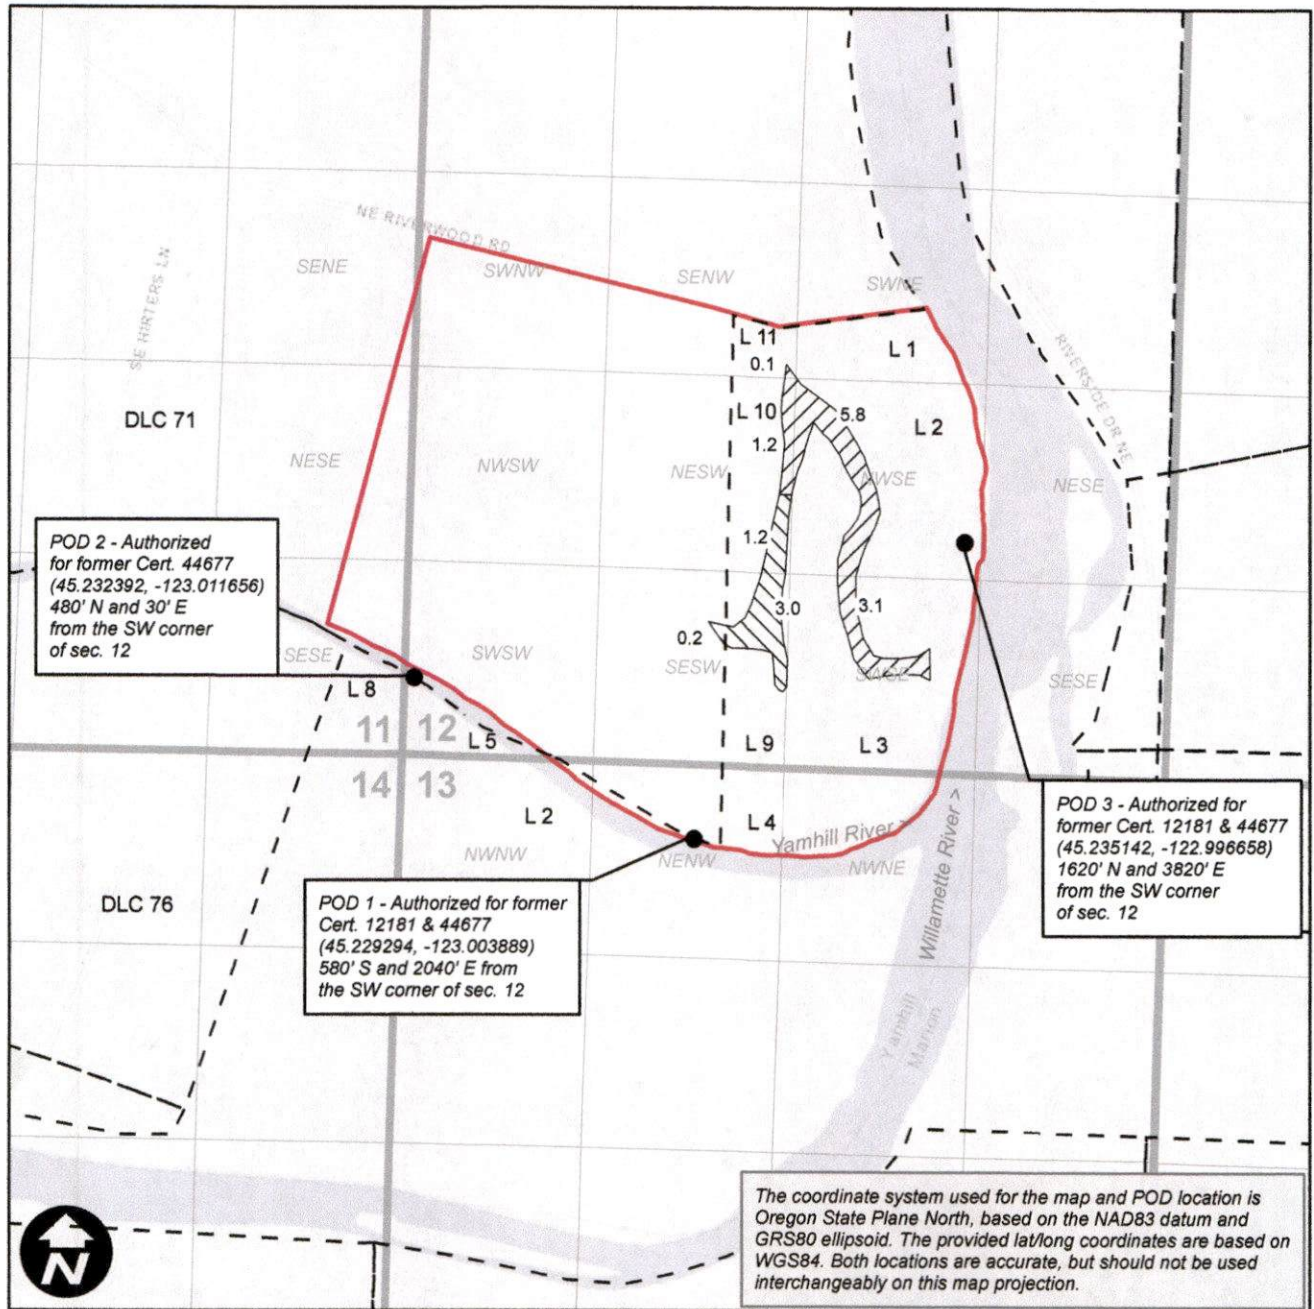

Legend

- IR POU - Former Cert. 12181
- Tax Lot 400
- IR POU - Former Cert. 44677
- DLC

Received by OWRD

AUG 06 2025

Salem, OR



EXPIRES: 12/31/2026