


CLAIM OF BENEFICIAL USE MAP


TO ADD PLACE OF USE AND A POINT OF DIVERSION
PER APPLICATION S-87508
FOR STEPHEN OLSON

SECTIONS 5 & 6, TOWNSHIP 27 SOUTH, RANGE 29 EAST, W.M.
TAX LOT 1000


SCALE: 4 INCHES = 1 MILE

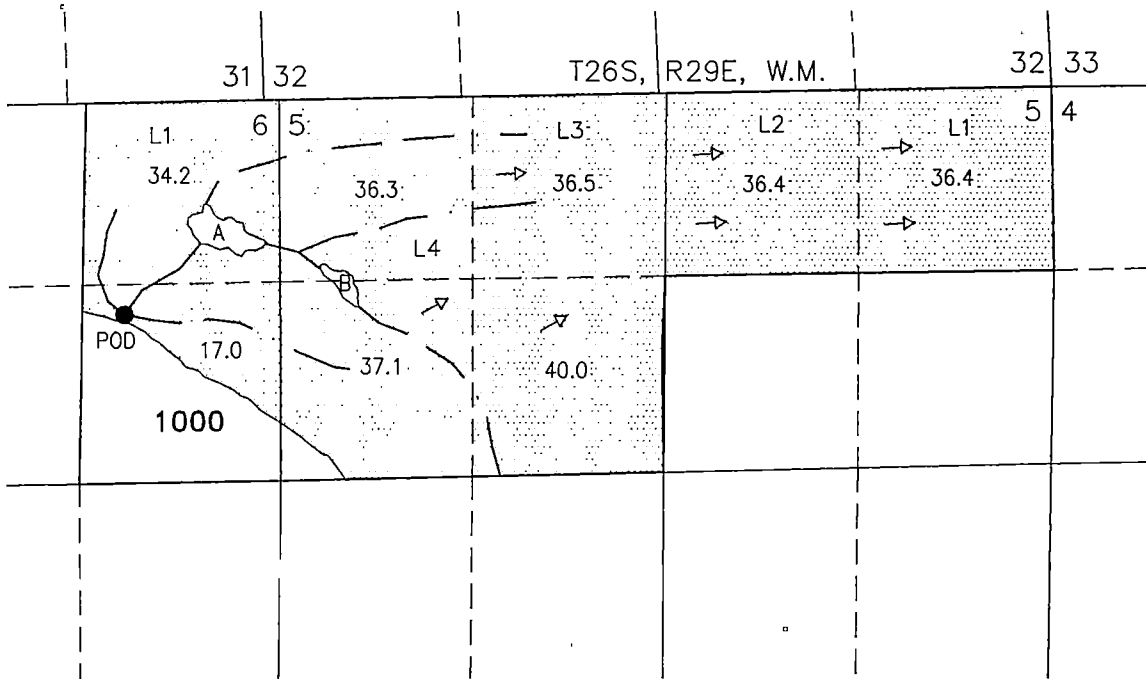

→ DIRECTED SHEET FLOW

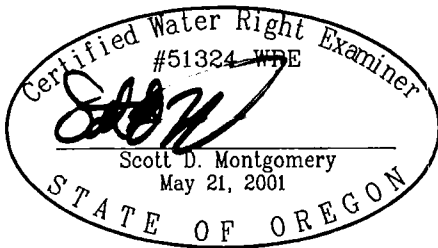

RENEWAL DATE: 12/31/2026

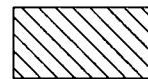

273.9 ACRES IR FROM
PERMIT S-54806, AS SHOWN.

● POD 43°15'41.11" N 119°16'51.82" W

SPRINGS IN THE SE 1/4 NE 1/4 SECTION 6, T27S R29E, W.M.
LOCATED 1450 FEET SOUTH AND 1070 FEET WEST FROM THE
NE CORNER OF SECTION 6.

METER IS APPROXIMATELY 10 FEET W'LY ALONG
DELIVERY CANAL FROM SPRINGS.

THIS MAP IS FOR THE PURPOSE OF LOCATING A WATER
RIGHT ONLY AND HAS NO INTENT TO PROVIDE LEGAL
DIMENSIONS OR THE LOCATION OF PROPERTY LINES

PREPARED FOR:

STEPHEN OLSON
P.O. BOX 428
HINES, OR 97738

PREPARED BY:



ALL POINTS ENGINEERING AND SURVEYING, INC.
P.O. BOX 767
(541) 548-5833
TERREBONNE, OR 97760
www.APEandS.com