


# T.6S. R.3W. Section 13, W.M.

Received by OWRD  
AUG 12 2026  
Salem, OR

CERTIFIED WATER RIGHT EXAMINER  
85503  
DOAN HAMILTON  
MAY 10, 2012  
STATE OF OREGON  
740-302027

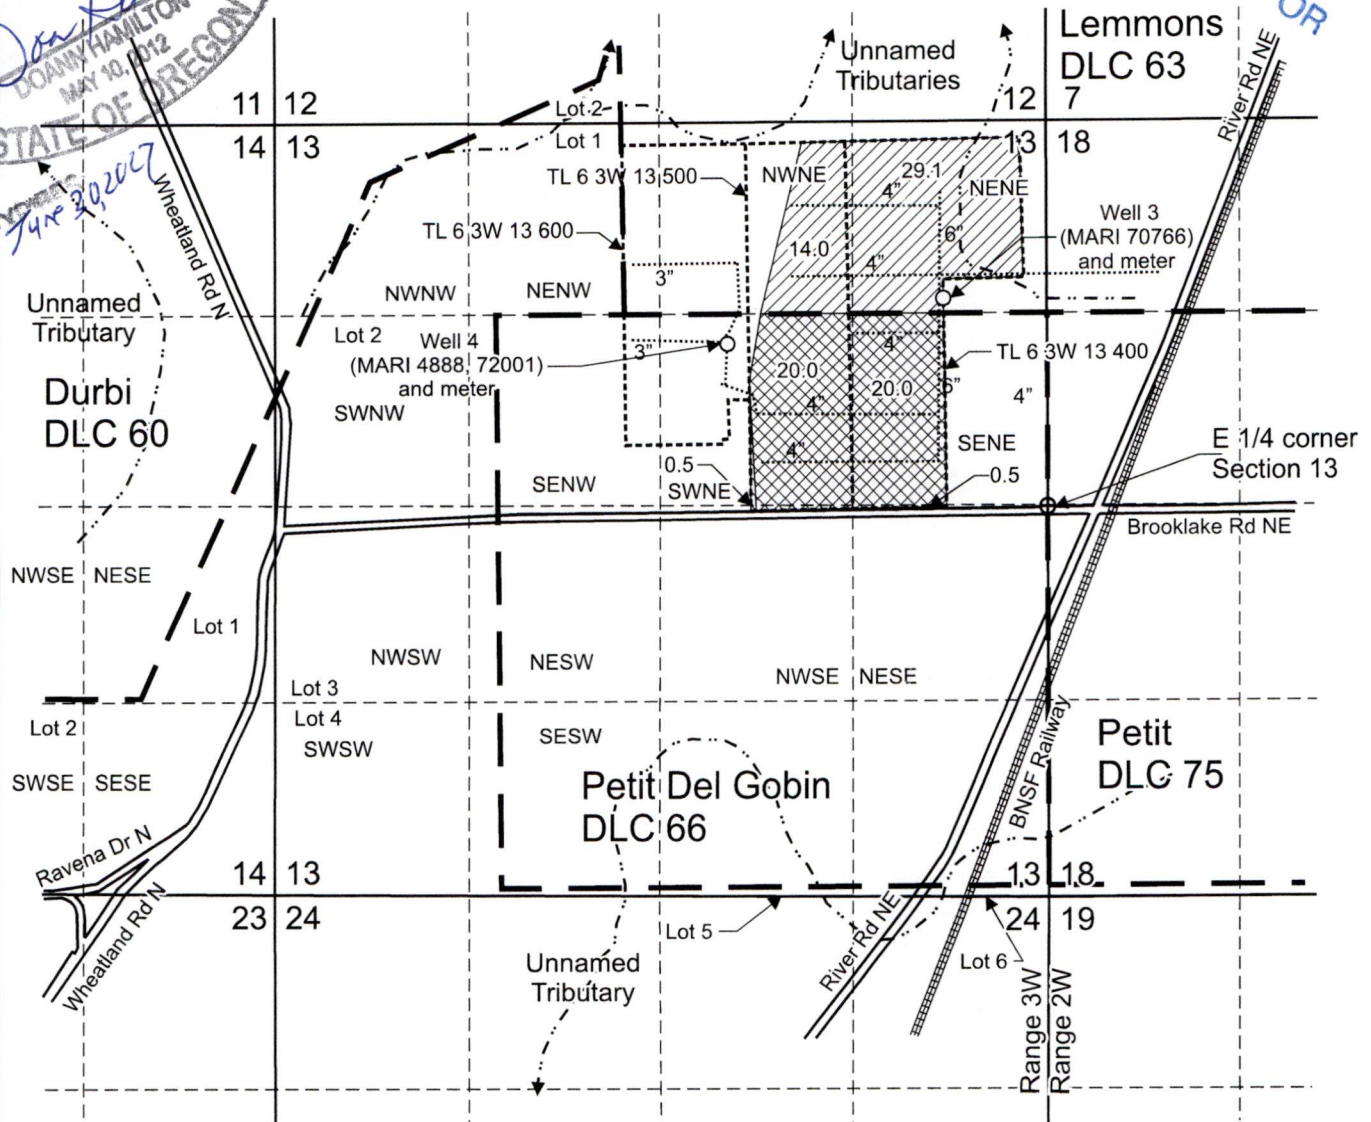

Well 3 (MARI 70766) is located 1,410 feet north and 650 feet west from the E 1/4 corner, Section 13.  
(45.053544, -122.991992, WGS 84)

Well 4 (MARI 4888, 72001) is located 1,110 feet north and 2,190 feet west from the E 1/4 corner, Section 13.  
(45.05279000, -122.99788300, WGS 84)

Area (43.1 Acres) primary irrigation under T-14251, formerly Certificate 50713, priority date 2-22-1977, using Well 3 and 4,

Area (41.0 Acres) supplemental irrigation under T-14251, formerly Certificate 50713, priority date 2-22-1977, using Well 3 and 4, primary GR-3046 using Well 3 and 4 pending T-14252.

----- Tax lot boundary      - - - - - Donation Land Claim boundary      ..... Water main line

Scale: 1" = 1,320'



This map was prepared for the purpose of identifying the location of a water right only and is not intended to provide legal dimensions or location of property ownership lines.

**Claim of Beneficial Use Map**  
**T-14251, formerly Certificate 50713**

**WM**  
**WILL MCGILL SURVEYING LLC**

07/2026


Willamette Tree  
T.6S, R.3W. Section 13, W.M.

WillametteTreeCert50713T-1421C10BUMap.cdr

# T.6S. R.3W. Section 13, W.M.

Received by OWRD  
AUG 12 2026  
Salem, OR

DESIGNED WATER RIGHT EXAMINER  
85503  
DOANN HAMILTON  
MAY 11 2012  
STATE OF OREGON  
JUN 30 2017

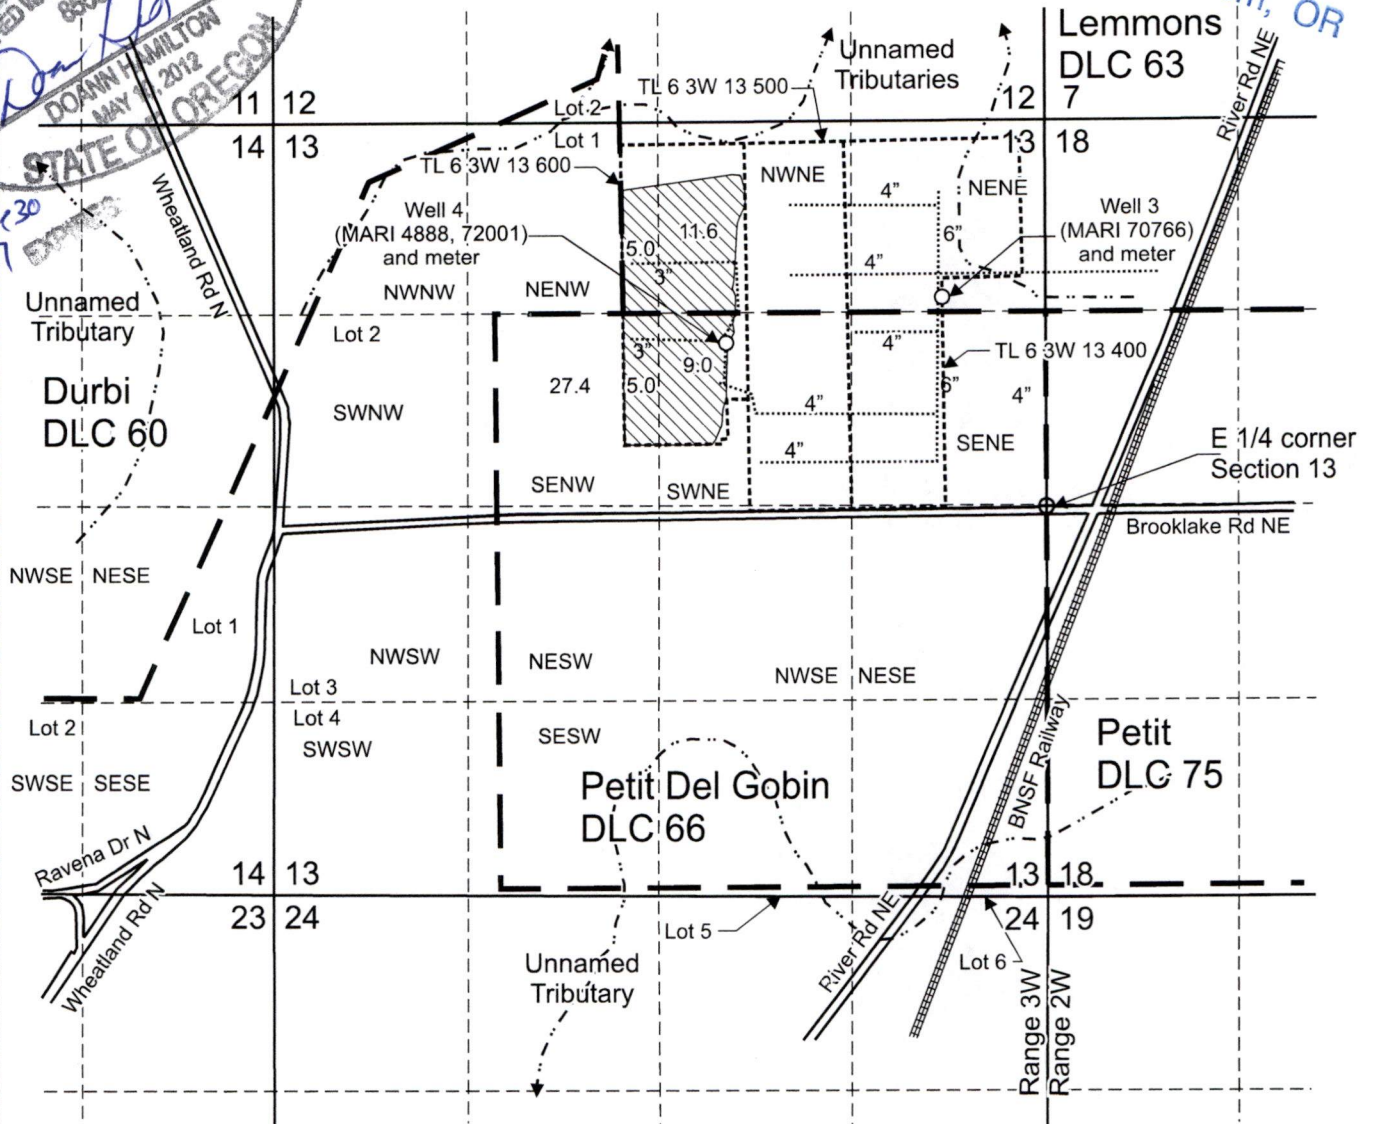

Well 3 (MARI 70766) is located 1,410 feet north and 650 feet west from the E 1/4 corner, Section 13.  
(45.053544, -122.991992, WGS 84)

Well 4 (MARI 4888, 72001) is located 1,110 feet north and 2,190 feet west from the E 1/4 corner, Section 13.  
(45.05279000, -122.99788300, WGS 84)

 Area (30.6 Acres) irrigated under T-14251, formerly Certificate 40295, priority date 1-29-1970.

----- Tax lot boundary      — ■ — Donation Land Claim boundary      ..... Water main line

Scale: 1" = 1,320'



This map was prepared for the purpose of identifying the location of a water right only and is not intended to provide legal dimensions or location of property ownership lines.

**Claim of Beneficial Use Map**  
**T-14251, formerly Certificate 40295**

Willamette Tree Wholesale  
T.6S, R.3W. Section 13, W.M.

 **WILL MCGILL SURVEYING LLC**

07/2026