

**CLAIM OF
BENEFICIAL USE
for Reservoirs storing less than
9.2 acre-feet permitted under
ORS 537.409**



Oregon Water Resources Department
725 Summer Street NE, Suite A
Salem, Oregon 97301-1266
(503) 986-0900
www.oregon.gov/OWRD

Received
AUG 12 2026
OWRD

A fee of \$345 must accompany this form.

This form may be completed by the permit holder of record if:

- 1) The permit was issued under the authority of ORS 537.409; and
- 2) No secondary permit exists for the use of water stored in the reservoir; and
- 3) The developed capacity of the reservoir is less than 9.2 acre-feet; and
- 4) The water was stored by the date required in the permit; and

A separate form shall be completed for each permit.

This form must be submitted to the Water Resources Department within one year of storage of water in the reservoir.

Please type or print in dark ink. If the data provided is found to contain errors or omissions, it may be returned. The Department may require the submittal of additional information.

If you have questions regarding the completion of this form, please call 503-986-0900.

**SECTION 1
GENERAL INFORMATION**

File Information:

APPLICATION # R- 87814	PERMIT # R- 15004
---------------------------	----------------------

Applicant Information:

APPLICANT NAME Brian & Tracie Mahon		PHONE NO. 503.784.4880	ADDITIONAL CONTACT NO. 503.857.8382	
ADDRESS 11645 NE Finn Hill Loop				
CITY Carlton	STATE OR	ZIP 97111	E-MAIL bmahon1964@gmail.com sassafras918@gmail.com	

SECTION 2
RESERVOIR INFORMATION

Received
AUG 12 2026
OWRD

Reservoir Dimensions and Capacity:

AVERAGE LENGTH	AVERAGE WIDTH	AVERAGE DEPTH	MAXIMUM CAPACITY IN ACRE-FEET
300'	130'	10'	9 (8.95)

To determine capacity in acre-feet use for the above table, use the following calculation:

$$\text{Acre-feet} = \frac{(\text{Average Length})(\text{Average Width})(\text{Average Depth})}{43,560}$$

SECTION 3

MAP

Attach a map identifying the reservoir location. If the water right application map accurately reflects the location of the reservoir, you may attach a copy of it. Otherwise, you must submit a map meeting the standards of OAR 690-305-0000, which are attached.

If you'd like your map reviewed prior to submittal, please email:

WRD_DL_wr.certificates@water.oregon.gov


Preparation of the map by a Certified Water Rights Examiner is **not** required for this type of permit, but may be submitted.


SECTION 4

SIGNATURE

This Claim of Beneficial Use must be signed by each permit holder of record.

By my signature, I certify that the information contained herein is true and correct to the best of my knowledge.

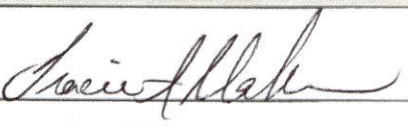SIGNATURE	PRINT OR TYPE NAME	TITLE	DATE
	Tracie A. Mahon		8/10/26
	Brian R. Mahon		8/10/26

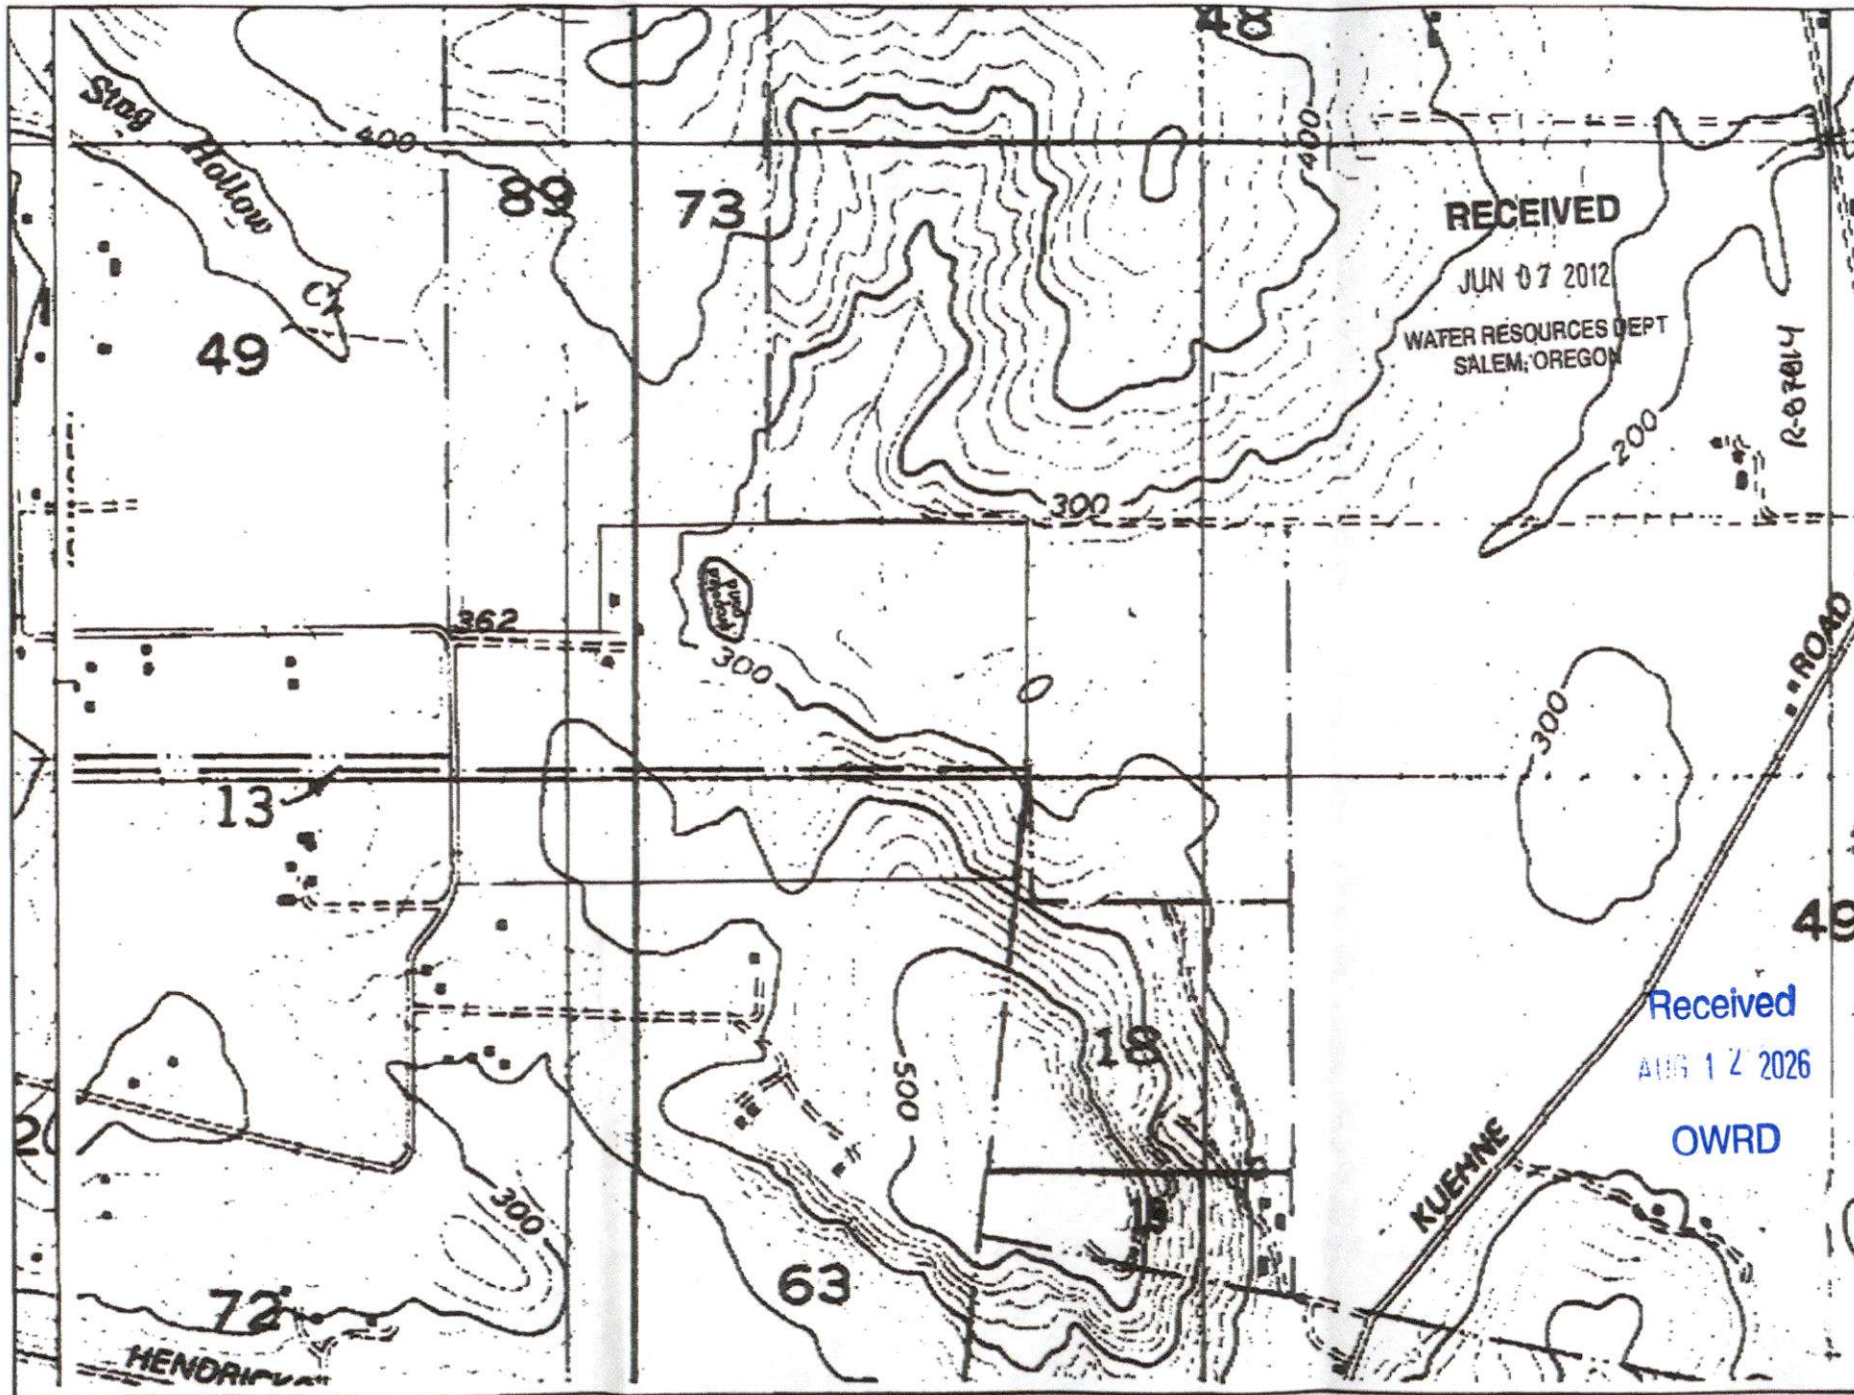

T: 3S R: 4W

Copyright (C) 1998, Maptech, Inc.

45°18'39" N 123°06'47" W