


MAP FOR
Claim of Beneficial Use
Sections 9, 10, 15, 16, T4S, R1W, Marion County
Transfer T-14500



1 IN = 1320 FT
0 660 1320

Received
AUG 07 2026

OWRD

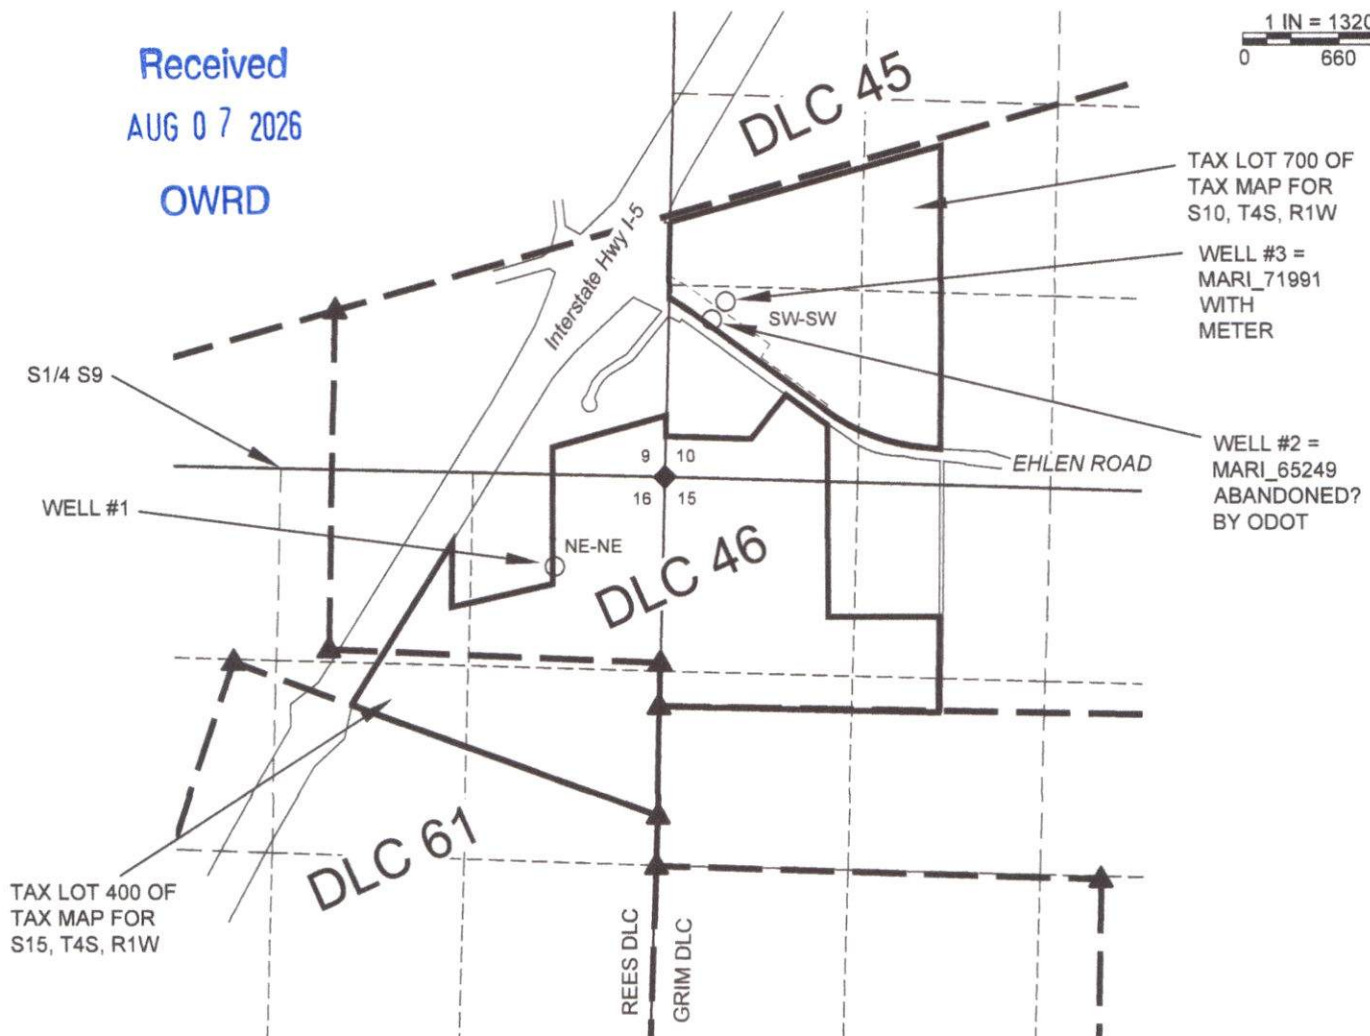

LOCATIONS OF POD'S

- WELL #1 (ORIGINAL) 620' S & 730' W FROM NE CORNER SECTION 16 (PER CERTIFICATE 42315). LAT & LONG UNAVAILABLE.
- WELL #2 (ABANDONED?) 1000' N & 2960' E OF SOUTH 1/4 SECTION 9.
- WELL #3 (NEW) 1000' N & 2960' E OF SOUTH 1/4 SECTION 9 & LAT. 45.234013°, LONG. -122.803832°, WGS84.

NOTES:

- THIS MAP IS NOT INTENDED TO PROVIDE LEGAL DIMENSIONS OR LOCATIONS OF PROPERTY OWNERSHIP LINES.
- PROPERTY LINES AND QUARTER-QUARTER LINES ARE BASED ON THE TAX ASSESSOR MAP FOR SECTIONS 10, 15 & 16 OF T4S, R1W.
- WATER CONVEYANCE LINES ARE NOT REQUIRED FOR THIS MAP.
- THIS MAP IS NOT INTENDED TO SHOW IRRIGATION AREAS



EXP. 30 JUN 2028

LEGEND

- ▲ DONATION LAND CLAIM (DLC) CORNER
- ◆ SECTION CORNER
- POINT OF DIVERSION (WELL)
- STREAM OR SURFACE DRAINAGE
- TAX LOT LINE
- SECTION LINE
- - - QUARTER-QUARTER LINE
- DLC LINES

MAP BY:
**ASPEN RURAL LAND
CONSULTING**
ERIC URSTADT, PE, PLS
971-250-1520
JUL 2026
OR T&T-DONALD4D