


CLAIM OF BENEFICIAL USE MAP

TO ADD A POINT OF APPROPRIATION AND PLACE OF USE
FOR PERMIT APPLICATION G-17572

SECTIONS 15, 16, AND 22 TOWNSHIP 40 SOUTH, RANGE 20 EAST
TAX LOTS 3200, 3300, 3400, & 3500

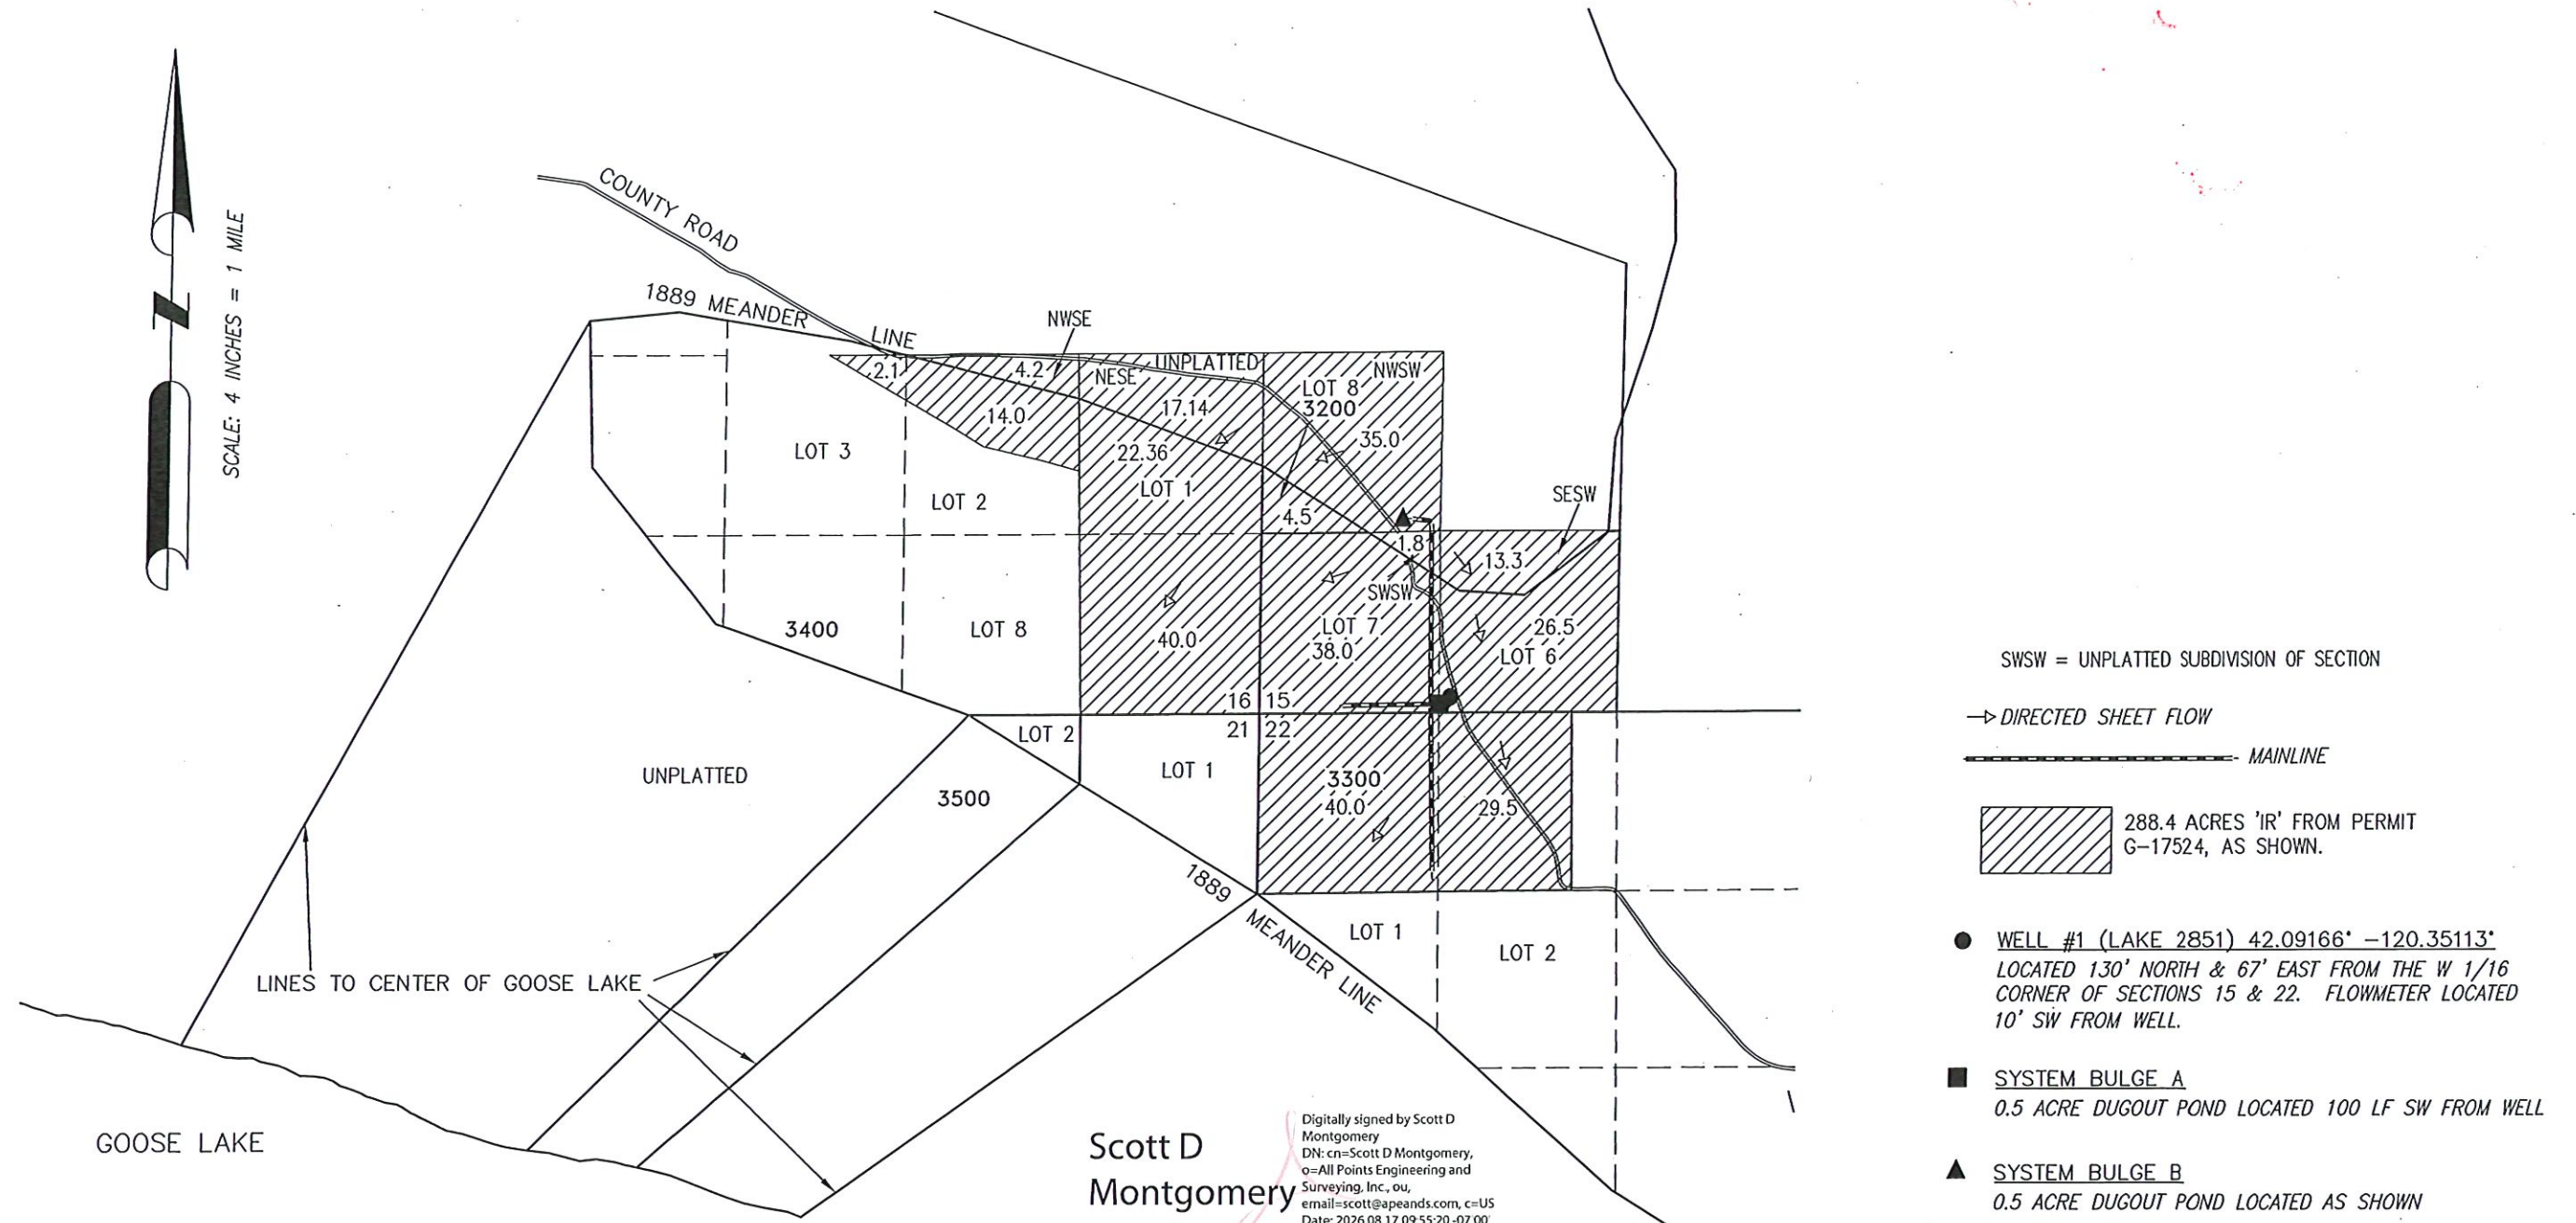


PREPARED FOR:

CHAYLON & AMBER SHUFFIELD
P.O. BOX 31
SUMMER LAKE, OR 97640

PREPARED BY:



ALL POINTS ENGINEERING AND SURVEYING, INC.
P.O. BOX 767 TERREBONNE, OR 97760
(541) 548-5833 www.APEandS.com

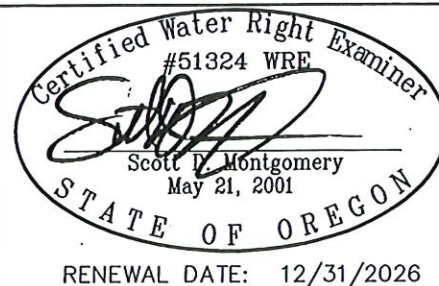

THIS MAP IS FOR THE PURPOSE OF
LOCATING A WATER RIGHT ONLY AND HAS
NO INTENT TO PROVIDE LEGAL DIMENSIONS
OR THE LOCATION OF PROPERTY LINES

Received by OWRD

AUG 17 2026

Salem, OR