



SECTION 22, T.2S., R.2W., W.M.
WASHINGTON COUNTY, OREGON

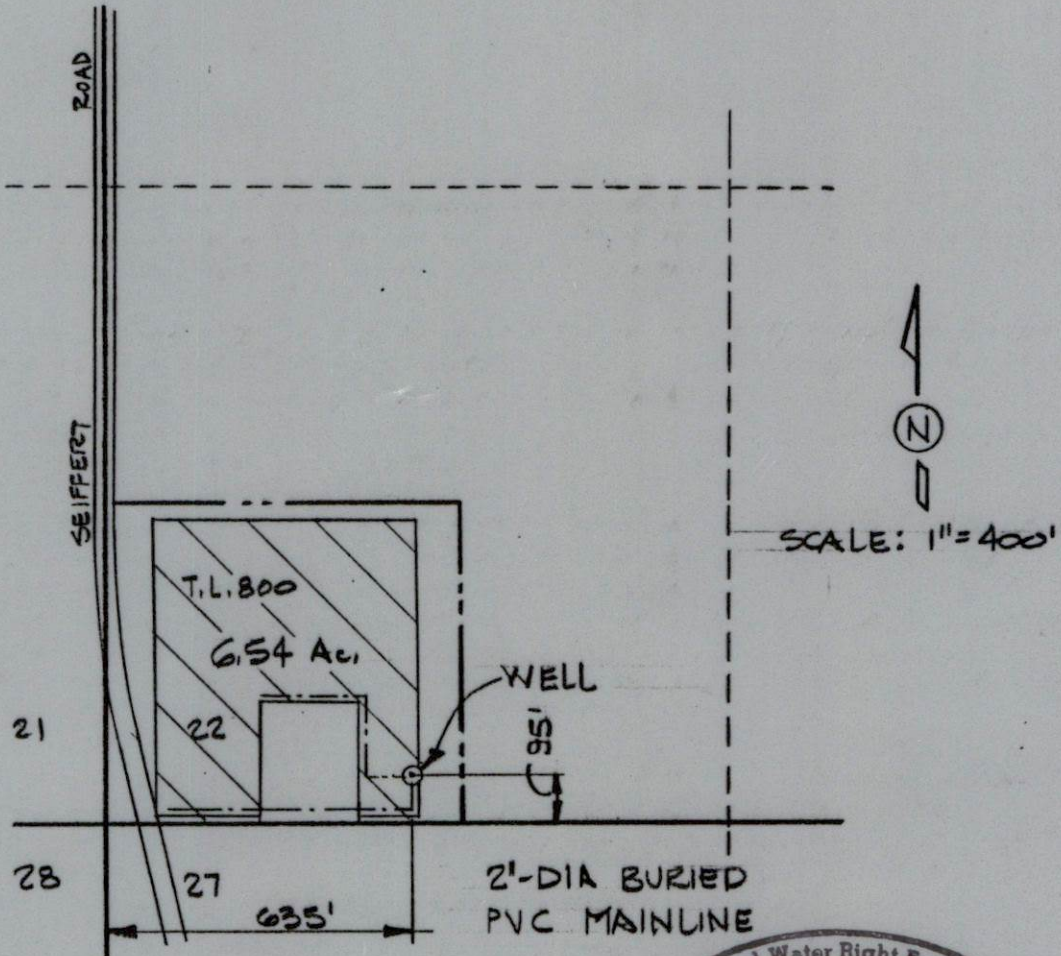

PREPARATION OF THIS MAP IS FOR THE PURPOSE OF IDENTIFYING THE LOCATION OF THE WATER RIGHT ONLY. THERE IS NO INTENT TO PROVIDE DIMENSIONS OR LOCATION OF PROPERTY OWNERSHIP LINES.

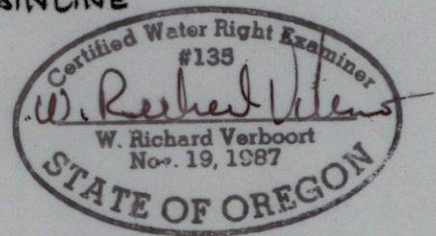

FINAL PROOF SURVEY
UNDER

APPLICATION G-12131 PERMIT G-11112
SURVEYED AUGUST 20, 1994

RECEIVED

SEP - 9 1994

WATER RESOURCES DEPT.
SALEM, OREGON

VERBOORT ENGINEERING
AGRICULTURE • CIVIL • WATER RESOURCES
HILLSBORO, OREGON

by date
designed WRV 8.94
drawn JER 8.94
checked WRV 8.94
drawing no. 94-A-03
sheet no. 1/1

MICHAEL C. & LAURA A. KAISER
19960 S.W. SEIFFERT RD
SHERWOOD, OR 97140