



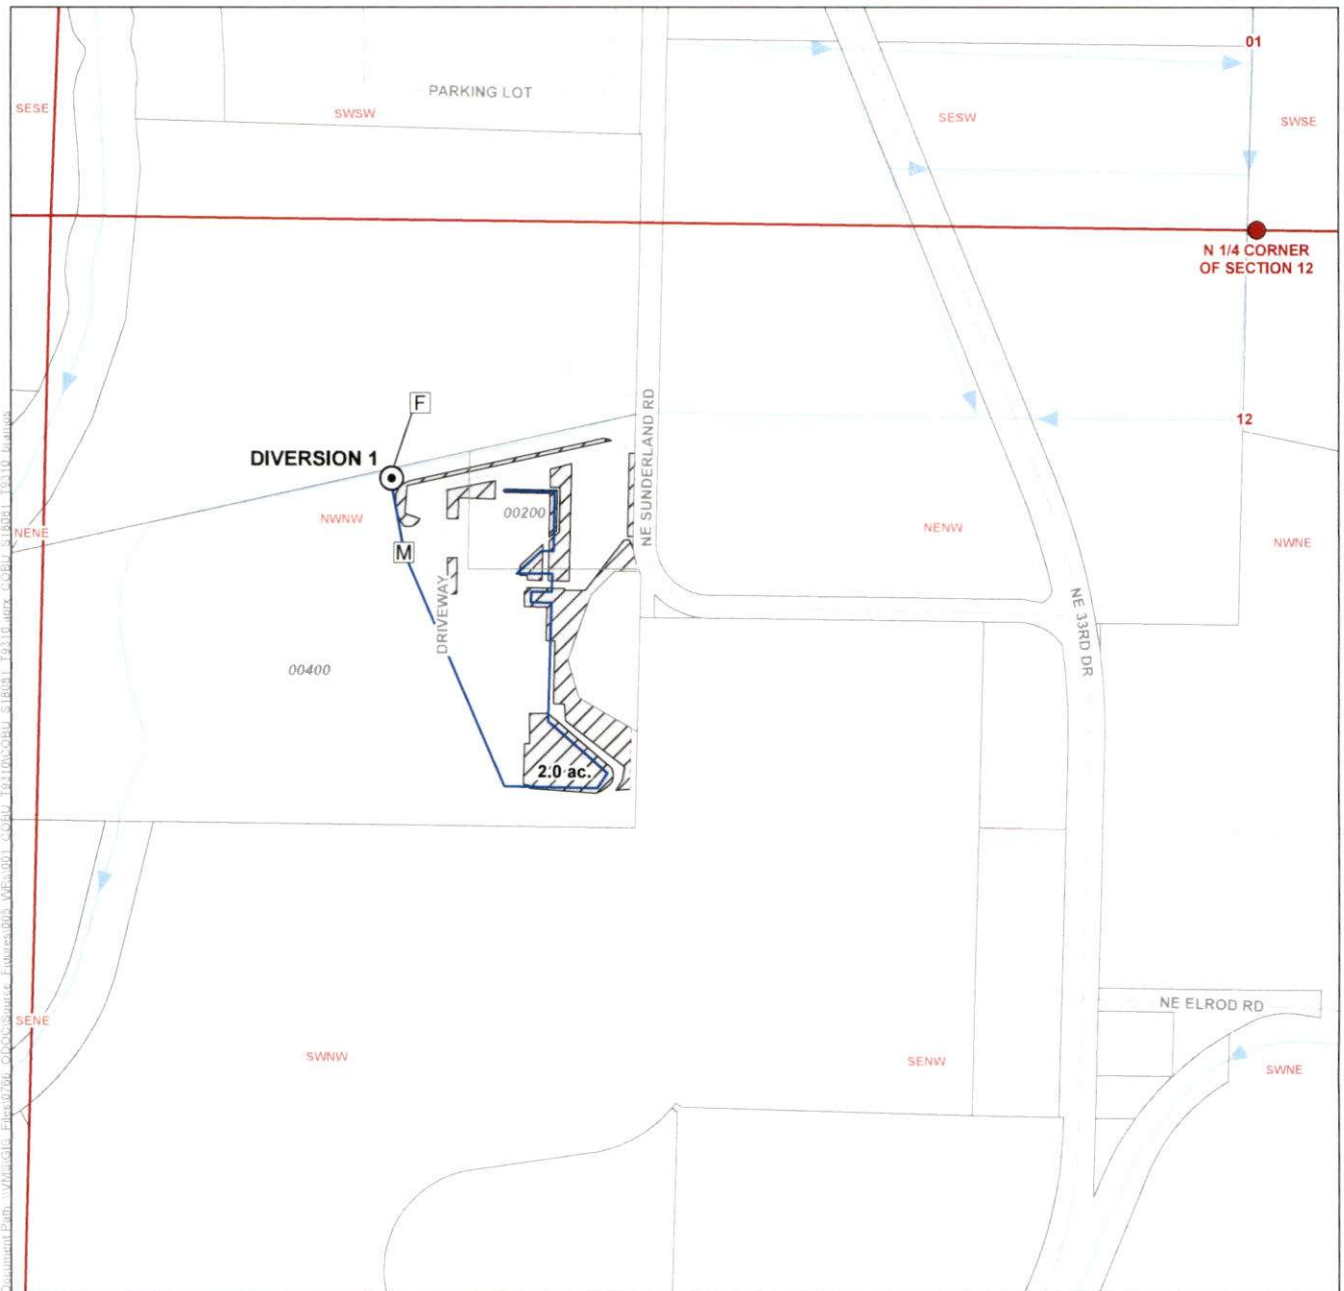

LEGEND

- | | |
|---|--|
| <ul style="list-style-type: none"> ⊙ Authorized Point of Diversion (POD) [F] Fish Screen [M] Meter — Conveyance Line ▨ Authorized Place of Use, 2.0 ac. Irrigation | All Other Features <ul style="list-style-type: none"> □ Tax Lot — Major Road ~ Watercourse ▶ Flow Direction |
|---|--|

CERTIFIED WATER RIGHTS EXAMINER STAMP

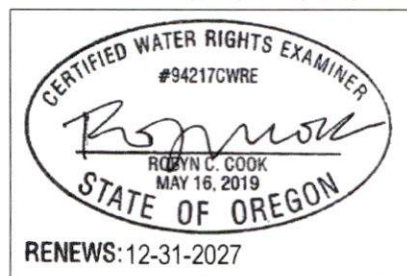

LOCATION DESCRIPTION

Point of Diversion
 Located 540 feet South and 1,895 feet West from the N 1/4 corner of Section 12, Township 1 North, Range 1 East (W.M.)
 X: 45.59010, Y: -122.63794 (WGS84)

Claim of Beneficial Use Map Oregon Department of Corrections Transfer T-9310 Multnomah County Township 1 North, Range 1 East (W.M.)

Received
 AUG 17 2026
 OWRD

DISCLAIMER
 This map was prepared for the purpose of identifying the location of a water right only and it is not intended to provide legal dimensions or location of property ownership lines.

Date: August 3, 2026
 Data Sources: BLM, ESRI, OWRD, USGS

