


Received

AUG 20 2026

OWRD

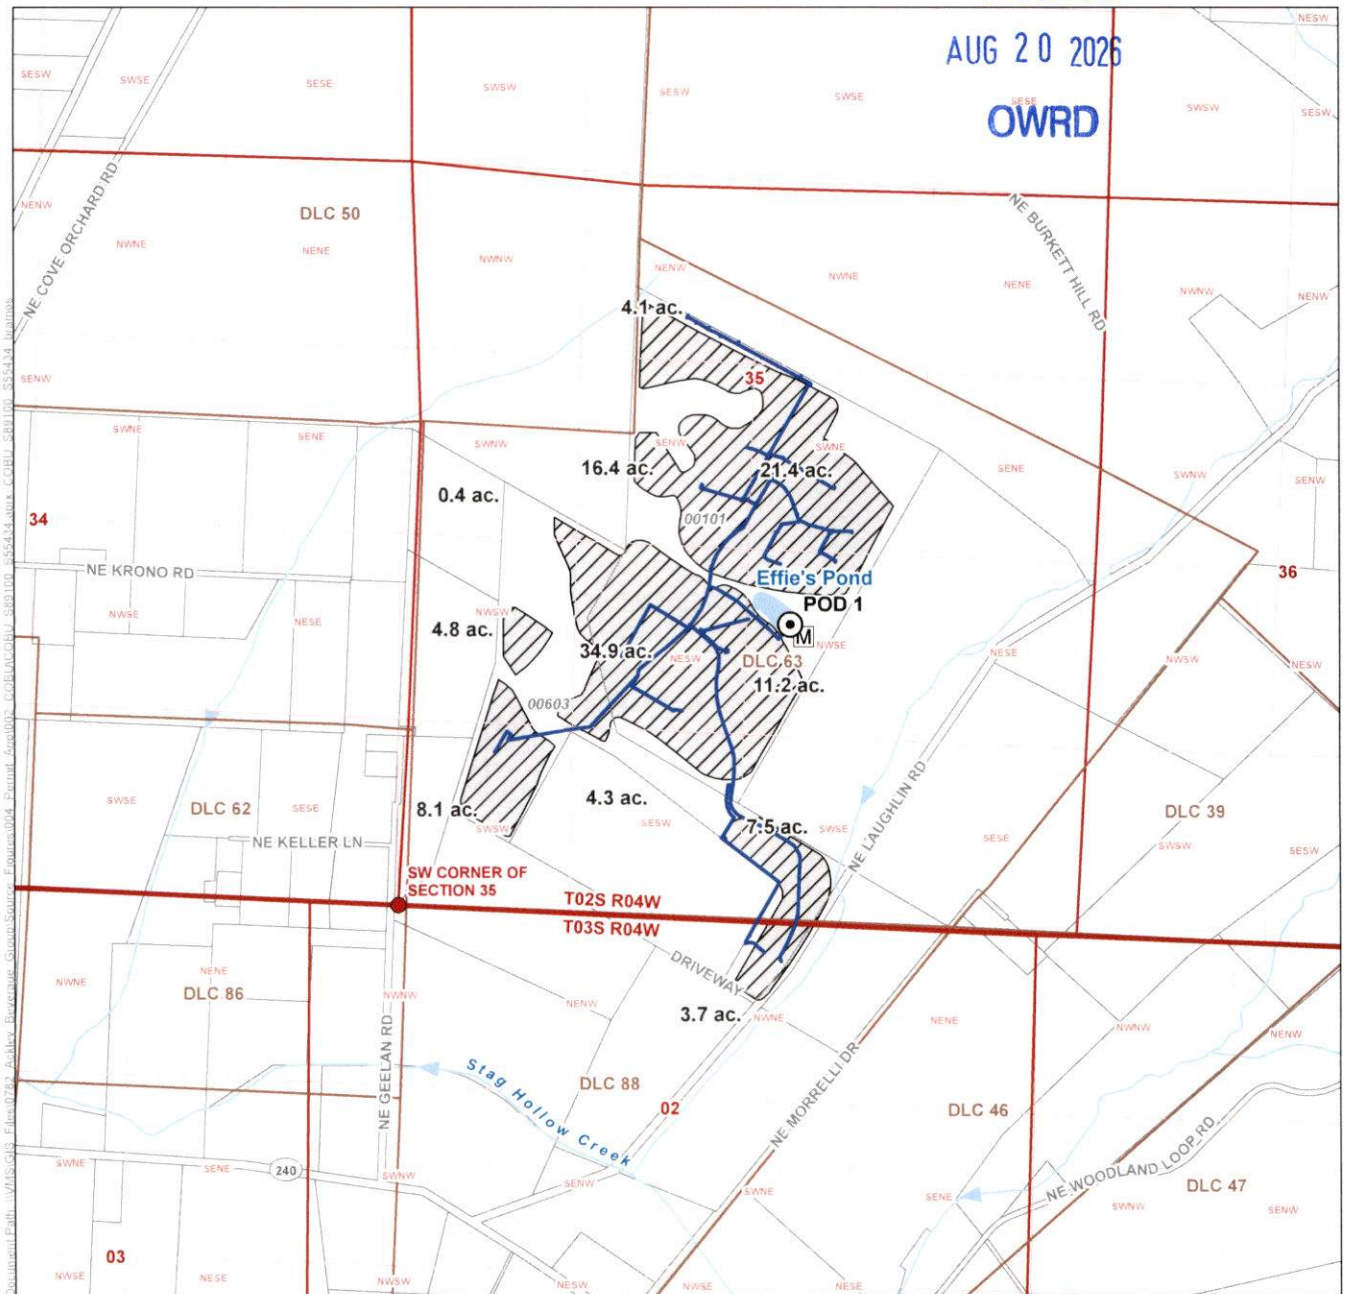

LEGEND

- Authorized Point of Diversion (POD)
- Meter
- Authorized Place of Use, 116.8 acres
Supplemental Irrigation
- Water Line


All Other Features

- Tax Lot
- Donation Land Survey (DLC)
- Flow Direction
- Watercourse
- Waterbody

Claim of Beneficial Use Map ABG Oregon Vineyards, LLC Application S-89100; Permit S-55434

Yamhill County

CERTIFIED WATER RIGHTS EXAMINER STAMP

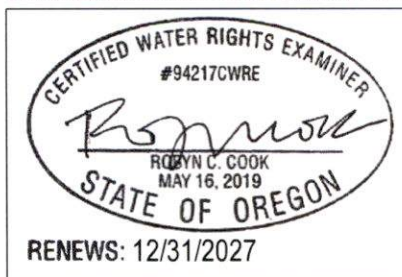

LOCATION DESCRIPTION

POD 1: Located 2,160 feet North and 2,190 feet East from the SW corner of Section 35, Township 2 South, Range 4 West (W.M.)
X: 45.35229, Y: -123.14342 (WGS84)

NOTE

Permit S-55434 authorizes supplemental irrigation of 116.8 acres. The underlying primary right is Permit G-18532, which authorizes irrigation of the same acres.

DISCLAIMER
This map was prepared for the purpose of identifying the location of a water right only and it is not intended to provide legal dimensions or location of property ownership lines.

Date: July 28, 2026
Data Sources: BLM, ESRI, OWRD, USGS

