


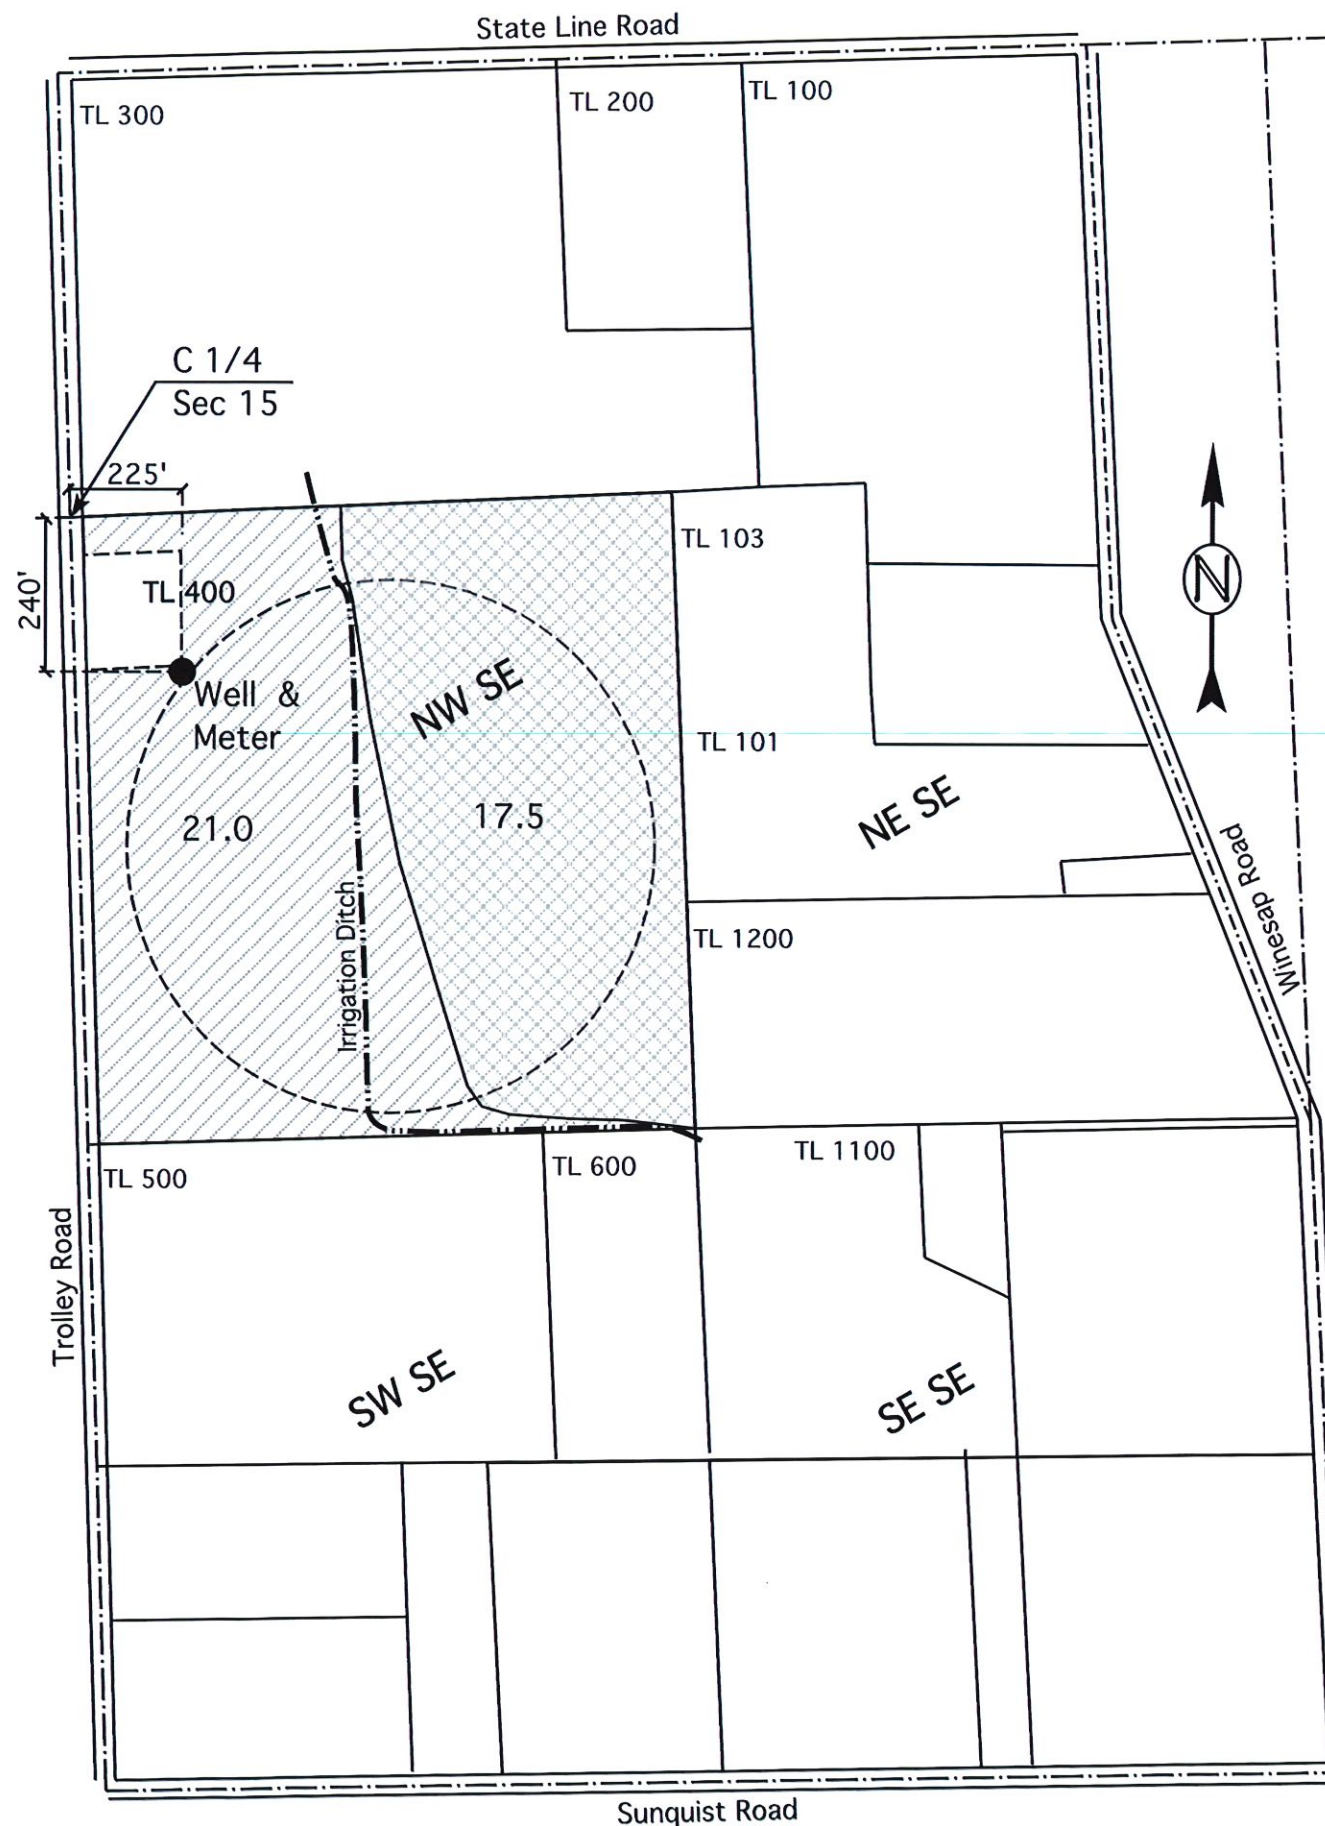


Township 6 North, Range 35 East, W.M. Umatilla County, Oregon Section 15

Well, UMAT 54970, Well ID L-65803 , NW1/4 of SE1/4, Sec. 15
Located 240' S & 225' E of C 1/4 Corner Section 15
Lat. 45°59'51.22518" N & Lon. 118°25'23.23628" W
Meter Located 3.5 Ft. East in 4" Steel Mainline From Well

Domestic Use for Permit G-15188
Found @ This Location

 Irrigation for Permit G-15188
Found @ This Location

 Supplemental Irrigation for Permit G-15188
Found @ This Location

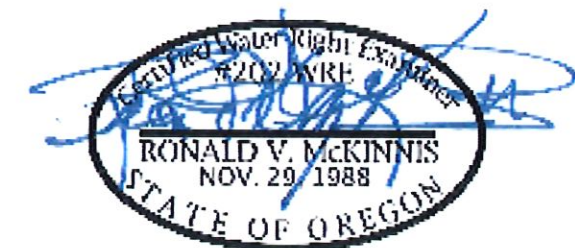

Expires 12-31-26

SCALE 1" = 400 Ft.

Received
AUG 24 2026

FINAL PROOF MAP

In Name Of

LONNIE & BARBARA ROBINSON

OWRD

This Map is for the purpose
of identifying the location of
Water Rights only and is not
intended to provide the legal
dimensions or locations of
property ownership lines.

Rev. 05-22-26

