


T. 3 S., R. 3 E., W. 4 M.

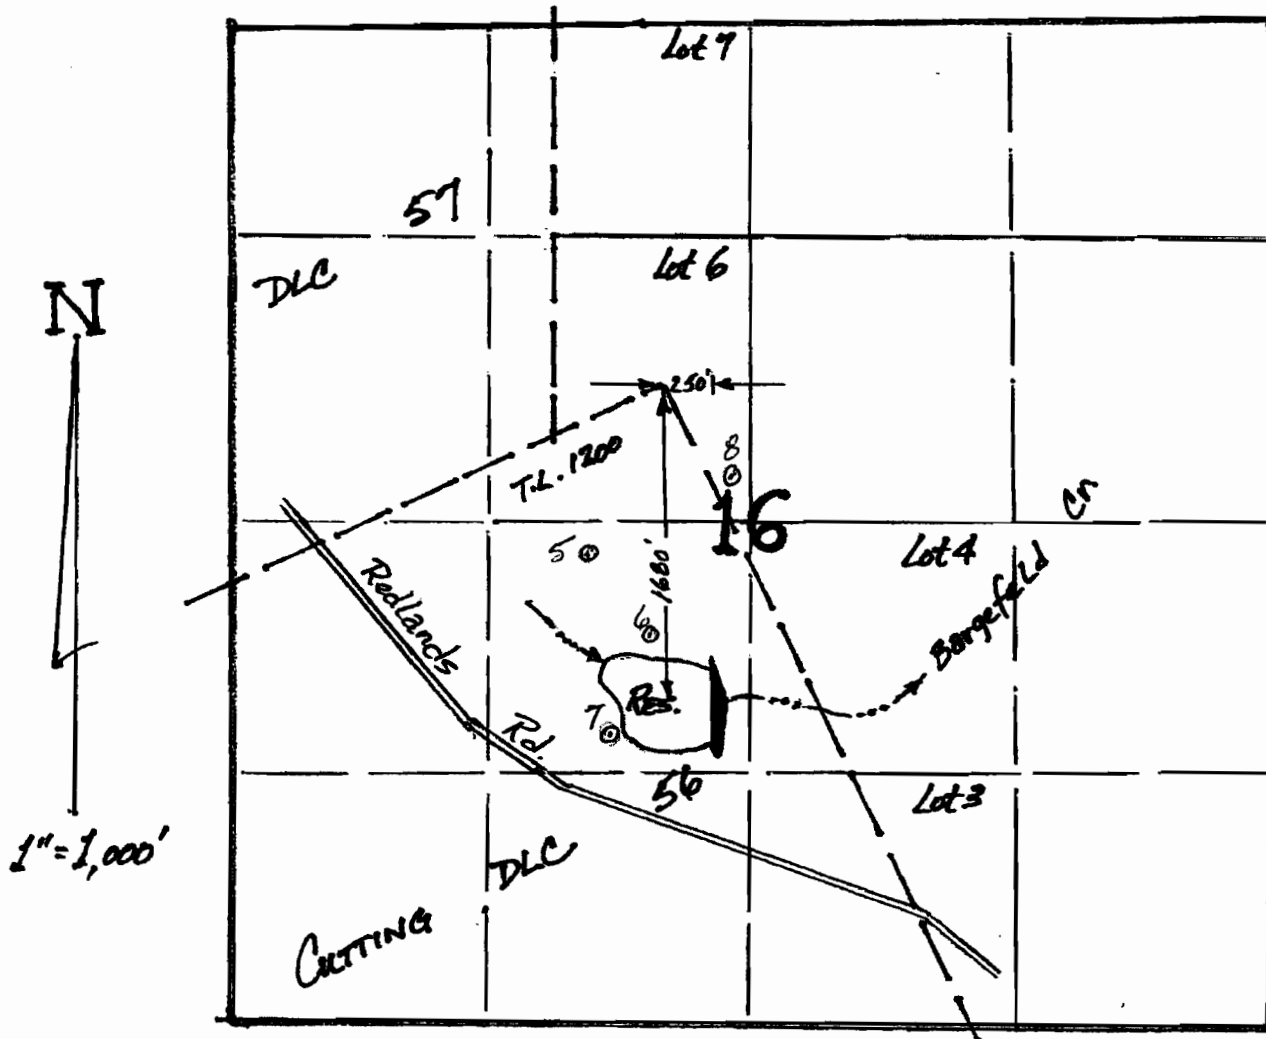

MAP TO ACCOMPANY APPLICATION for

Well Locations:

- ⑤ 880' S. & 400' W.
- ⑥ 1330' S. & 70' W.
- ⑦ 1820' S. & 310' W.
- ⑧ 430' S. & 360' E.

-all from NE Cor.
Cutting DLC 56

PETER Q. REYES REVOKABLE LIVING TRUST
& J. MAUREEN REYES TRUST

RECEIVED
JUN 29 2007
WATER RESOURCES DEPT
SALEM, OREGON