


T.7S. R.4W. W.M.

POLK COUNTY, OREGON

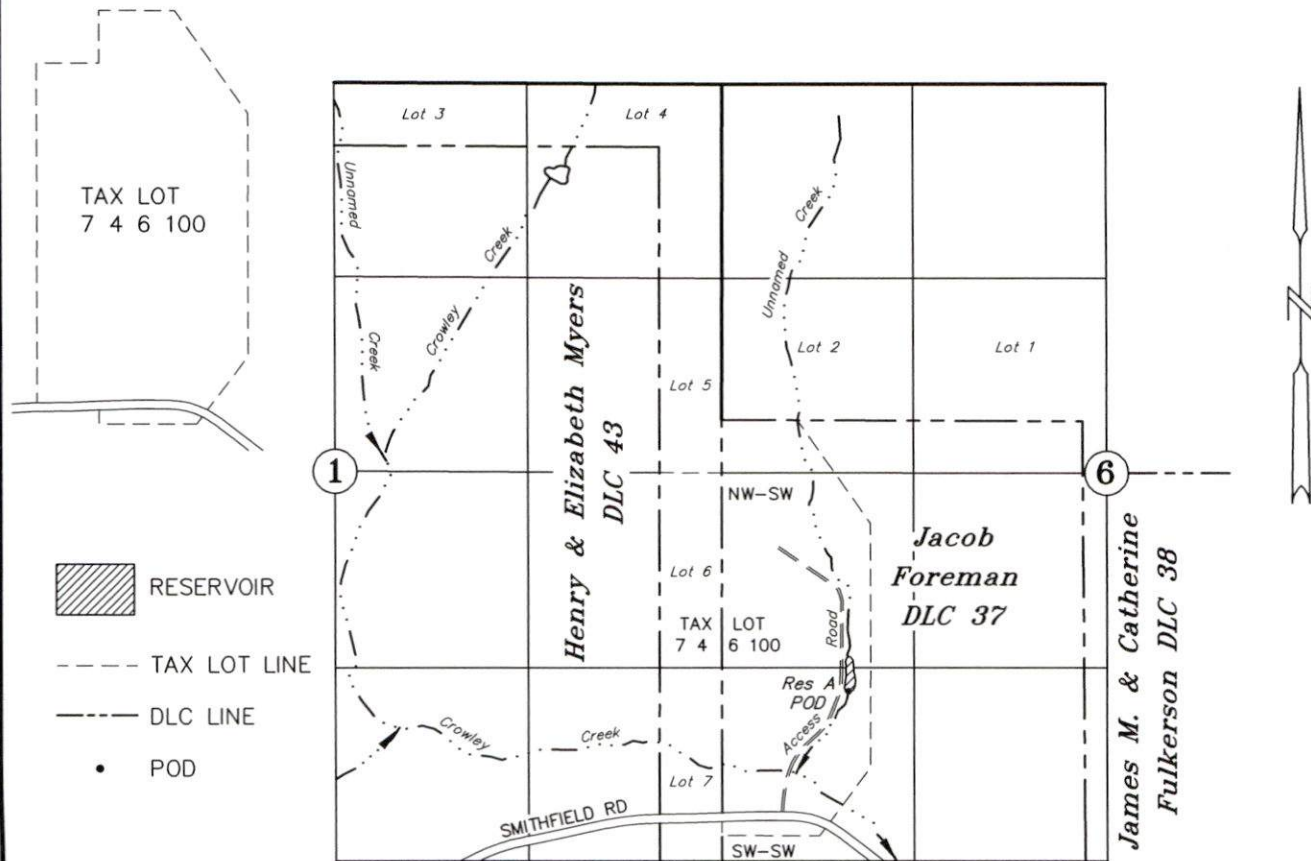

RESERVOIR A POD: 1495' SOUTH AND 855' EAST OF THE W 1/4-COR, SECTION 6
44.987746°, -123.231659°, GOOGLE EARTH dated 06-18-2024, WGS84 DATUM

APPROVED MEASURE POINT: TRICKLE TUBE

CLAIM OF BENEFICIAL USE UNDER

Application No. R-72623 Permit No. R-11489

MAGEE OHANA, LLC

October 22, 2025

SCALE: 1" = 1320'

NOTE: This map is for the purpose of identifying the location of water rights and has no intent to dimension or locate property ownership lines.

Received by OWRD

AUG 26 2026

Salem, OR



Renewal Date: 12-31-2027