



T10S R21E, WM WHEELER COUNTY, OR

Received
AUG 27 2026
OWRD

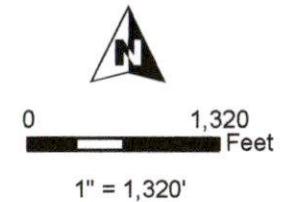

POD #3 Location:
200' S, 1020' W of NE Cor Sec 2, T10S, R21E, W.M.
Lat: 44.737453 Lon: -120.167402 WGS1984

- POD #3 - Pump, Meter, & Fish Screen
- Pipeline
- John Day River
- Township
- Section
- Quarter Quarter
- Tax Lot
- ▨ 10.9 ac. POU IR 8/27/1979 Priority

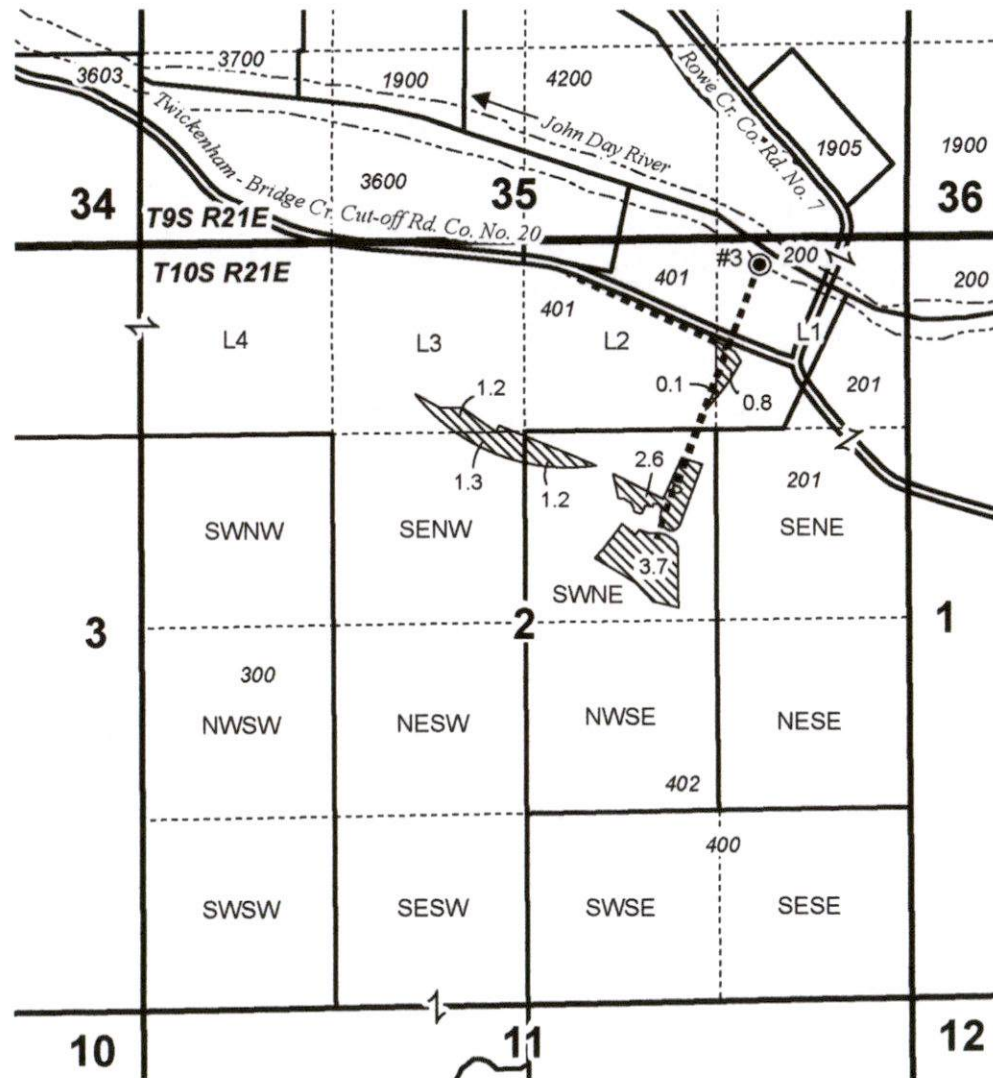

CLAIM OF BENEFICIAL USE MAP 1 OF 2 - CONTENTION RANCH
CONTENTION RANCH, LLC

Date: 8/13/2026

T-14316

This map is not intended
to provide legal dimensions
or locations of property
ownership lines.

WATER RIGHT SERVICES, LLC
PO BOX 1830, BEND, OR 97709
WWW.OREGONWATER.US Bryce Withers
info@oregonwater.us 541-389-2837

**T10S R21E &
T10S R22E, WM
WHEELER COUNTY, OR**

POD #2- Location:
1080' S, 530' W of NE Cor Sec 1
Lat: 44.735046 Lon: -120.146321 WGS1984



0 1,320
Feet

1" = 1,320'

Received

APR 27 2026

OWRD

● POD #2 - Pump, Meter, Fish Screen

----- John Day River

—— Township


—— Section

----- Quarter Quarter

□ Tax Lot

▨ 9.1 ac. POU IR 8/27/1979 Priority

▩ 17.1 ac. POU IR 11/23/1982 Priority

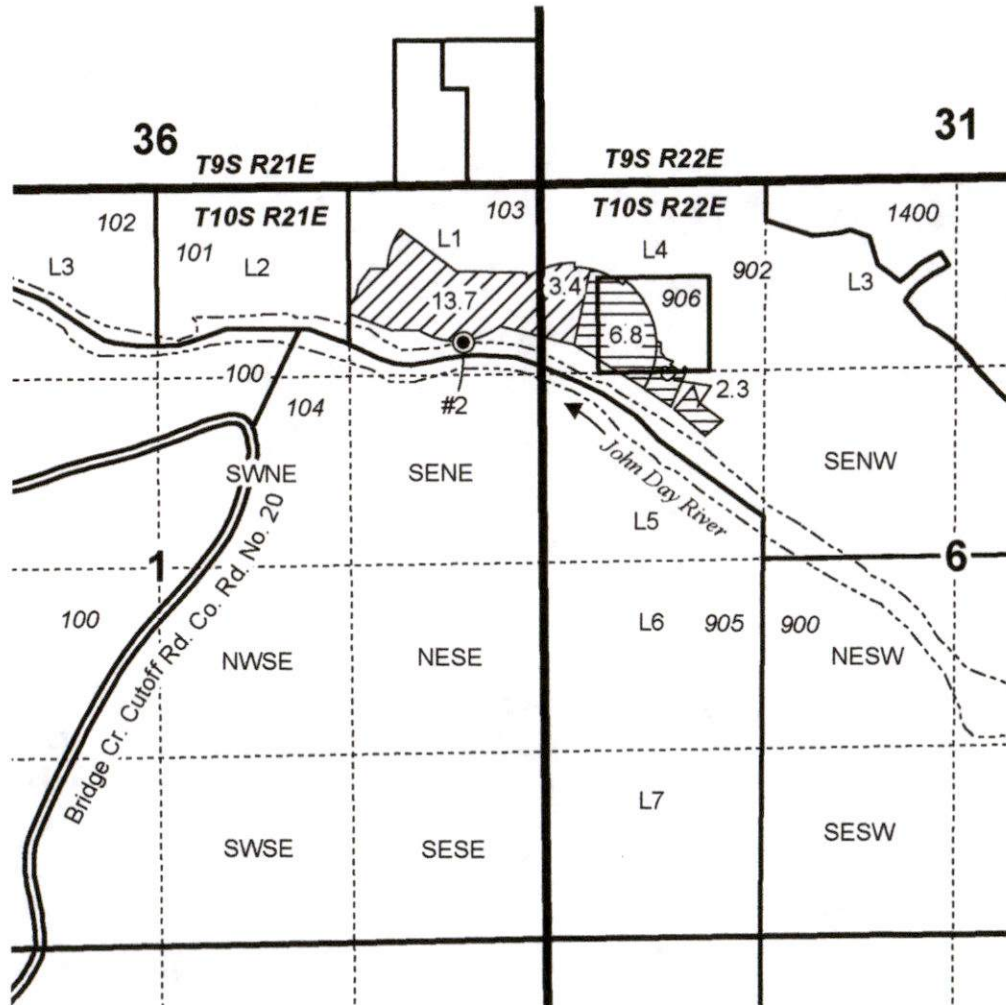

RENEWS: 06/30/2028



**CLAIM OF BENEFICIAL USE MAP 2 OF 2 - GOOSE POINT
CONTENTION RANCH, LLC**

Date: 8/13/2026

T-14316

This map is not intended
to provide legal dimensions
or locations of property
ownership lines.

WATER RIGHT SERVICES, LLC

PO BOX 1830, BEND, OR 97709

WWW.OREGONWATER.US Bryce Withers

info@oregonwater.us 541-389-2837