

CLAIM OF BENEFICIAL
USE MAP

FOR

J.V. MOON & SON

SECTIONS 20 & 29

T27S R29E W.M.


HARNEY COUNTY, OREGON

LEGEND

- SECTION LINE
- 1/4 SECTION LINE
- 1/16 SECTION LINE
- WATER WAYS/DITCHES
- FLOW DIRECTIONS

APPLICATION NO. S-77041

PERMIT NO. S-52846

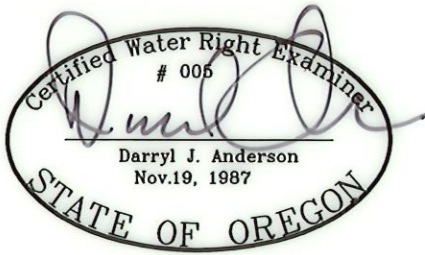


RENEWAL 12/31/27



SCALE: 1"=1320'

NOTE:
THIS MAP IS NOT INTENDED TO PROVIDE LEGAL
DIMENSIONS OR LOCATIONS OF PROPERTY
OWNERSHIP LINES

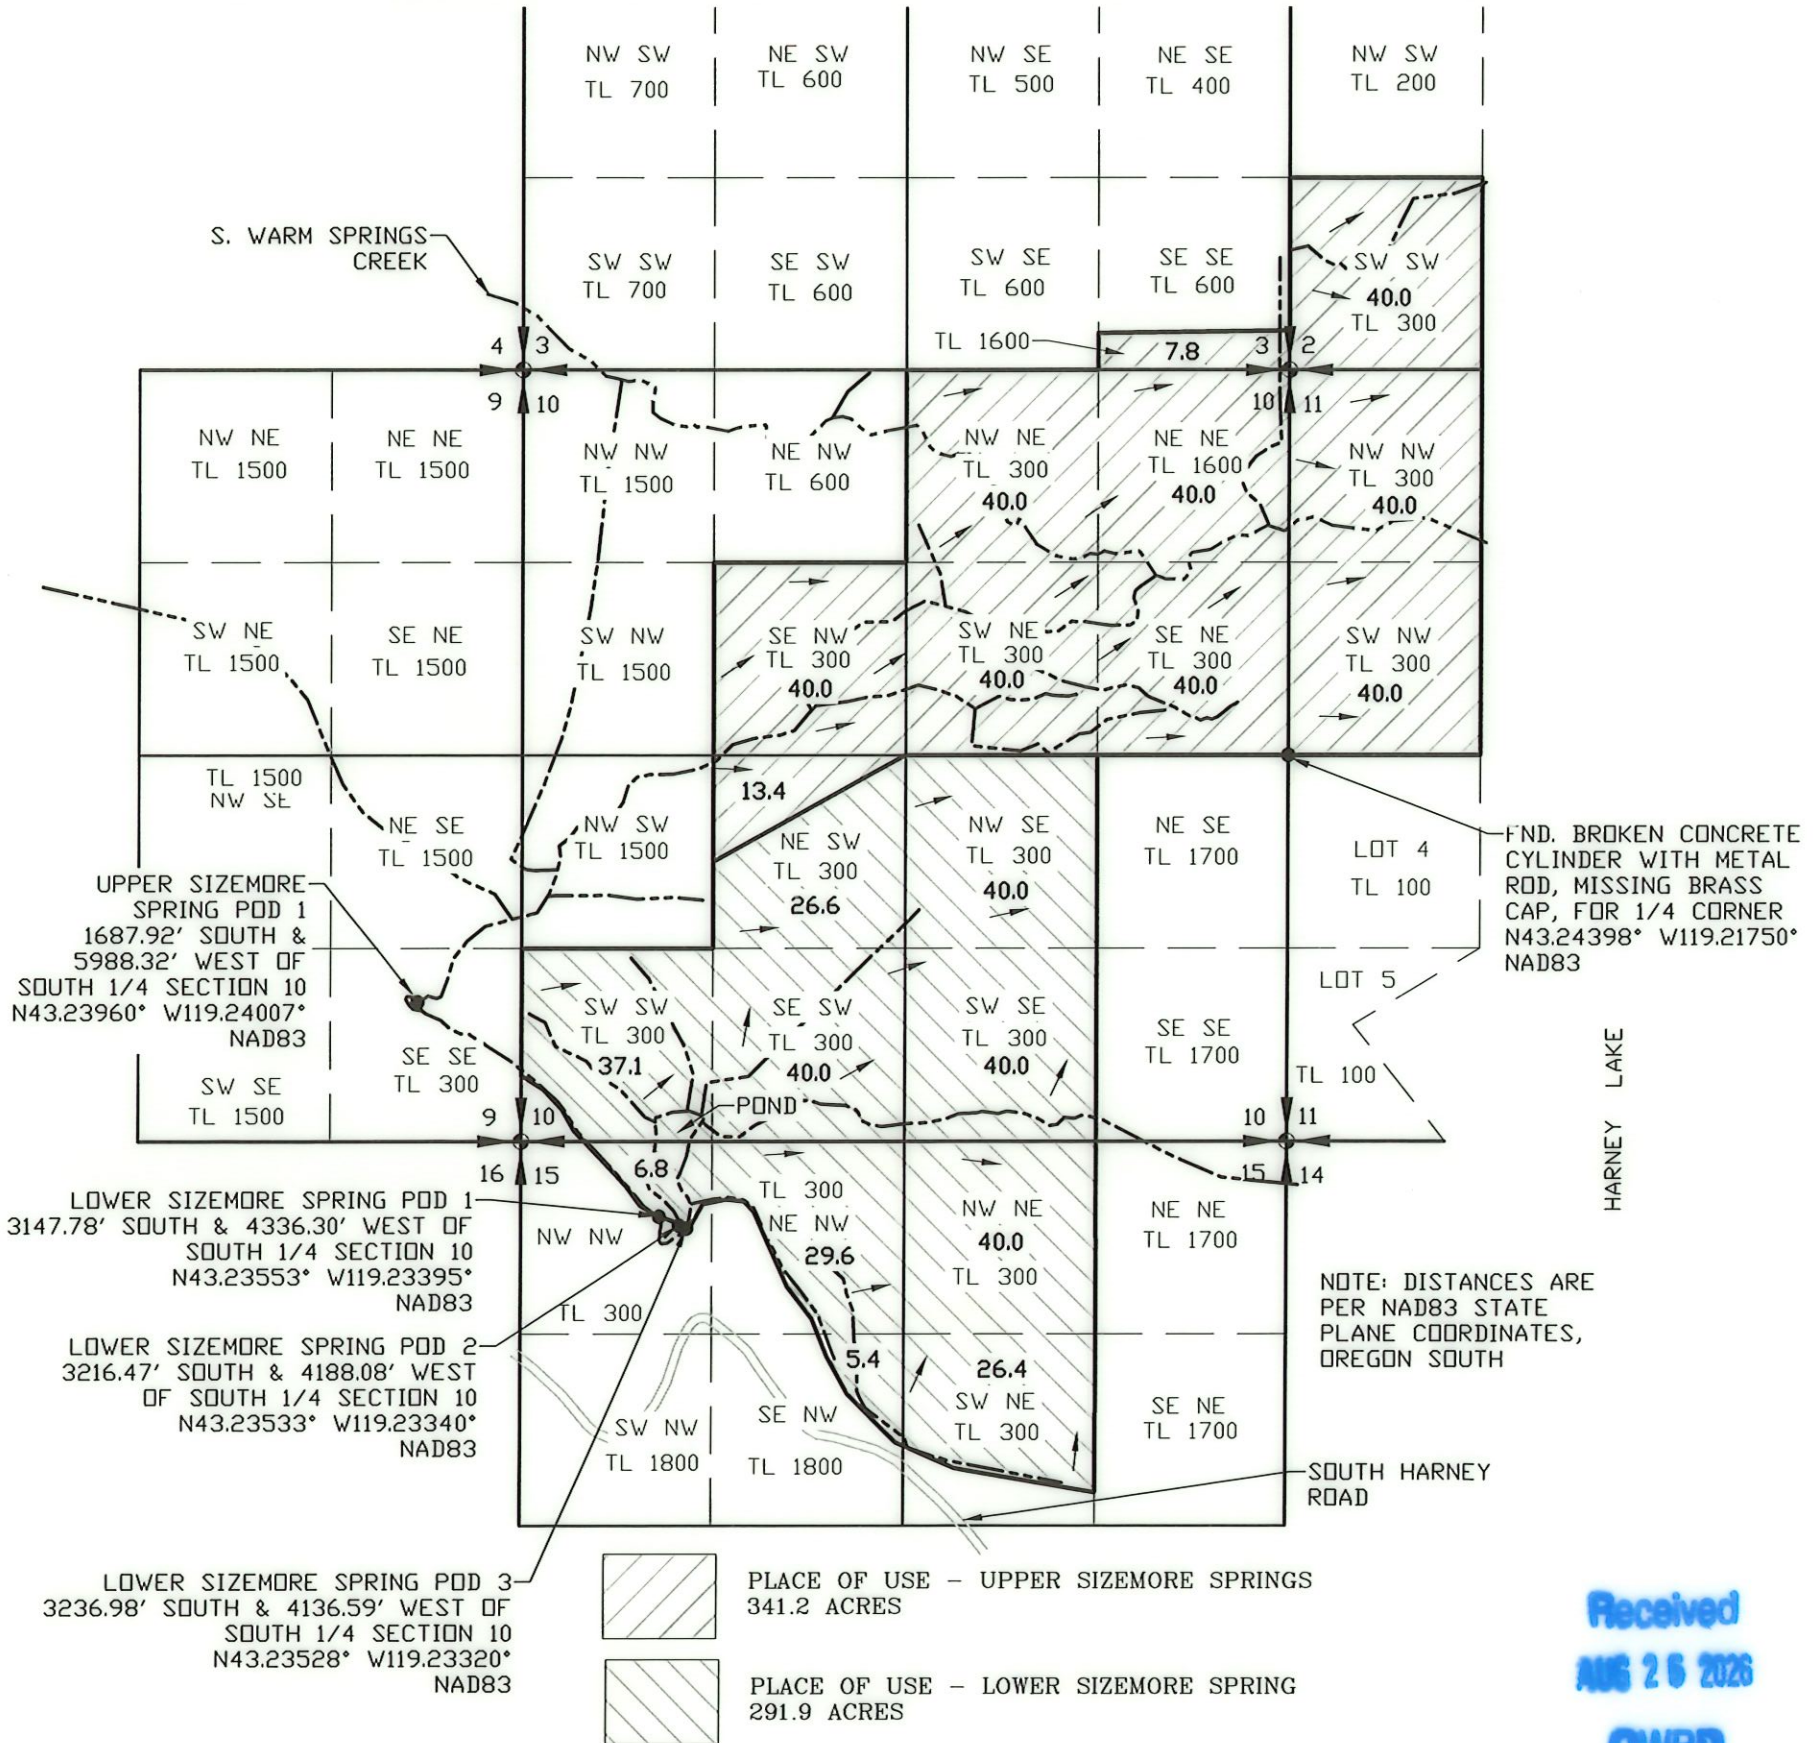

Received
AUG 26 2026
OWRD

REVISION	BY

P.O. BOX 28
LAKEVIEW, OR. 97630
WWW.SHN-ENGR.COM
541-947-4407

FOR:
GEREN MOON
P.O. BOX 45
PAISLEY, OR 97636
(541) 589-1136

CLAIM OF BENEFICIAL USE MAP
PERMIT S-52846
HARNEY COUNTY, OREGON

DATE:	8/18/2026
SCALE:	1"=1320'
DWG. BY:	R.C.
JOB:	226045
FILE:	226045-WR
SHEET:	1