

CLAIM OF BENEFICIAL USE MAP


TO ADD A POINT OF APPROPRIATION
FOR APPLICATION T-10103

SOUTHWEST 1/4 OF SECTION 34,
TOWNSHIP 27 SOUTH, RANGE 16 EAST, W.M.
TAX LOT: 500

Received by OWRD

AUG 31 2026

Salem, OR

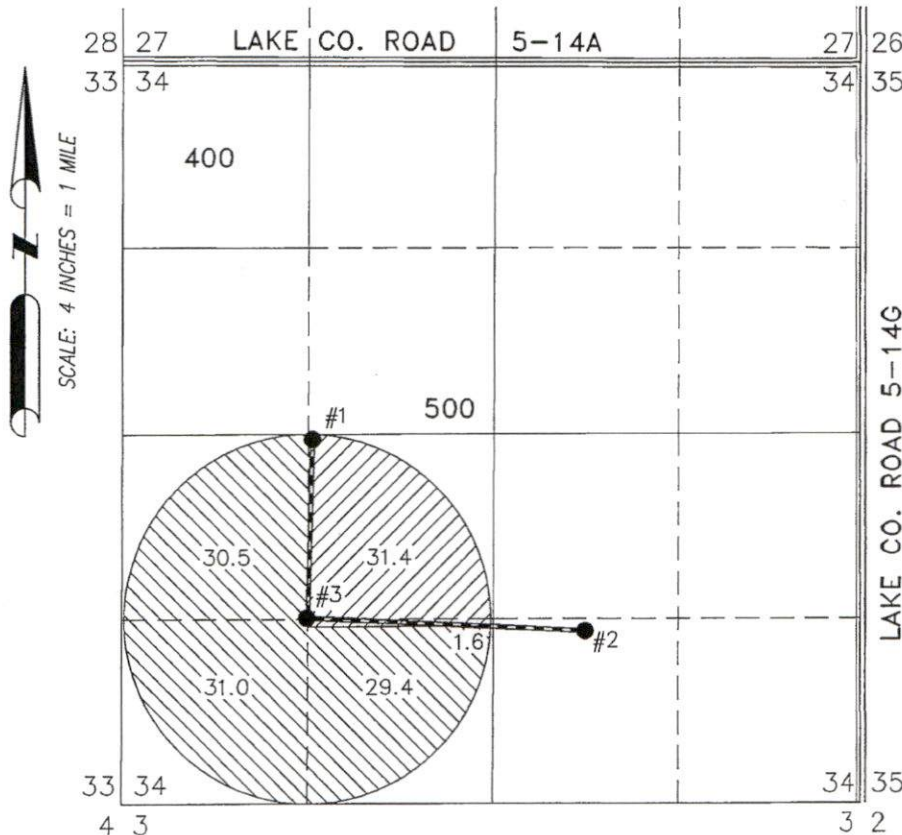

Scott D
Montgomery

Digitally signed by Scott D
Montgomery
DN: cn=Scott D Montgomery, o=All
Points Engineering and Surveying, Inc.,
ou, email=scott@apeands.com, c=US
Date: 2026.08.31 09:28:09 -0700

-  33.0 AC IR FROM C 75812
(TRANSFER T-10103)
-  90.9 AC IR FROM C 75733
(TRANSFER T-10103)

- POA 1 (LAKE 918) 43.18487° -120.81468°
LOCATED IN THE NE 1/4 SW 1/4 SECTION 34, T27S
R16E, W.M. AND 30 FEET SOUTH AND 1360 FEET EAST
FROM THE W 1/4 CORNER OF SECTION 34.
- POA 2 (LAKE 919/920) 43.18106° -120.80716°
LOCATED IN THE SW 1/4 SE 1/4 SECTION 34, T27S
R16E, W.M. AND 1230 FEET NORTH AND 2000 FEET
WEST FROM THE SE CORNER OF SECTION 34.
- POA 3 (LAKE 51815/51866) 43.18139° -120.81478°
LOCATED IN THE NE 1/4 SW 1/4 SECTION 34, T27S
R16E, W.M. AND 1325 FEET NORTH AND 1330 FEET
EAST FROM THE SW CORNER OF SECTION 34. FLOW
METER LOCATED 15 FEET WEST ON DELIVERY PIPE.



RENEWAL DATE: 12/31/2026

THIS MAP IS FOR THE PURPOSE OF LOCATING A
WATER RIGHT ONLY AND HAS NO INTENT TO
PROVIDE LEGAL DIMENSIONS OR THE LOCATION OF
PROPERTY LINES

PREPARED FOR:

ROTH & KENAGY, LLC
56146 ARROW GAP ROAD
SILVER LAKE, OR 97638

PREPARED BY:



ALL POINTS ENGINEERING AND SURVEYING, INC.
P.O. BOX 767 TERREBONNE, OR 97760
(541) 548-5833 www.APEandS.com