

T.5S. R.1E. Section 23, W.M.

15 14
22 23

Well 1 (CLAC 79379) is located 1,205 feet south and 1,075 feet east from the NW corner, Section 23. (45.125664, -122.656708, WGS 84)

 Area (12.0 Acres) irrigated under T-12784 formerly Certificate 52854, priority date: 6-7-1982.

----- Tax lot boundary

..... Water main line

NWNW

NENW

Dryland Rd.

Well 1
(CLAC 79379)

3.9

1.4

4.0

2.7


TL 5 1E 23 403

Rock Creek

SWNW

SENW

Garret Creek

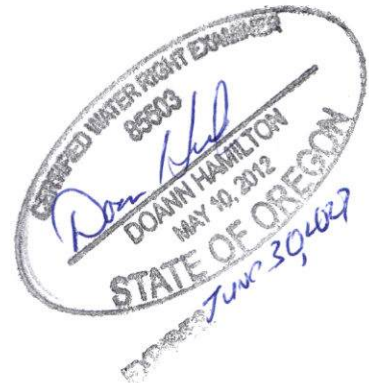


Received by OWRD

AUG 28 2026

Salem, OR

Scale: 1" = 400'

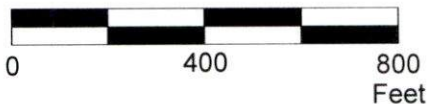

This map was prepared for the purpose of identifying the location of a water right only and is not intended to provide legal dimensions or location of property ownership lines.

Claim of Beneficial Use Map
T-12784 formerly Certificate 52854

Deborah Unrau
T.5S. R.1E. Section 23, W.M.

 WILL MCGILL SURVEYING LLC

08/2026