MAP

T. 32 S. R. 5 W. W. M.

Received
AUG 31 2026
OWRD

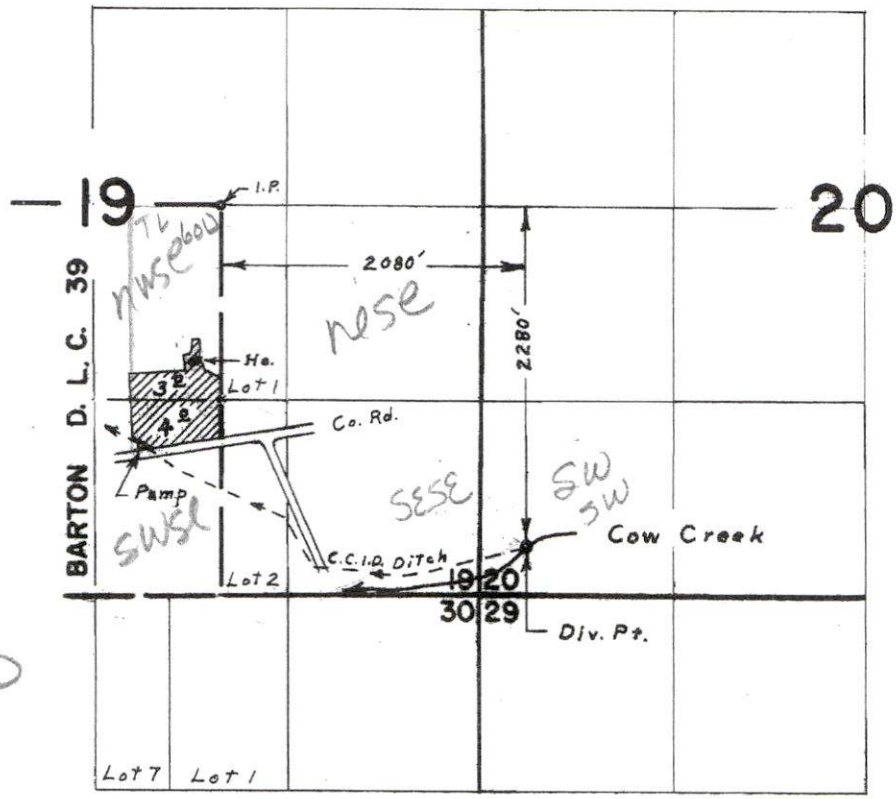

tax lot = 600

1" = 1320'

lat/long of pod = 42.77007 - 123.32642

— — = DLC lines

——— = Q/Q

--- = ditch

← = river flow

FINAL PROOF SURVEY
UNDER

Application No. 43720 Permit No. 32680
IN NAME OF

KARL C. PAYNE

Surveyed July 29, 1969, by L. E. Gould

1969 - V