

Received
SEP 02 2026
OWRD

GEORGIA MAYEA and
JULIE KELLEHER
93773 ELK RIVER RD
PORT ORFORD, OR 97465

TRANSFER 14044
CERTIFICATE 26303

SITUATED IN
SECTIONS 26 & 27, TOWNSHIP
32S RANGE 15W, W.M.


CURRY COUNTY, OREGON

LEGEND

- PODs AND METERS
- 1 - 1670' N 1805' W OF SE CORNER S27
42.77180 -124.46071 WGS84
 - 2 - 745' N 1160' W OF SE CORNER S27
42.76924 -124.45834 WGS84
 - 3 - 885' N 1155' E OF SW CORNER S26
42.77000 -124.45056 WGS84
 - 4 - 773' N 1087' E OF SW CORNER S26
42.76974 -124.45000 WGS84
 - 5 - 635' N 1170' W OF SE CORNER S27
42.76924 -124.45834 WGS84

- T-14044 POU
- POD 1 - 19.2 ACS NW SE S27
 - POD 2 - 10.4 ACS NE SE S27
 - POD 5 - 5.6 ACS SE SE S27
0.4 ACS NE NE S34
 - C-97587 (C-26303 RR) POU
PODs 1, 2, 3, 4 - 65.1 ACS

— - PIPELINES

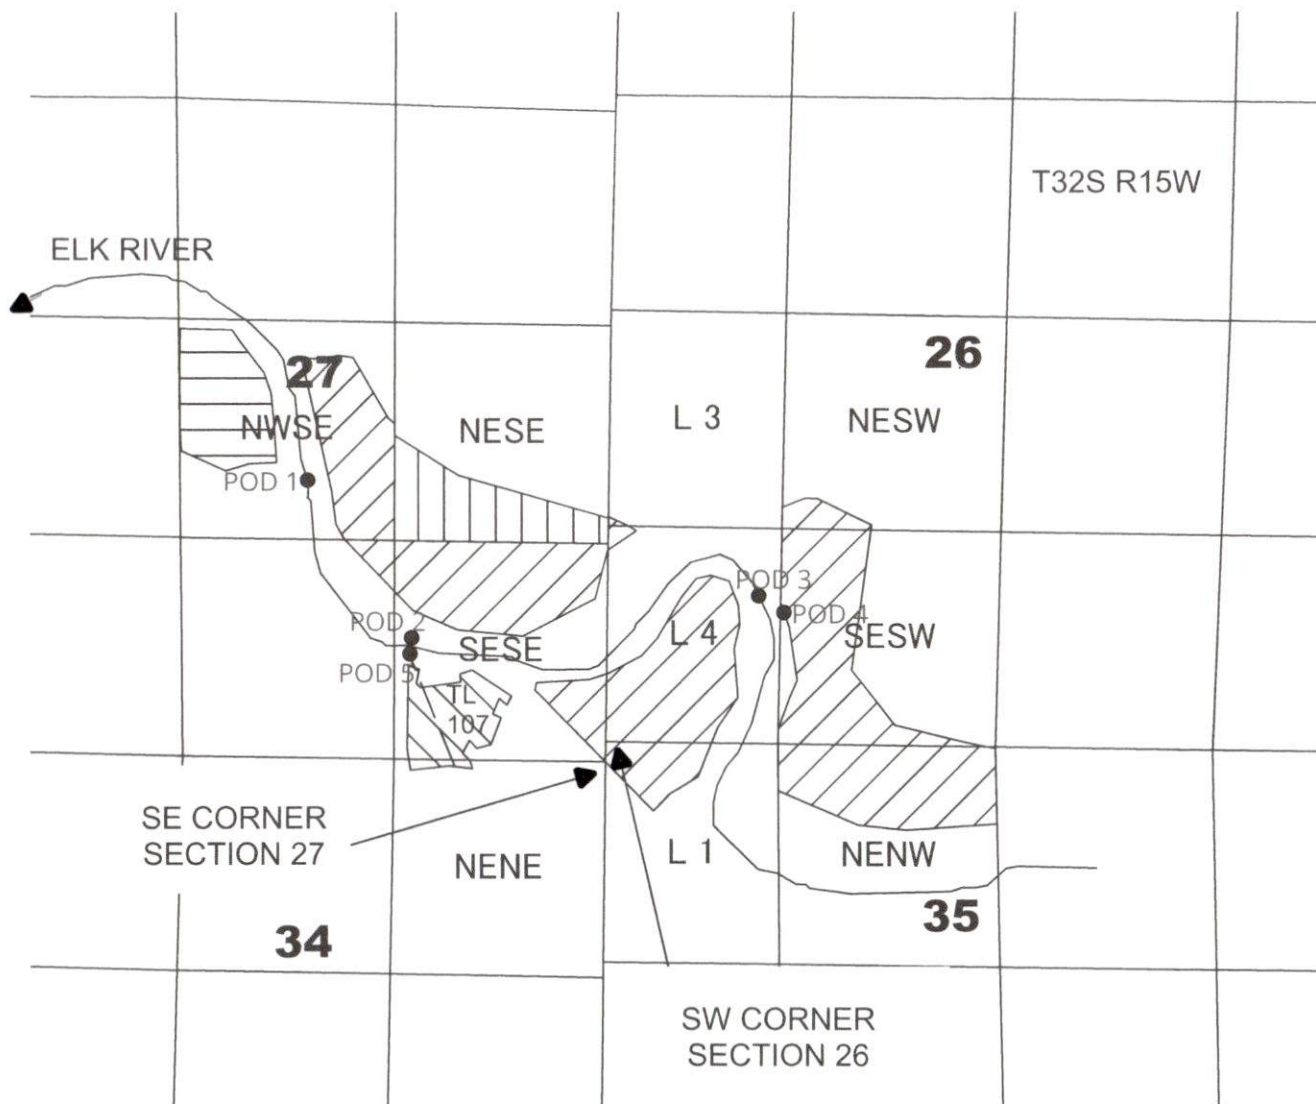

0 1320 ft

This map is not intended to provide
legal dimensions or locations of
property ownership lines

ParsonsWater Consulting LLC
rick.parsons@parsonwater.com
541.499.0257 303.667.5067