


- Well 1 & Meter
- Pipeline
-  Place of Use - Irrigation
-  Township
-  Section
- Quarter Quarter
-  Tax Lot

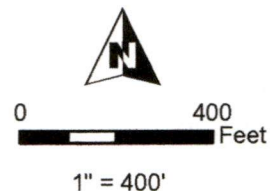


T15S R12E, WM DESCHUTES COUNTY, OR



Received
AUG 31 2026

OWRD

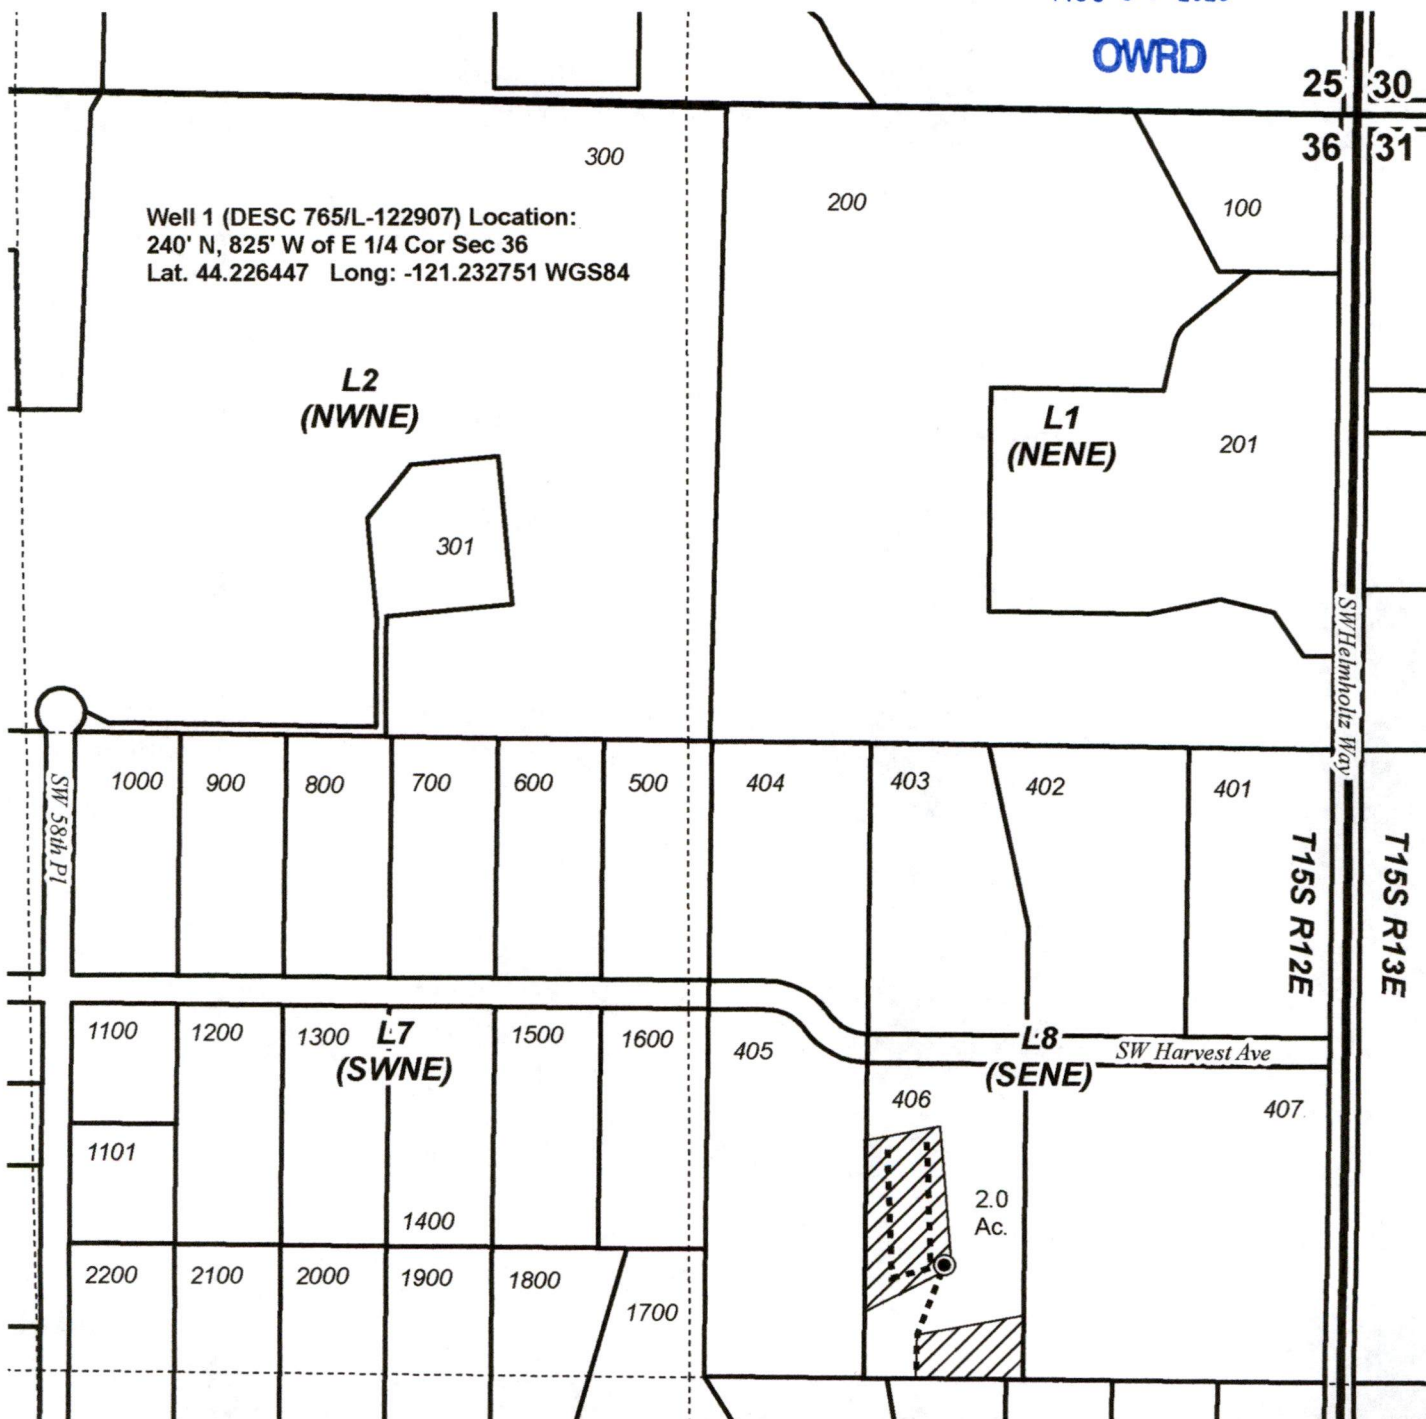

CLAIM OF BENEFICIAL USE MAP
Parrish

Date: 8/13/2026

Ap G-18618 Permit G-18891

This map is not intended
to provide legal dimensions
or locations of property
ownership lines.

WATER RIGHT SERVICES, LLC

PO BOX 1830, BEND, OR 97709

WWW.OREGONWATER.US

info@oregonwater.us 541-389-2837