
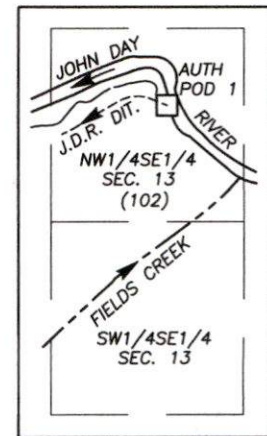
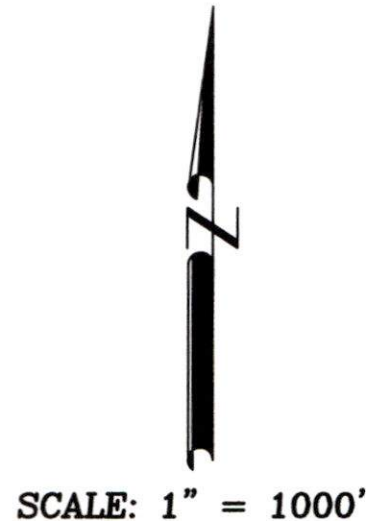


T.13S., R.28E., W.M., GRANT COUNTY, OREGON
CLAIM OF BENEFICIAL USE MAP UNDER TRANSFER T-10563
FOR
WAYNE CASEY OVERTON

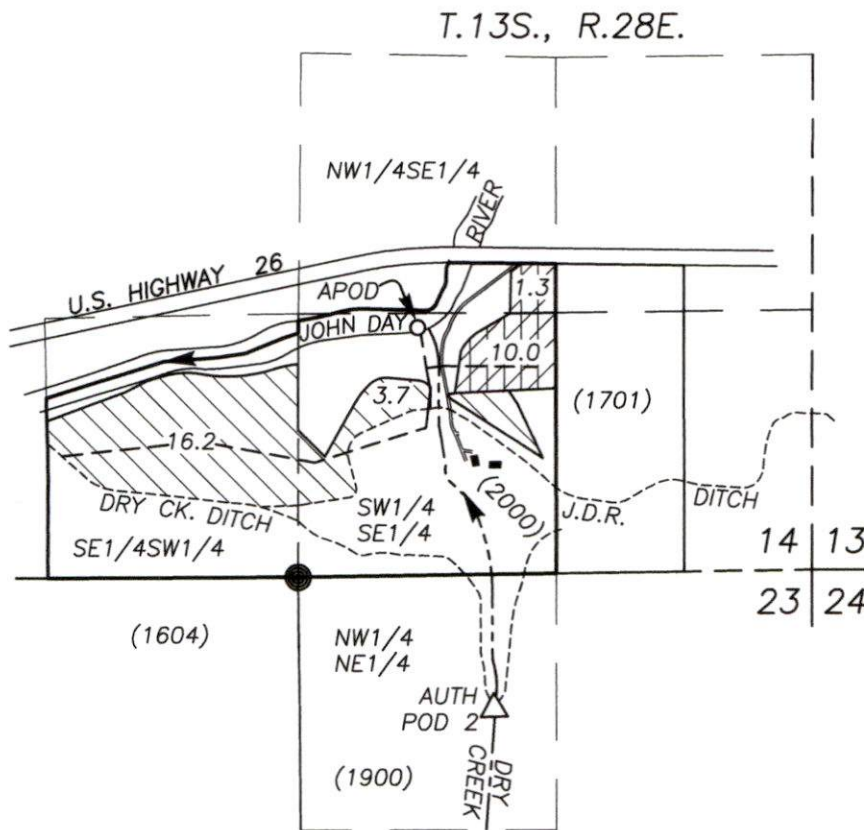

SCALE: 1" = 1000'

□ AUTHORIZED POD 1: IS IN THE NW1/4SE1/4, SECTION 13

△ AUTHORIZED POD 2: IS IN THE NW1/4NE1/4, SECTION 23

APOD: PUMP WITH FISH SCREEN: 1290 FT. NORTH & 615 FT. EAST FROM THE S1/4 CORNER SECTION 14, T.13S., R.28E. FLOW METER BEARS S.35°E, 20 FT FROM APOD

APOD: WGS84 COORDINATES: 44.43598 N. & 119.31456 W.

PLACE OF USE & PRIORITY DATE:

- SUPPLEMENTAL: 11.3 AC., 1865 - FIELDS CREEK
- PRIMARY: 19.9 AC., MARCH 13, 1963 - JOHN DAY RIVER
- PRIMARY: 11.3 AC., 1865 - JOHN DAY RIVER

----- BURIED 6" & 4" MAINLINE WITH RISERS


() TAX LOT NO.

● FOUND MONUMENT AT THE S1/4 CORNER SECTION 14, T.13S., R.28E.

DISCLAIMER: THIS MAP IS NOT INTENDED TO PROVIDE LEGAL DIMENSIONS OR LOCATIONS OF PROPERTY OWNERSHIP LINES.

Received
 SEP 04 2026
 OWRD

PREPARED BY:
 ROBERT D. BAGETT, PLS, CWRE
 217 N. CANYON BLVD.
 JOHN DAY, OREGON
 (541) 575-1251
 MAY 19, 2026

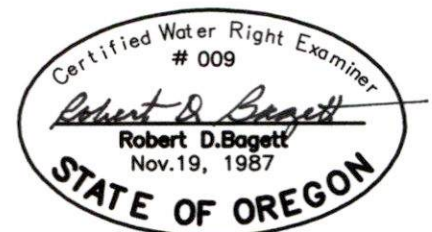

RENEWS 12/31/2027